LAUNDON . SIMON . CAHL & ASSOC. INC.
CONSULTING ENGINEERS & SURVEYORS
219 COURT ST. ELYRIA, OHIO 44035

SURVEY FOR:
FRED O. & KATHERINE D. STANLEY

Orig. Lot 27	City of	Date 5-27-86 Scale 1"=40'
Orig. Sec	Village of WELLINGTON	Dwn. by R.G.S Chkd. by
Tract	County of LORAIN	Job No. 86-1486 F.B. NONE
Township of WELLINGTON	State of OHIO	Printed

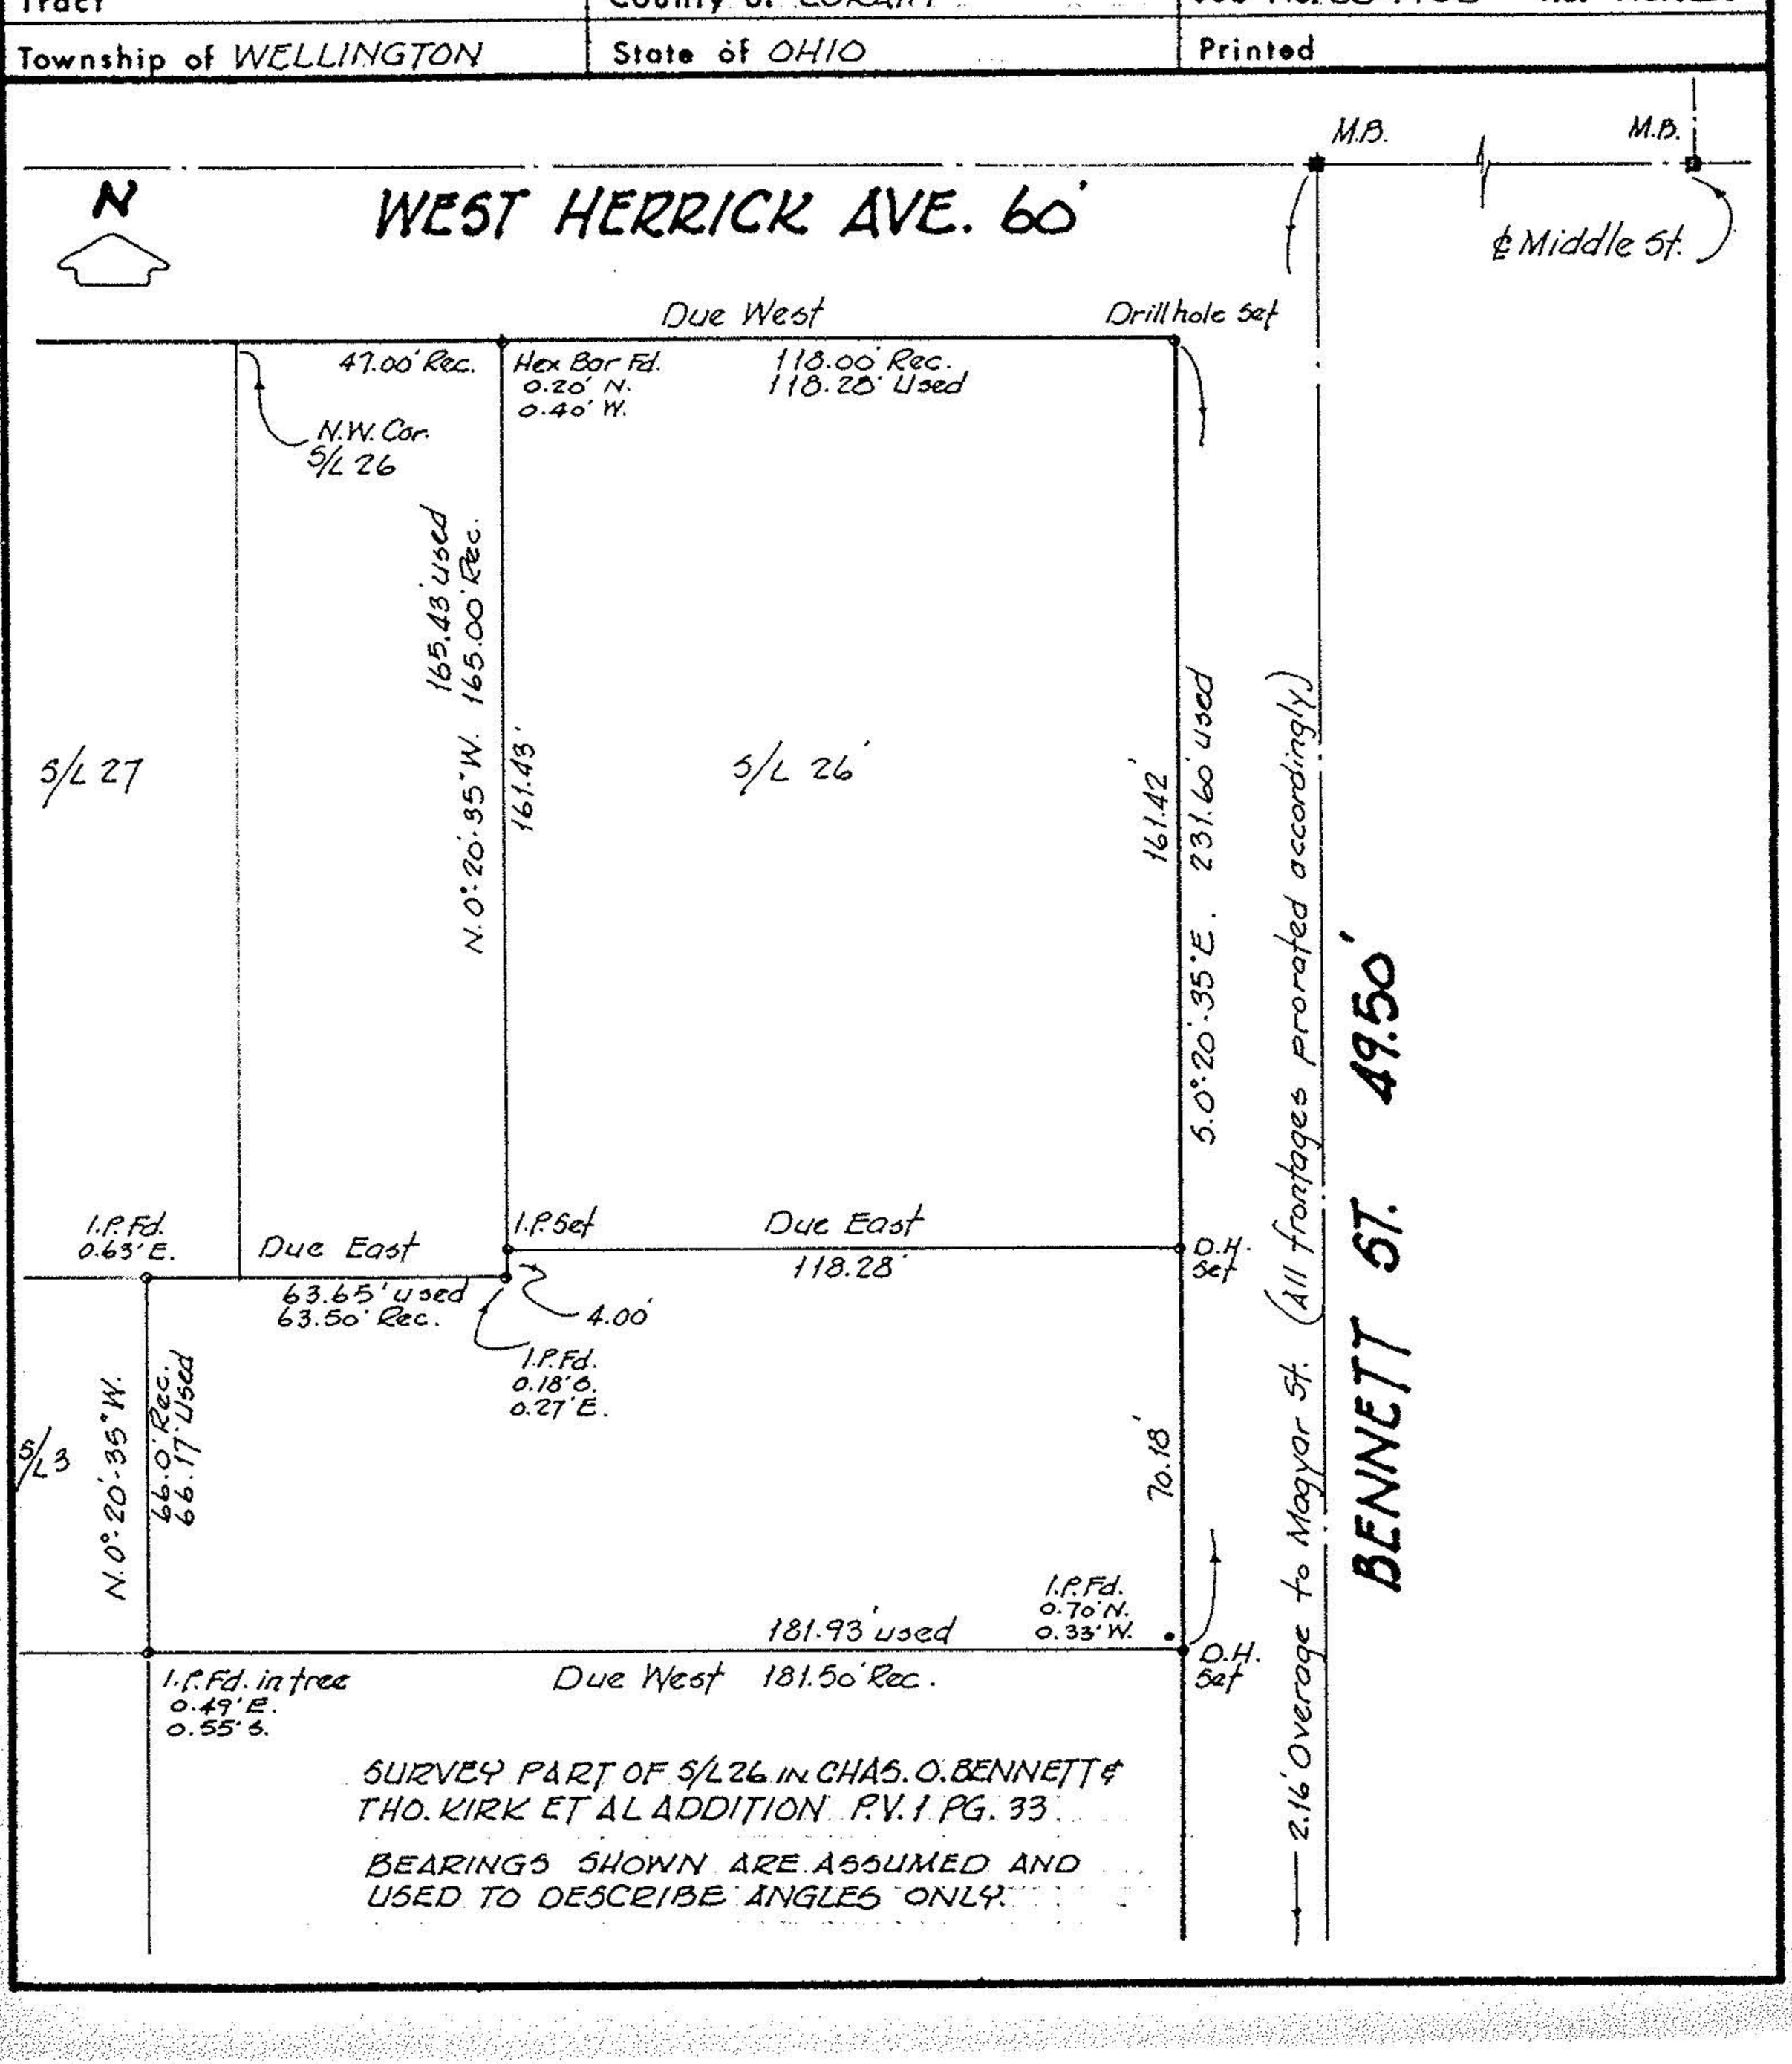

SURVEY PART OF S/L 26 IN CHAS. O. BENNETT & THO. KIRK ET AL ADDITION P.V. 1 PG. 33

BEARINGS SHOWN ARE ASSUMED AND USED TO DESCRIBE ANGLES ONLY.