LAUNDON • SIMON • CAHL & ASSOC., INC.
CONSULTING ENGINEERS & SURVEYORS
110 MIDDLE AVE., ELYRIA, O. 44035

Survey & Lot Split For:
STEVEN & TAMMY SQUIRE

Orig. Lot 26 & 27	City of	Date Jan. 1995 Scale 1" = 100'
Orig. Sec	Village of Wellington	Dwn. by RC Chkd. by RS
Tract	County of Lorain	Job No. 94-2665 F.B. 234 P. 52
Township of Wellington	State of Ohio	Printed

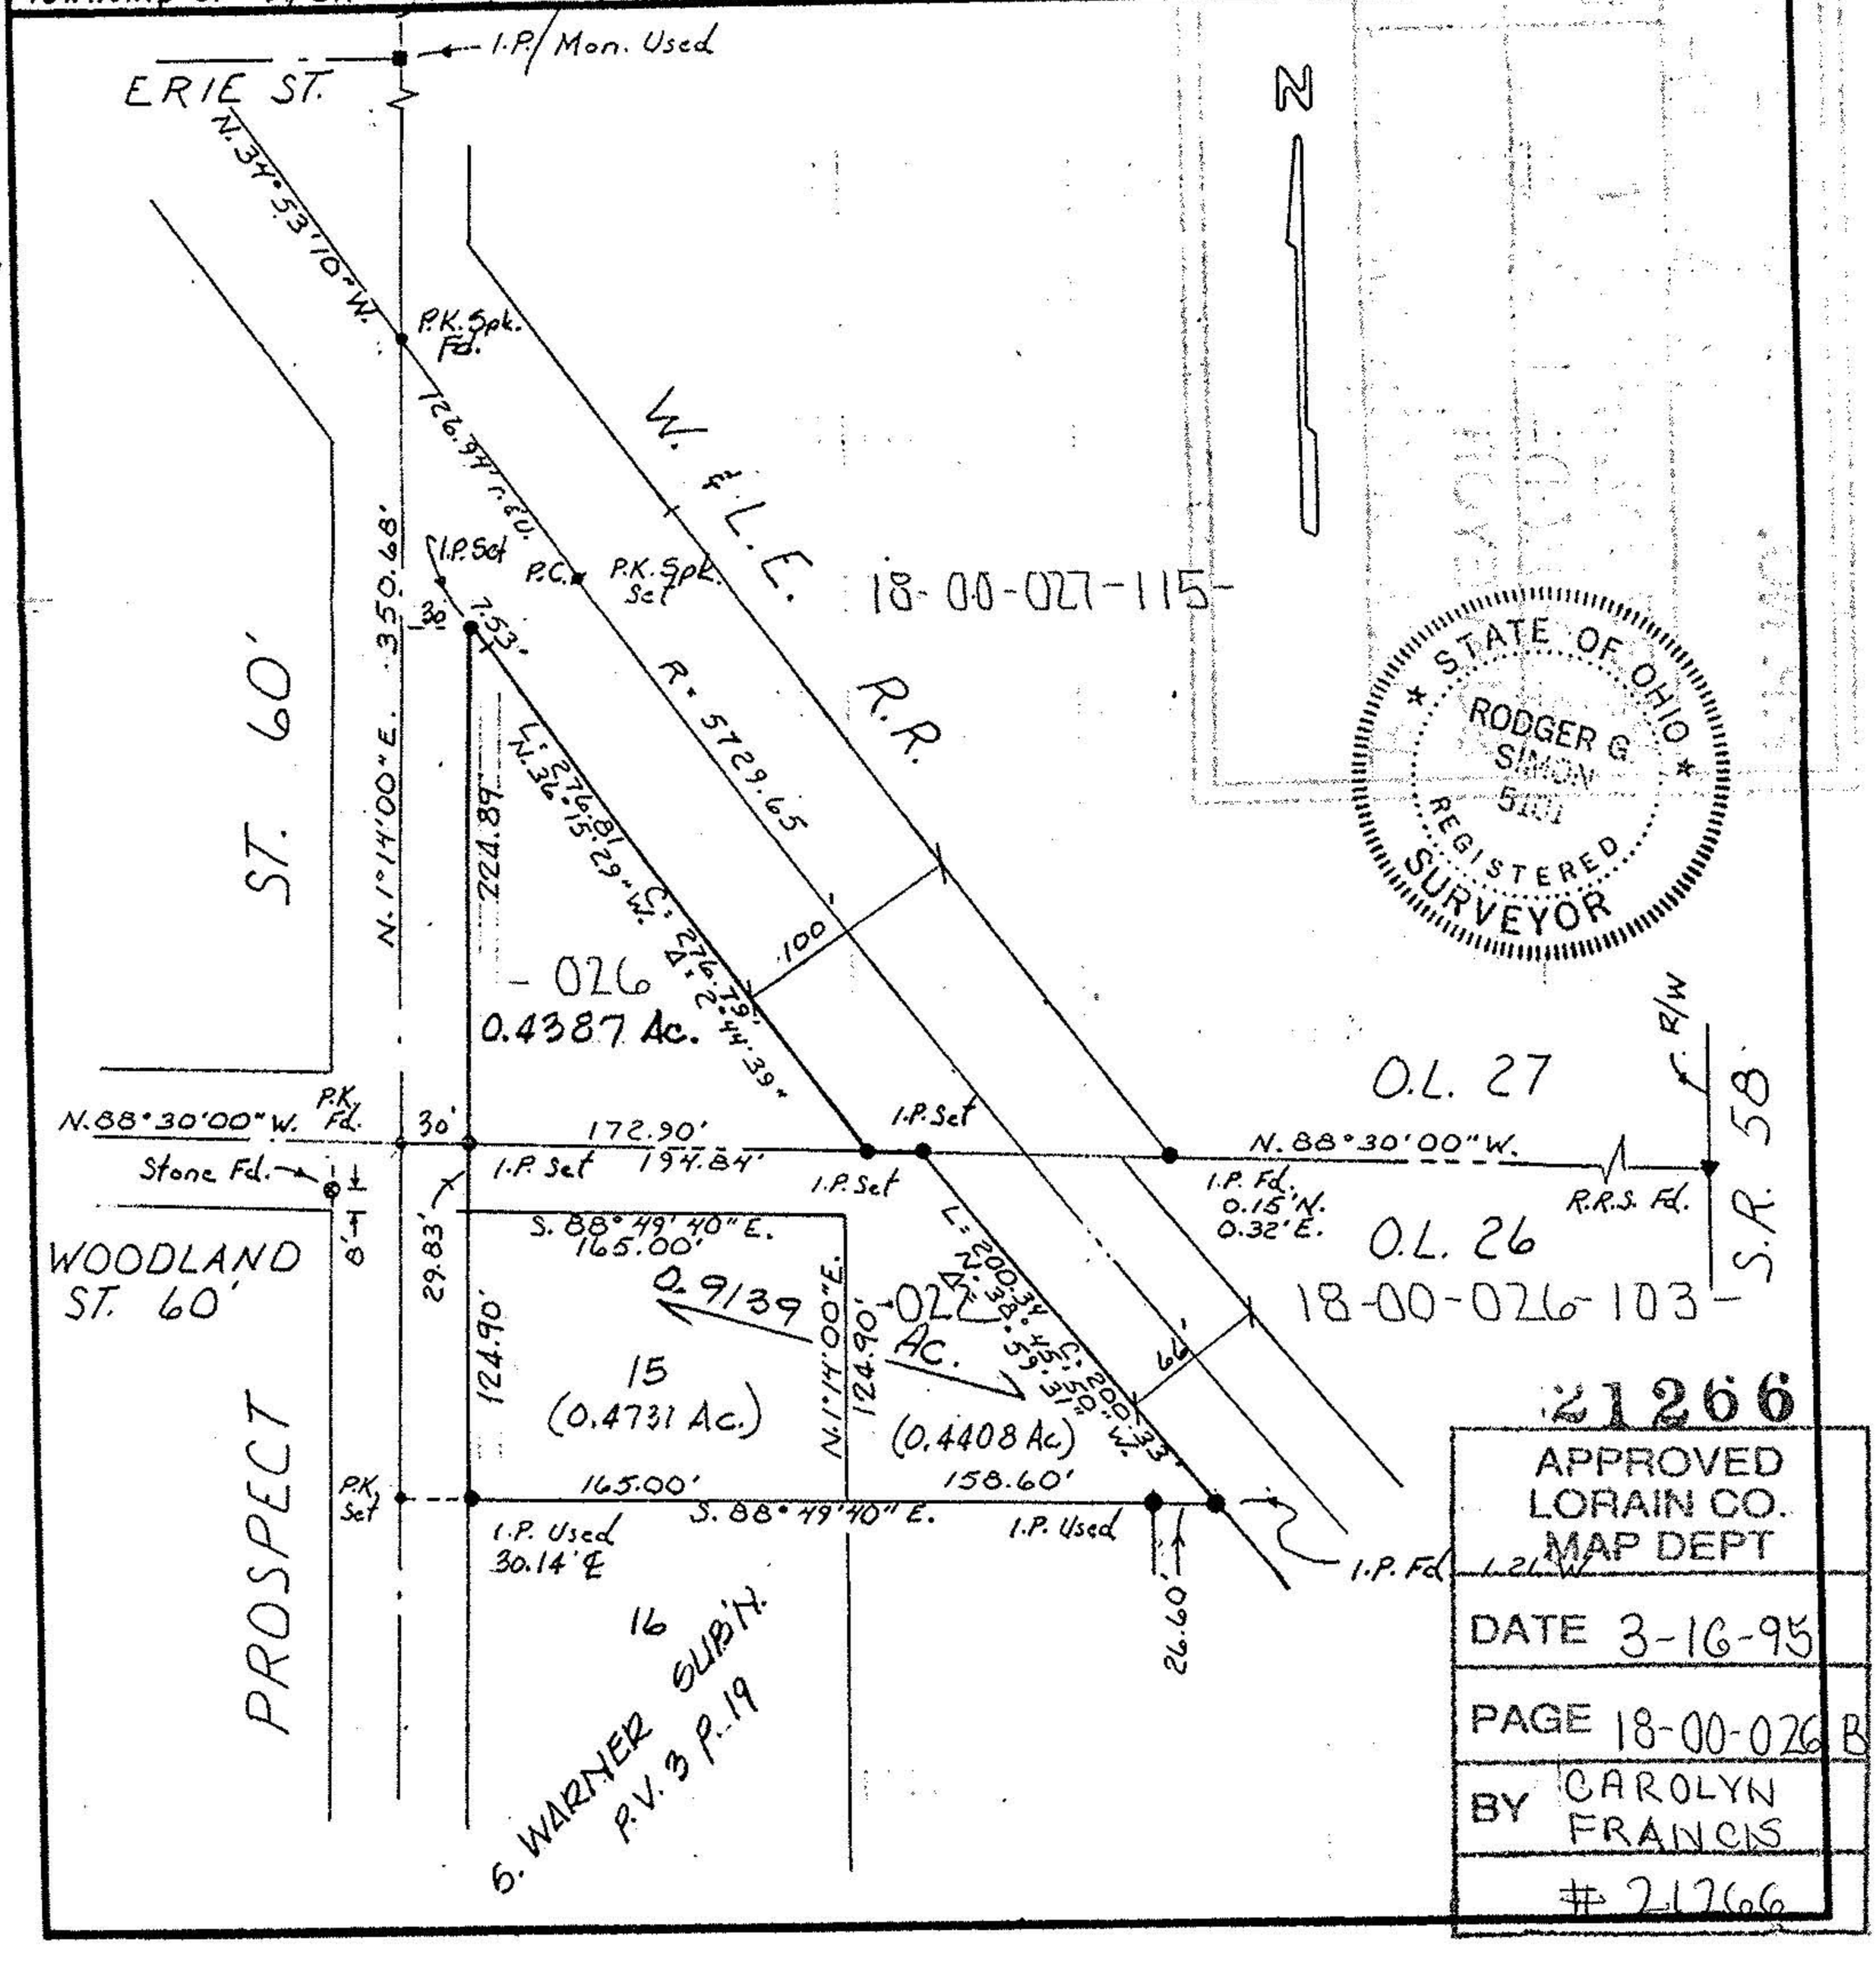

STATE OF OHIO
RODGER G. SIMON 5101 REGISTERED SURVEYOR

21266

APPROVED
LORAIN CO.
MAP DEPT

DATE 3-16-95

PAGE 18-00-026 B

BY CAROLYN FRANCIS

21266