Well 917 m 66

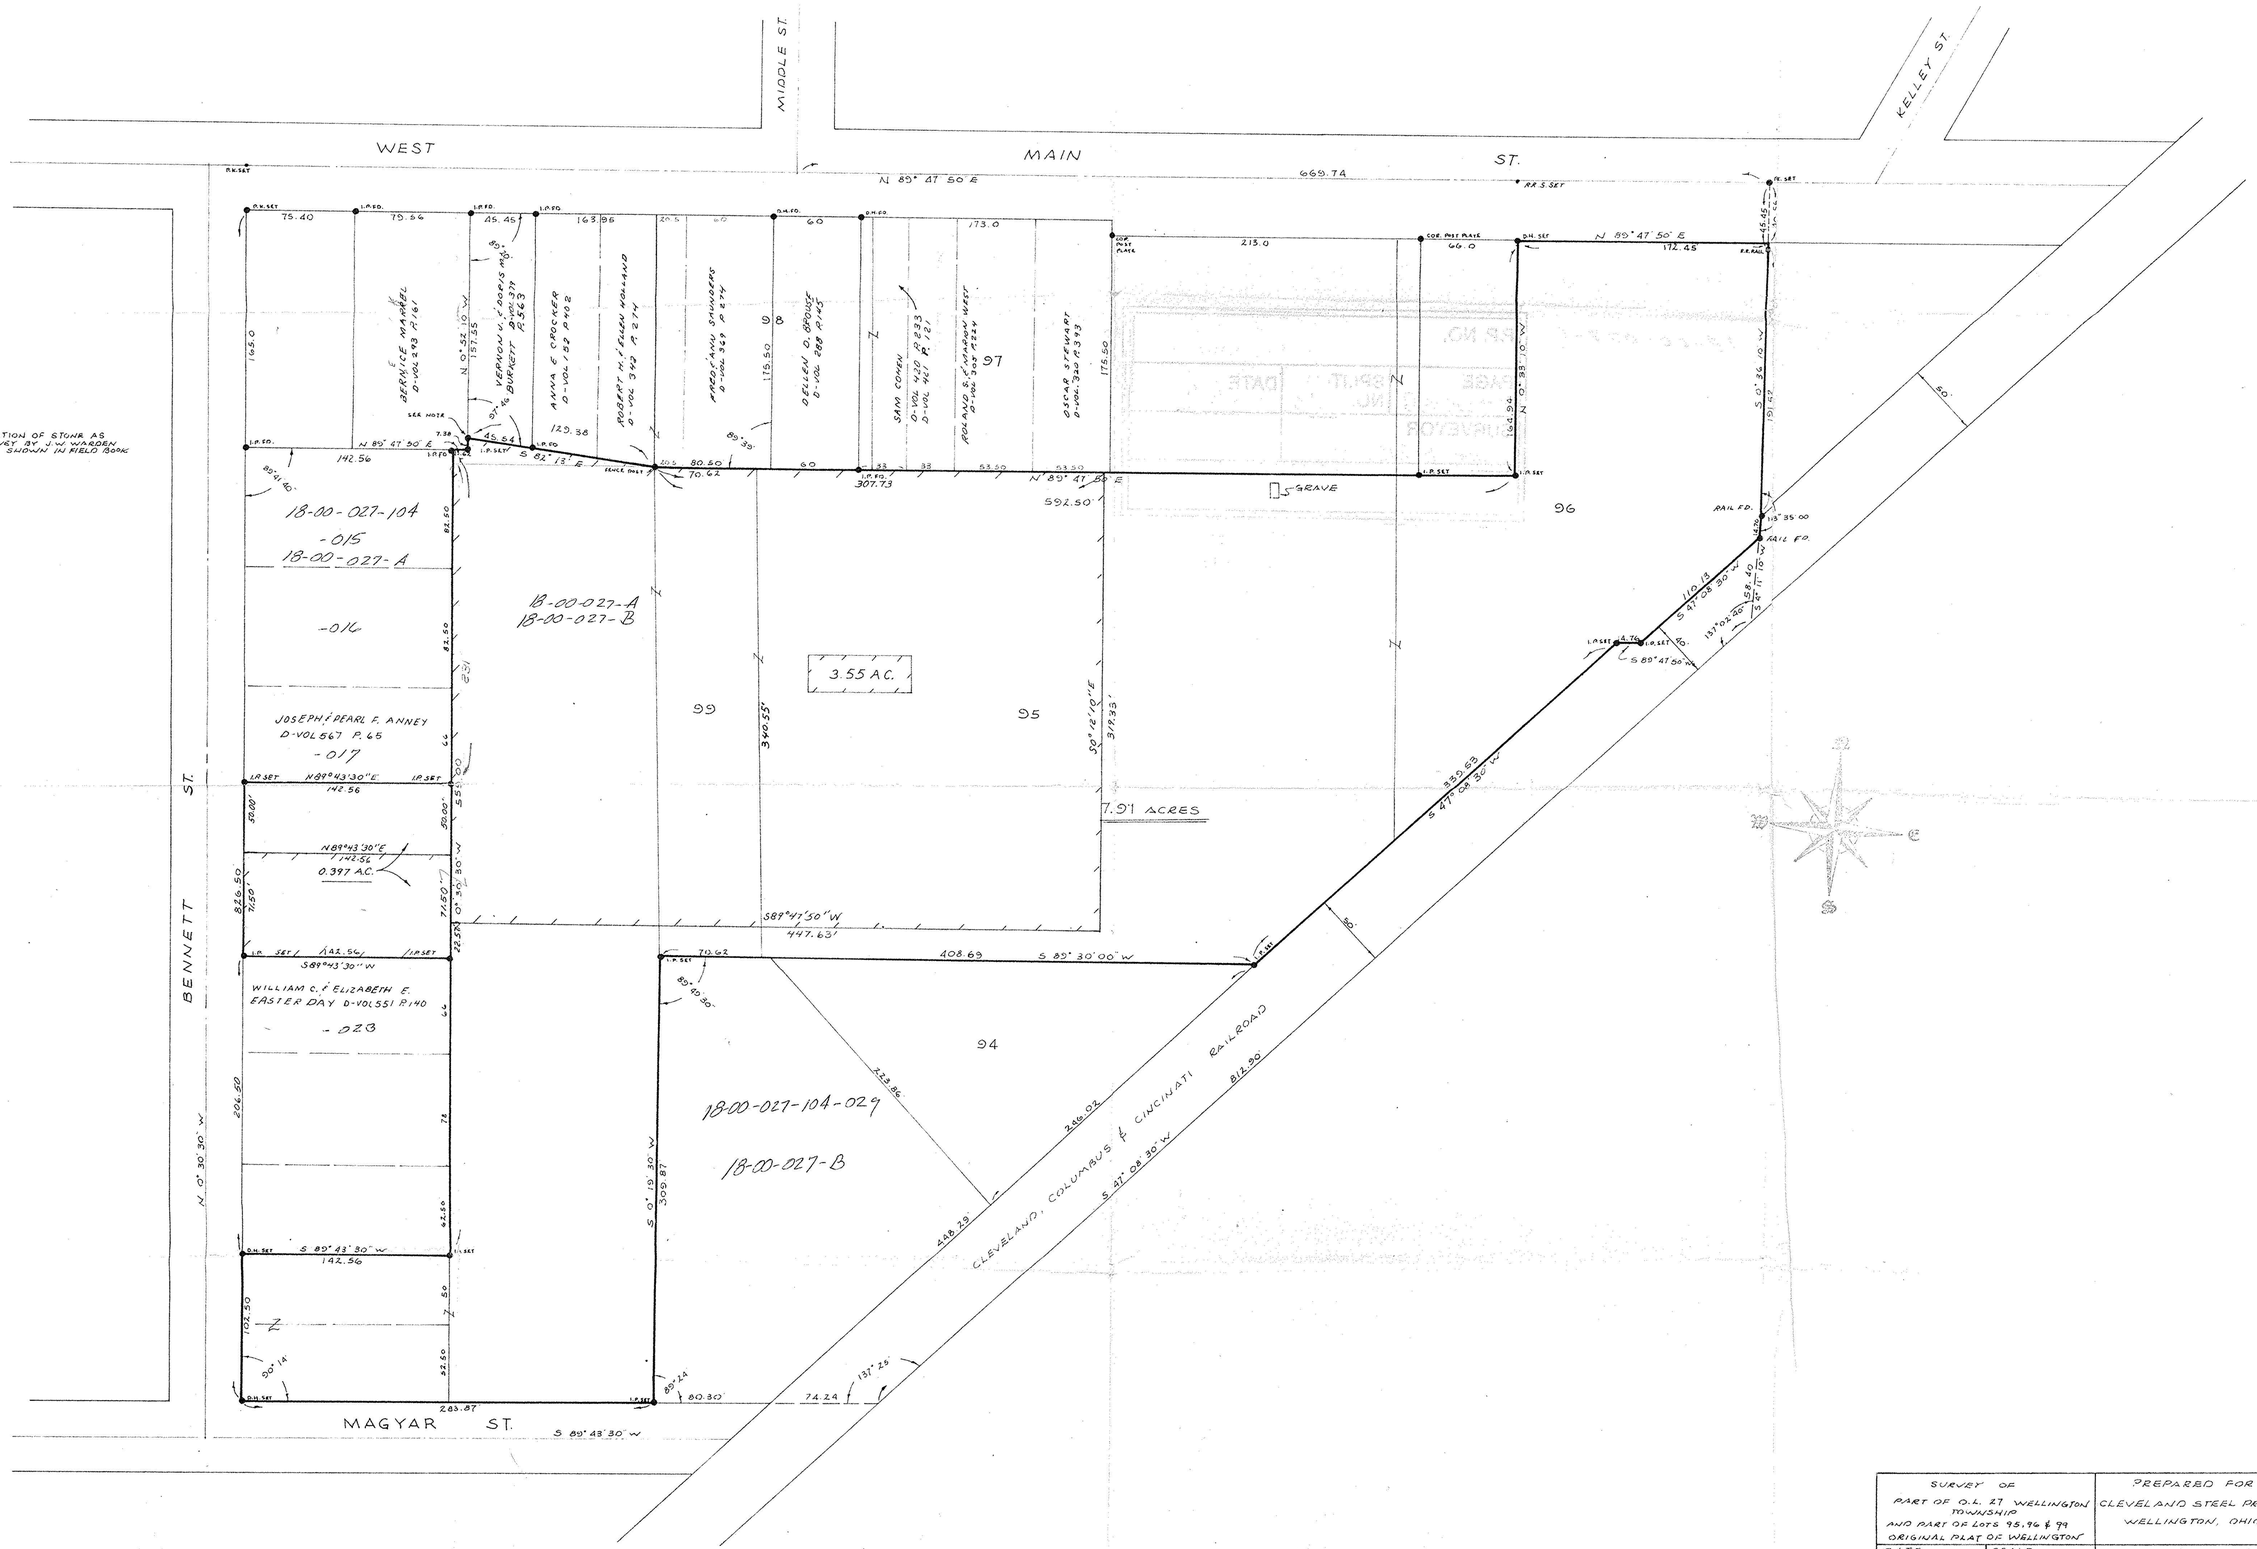

NOTE:
I.P. SET IN LOCATION OF STONE AS SHOWN BY SURVEY BY J. W. WARDEN MAY 20, 1917. SHOWN IN FIELD BOOK 6, PG. 55.

SURVEY OF PART OF O.L. 27 WELLINGTON TOWNSHIP AND PART OF LOTS 95, 96 & 99 ORIGINAL PLAT OF WELLINGTON	PREPARED FOR CLEVELAND STEEL PRODUCTS WELLINGTON, OHIO	JOB NO. 68149
DATE Rev. May 26, 1969 JUNE 17, 1968	SCALE 1" = 50'	SHEET 1 OF 2
DRWN J.H.S. D.D.R.	CHKD	Prepared by JAMES H. SCHMIDT Registered Surveyor 307 Robinson Bldg., Elyria, O.

REV AUG. 6, 1969