FILE
NS
4719B

PLAT OF SURVEY FOR

BRADLEY DEVELOPMENT CO., INC.

OF PART OF ORIGINAL WELLINGTON TOWNSHIP LOT NO. 26, NOW IN THE CITY OF WELLINGTON, LORAIN COUNTY, OHIO.

DECEMBER 10, 1997 SCALE 1" = 30'

Eric J. Nelson
ERIC J. NELSON

GILES NELSON & ASSOC. INC.
CIVIL ENGINEER & SURVEYORS
4402 WEST 215th STREET
FAIRVIEW PARK, OHIO 44126
PHONE 331-9110

STATE OF OHIO
ERIC J. NELSON
7348
REGISTERED

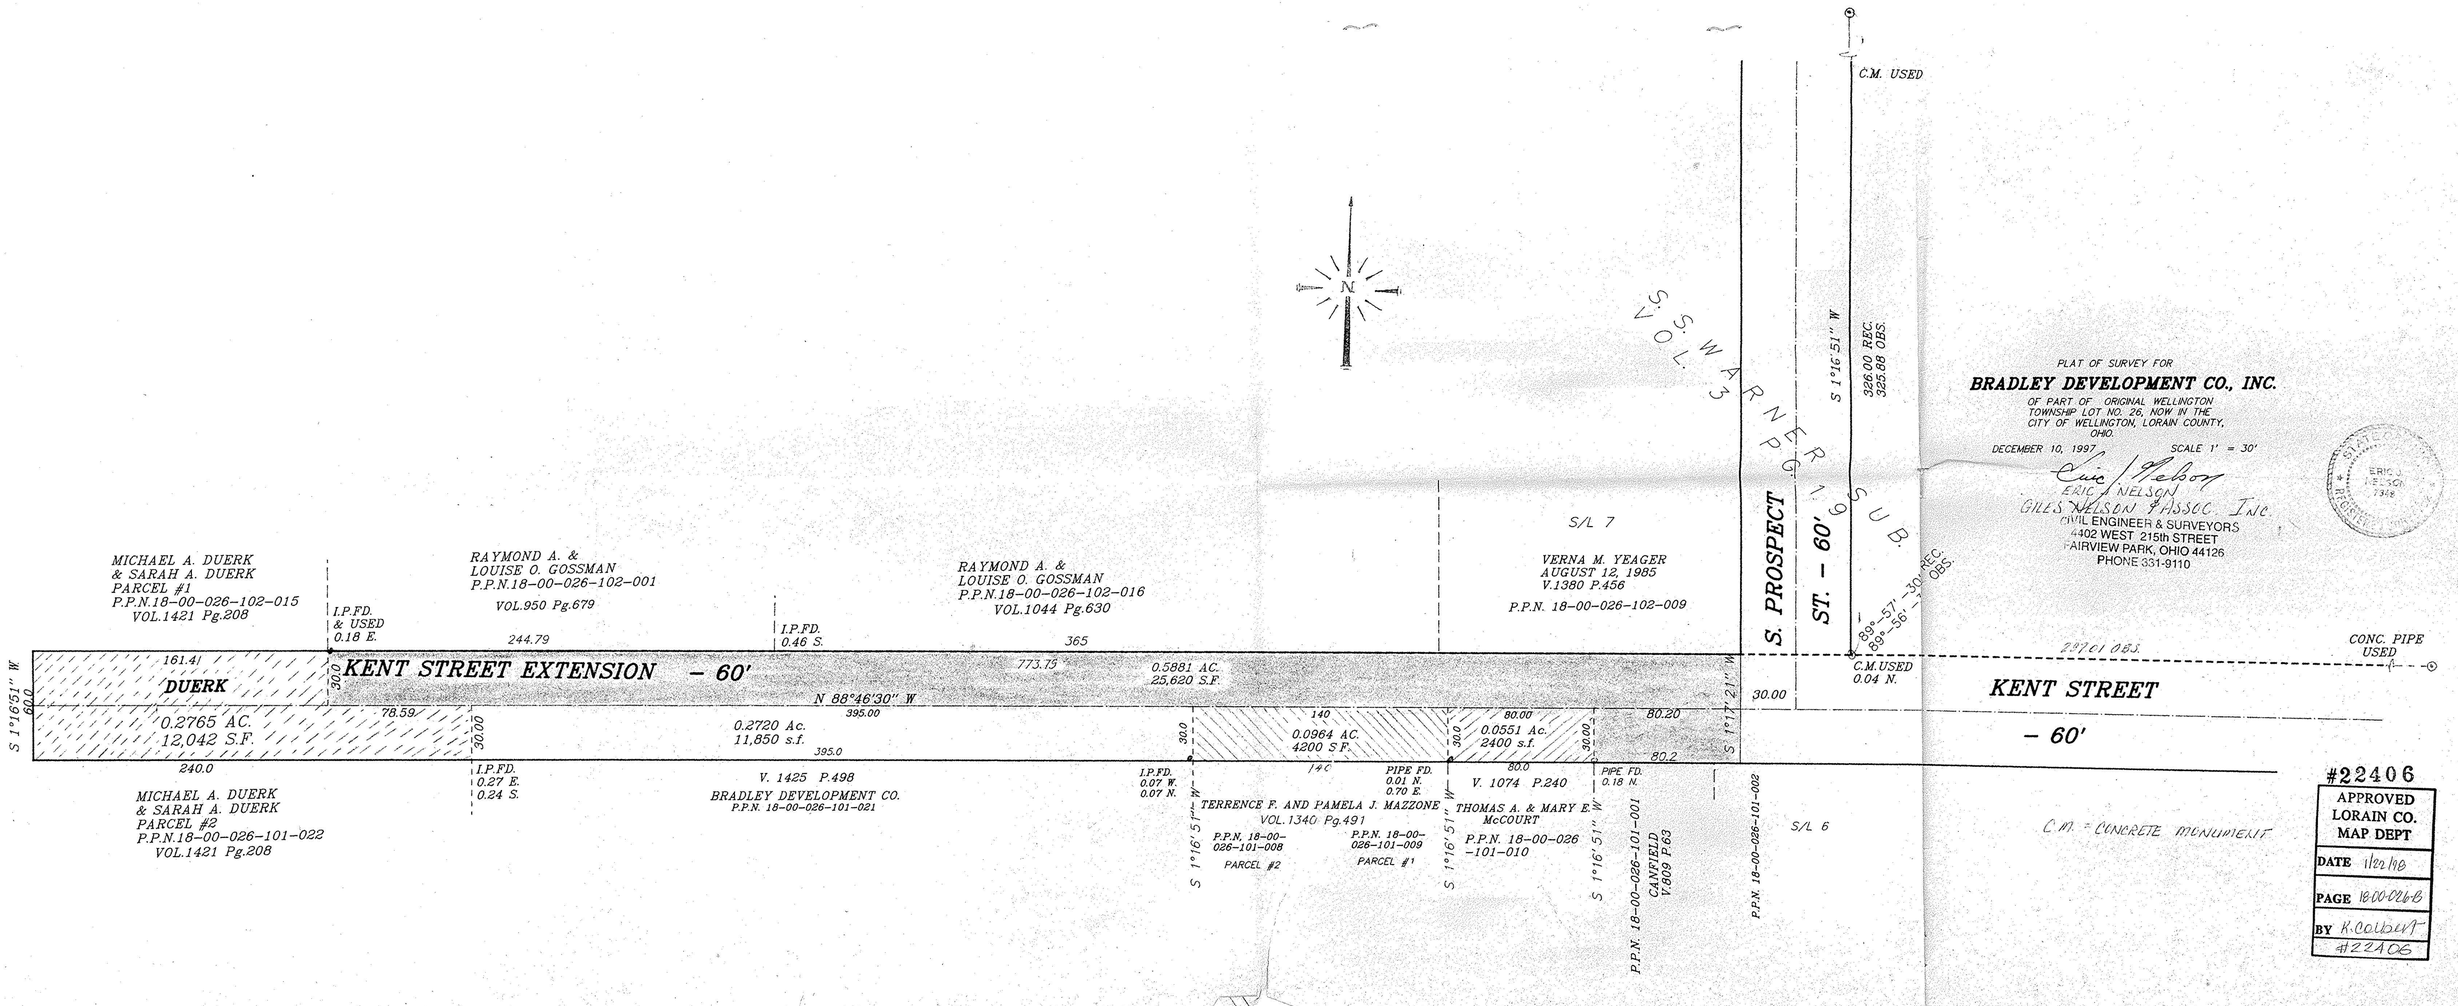

C.M. = CONCRETE MONUMENT

#22406

APPROVED
LORAIN CO.
MAP DEPT

DATE 1/22/98

PAGE 18-00-026-B

BY K. COLBERT

#22406