#18 Wellington
OL. #27

MAP OF PART OF ORIGINAL WELLINGTON TOWNSHIP
LOT NO. 27 AND PART OF LOT NO. 47, ORIGINAL
VILLAGE PLAT WELLINGTON VILLAGE
LORAIN COUNTY OHIO

SCALE: 1" = 30' MAY 31-1970 5:10 P.M.

NOTE: There are no encroachments onto this property, but old shed encroaches off rear of property.

Gary E. Penfound REG. SURVEYOR NO. 4457.

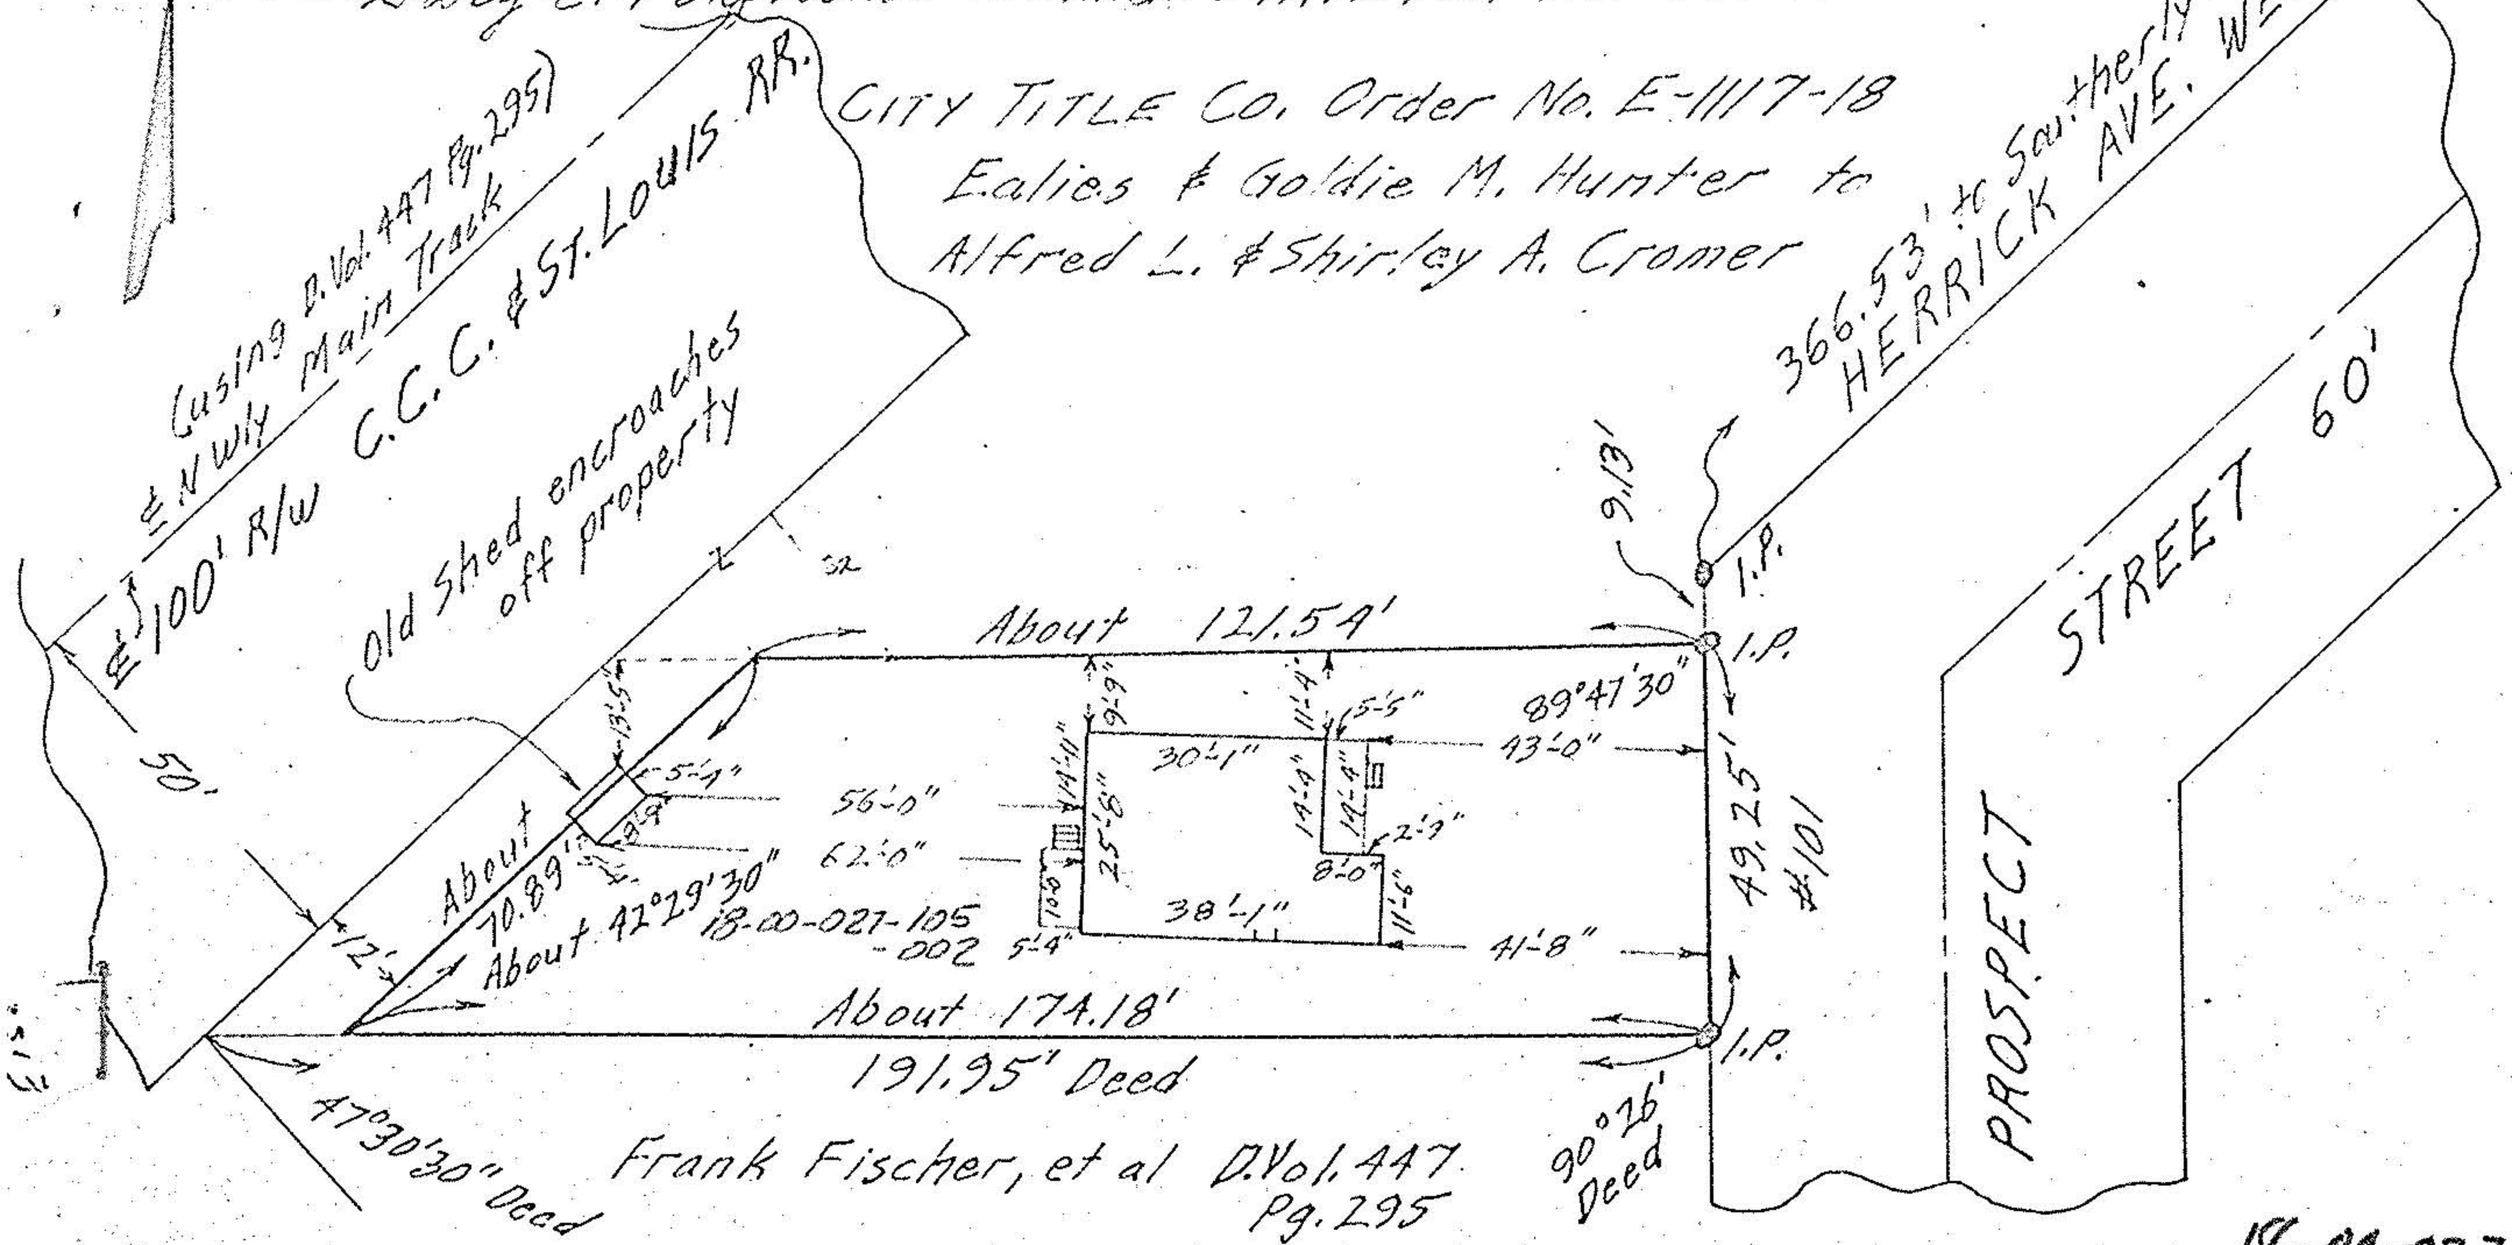

Frank Fischer, et al D.Vol. 447 Pg. 295

18-00-027-B