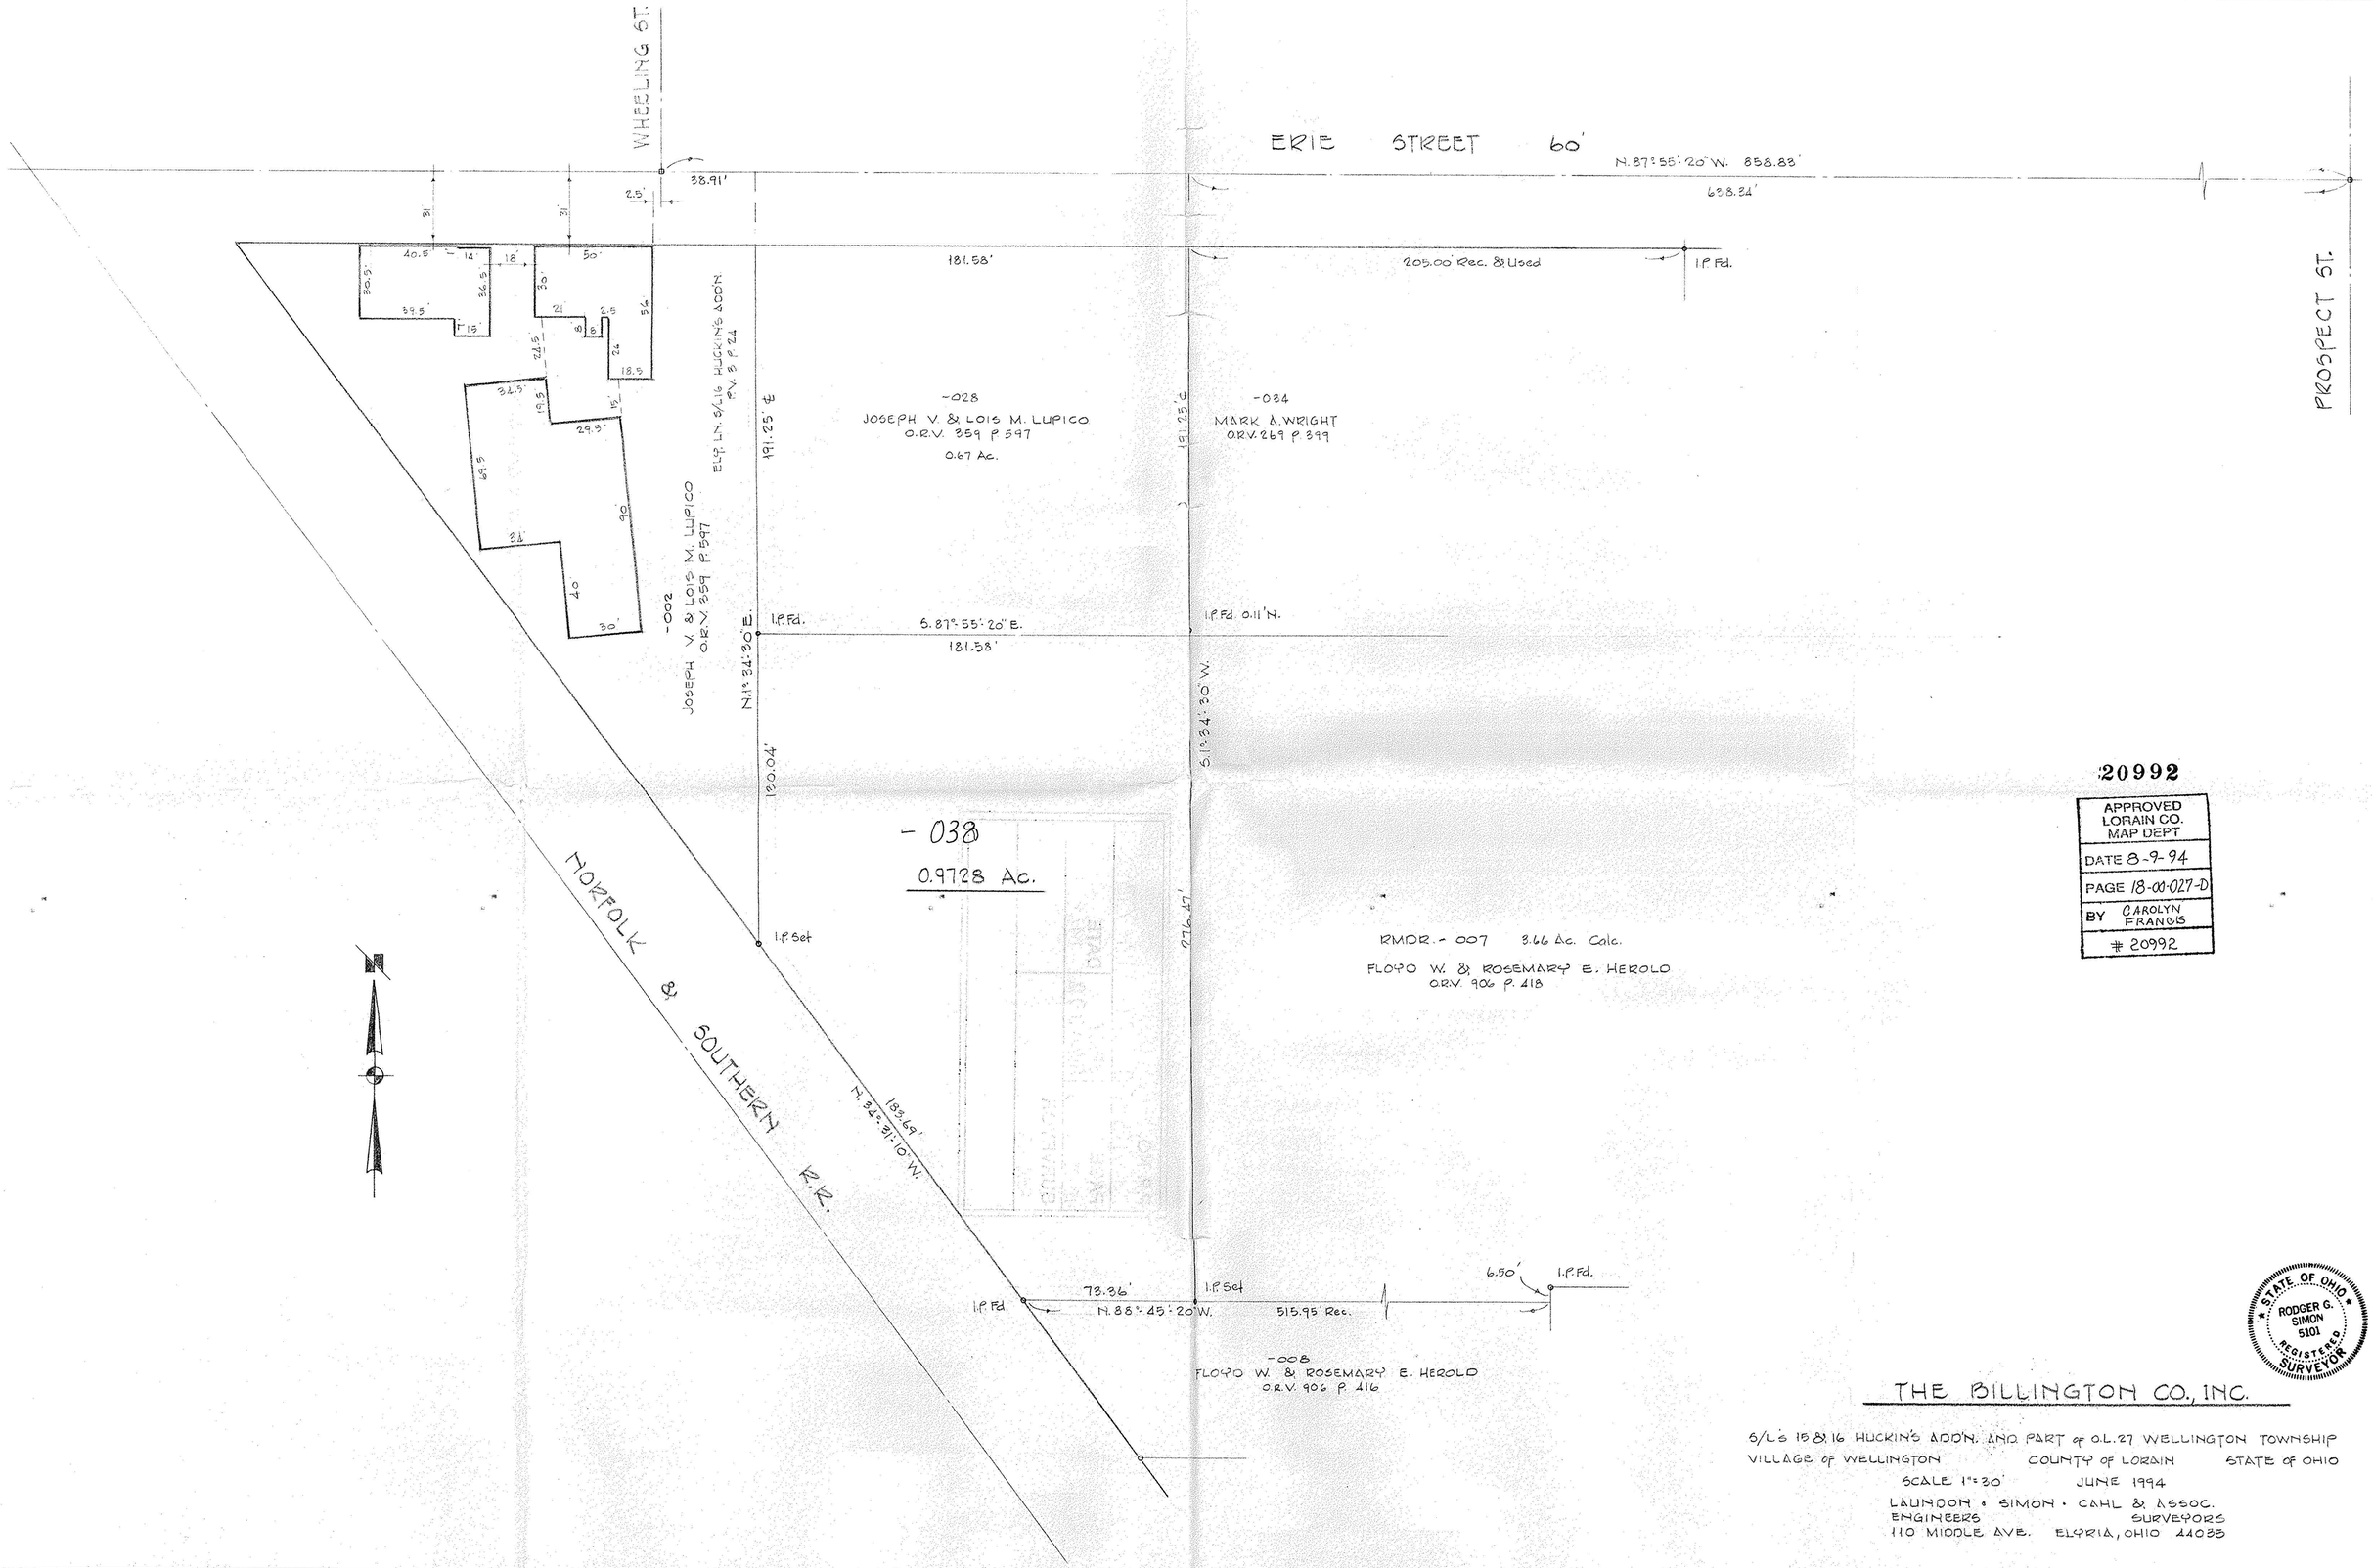

20992

APPROVED
LORAIN CO.
MAP DEPT
DATE 8-9-94
PAGE 18-00-027-D
BY CAROLYN FRANCIS
20992

STATE OF OHIO
RODGER G. SIMON
5101
REGISTERED SURVEYOR

THE BILLINGTON CO., INC.

S/L'S 15 & 16 HUCKIN'S ADD'N. AND PART OF O.L. 27 WELLINGTON TOWNSHIP
VILLAGE OF WELLINGTON COUNTY OF LORAIN STATE OF OHIO
SCALE 1" = 30' JUNE 1994
LANDON • SIMON • CAHL & ASSOC.
ENGINEERS SURVEYORS
110 MIDDLE AVE. ELYRIA, OHIO 44035