


HENRY H. & DOROTHY E. SCHRIEVER P. 236 PCL #2

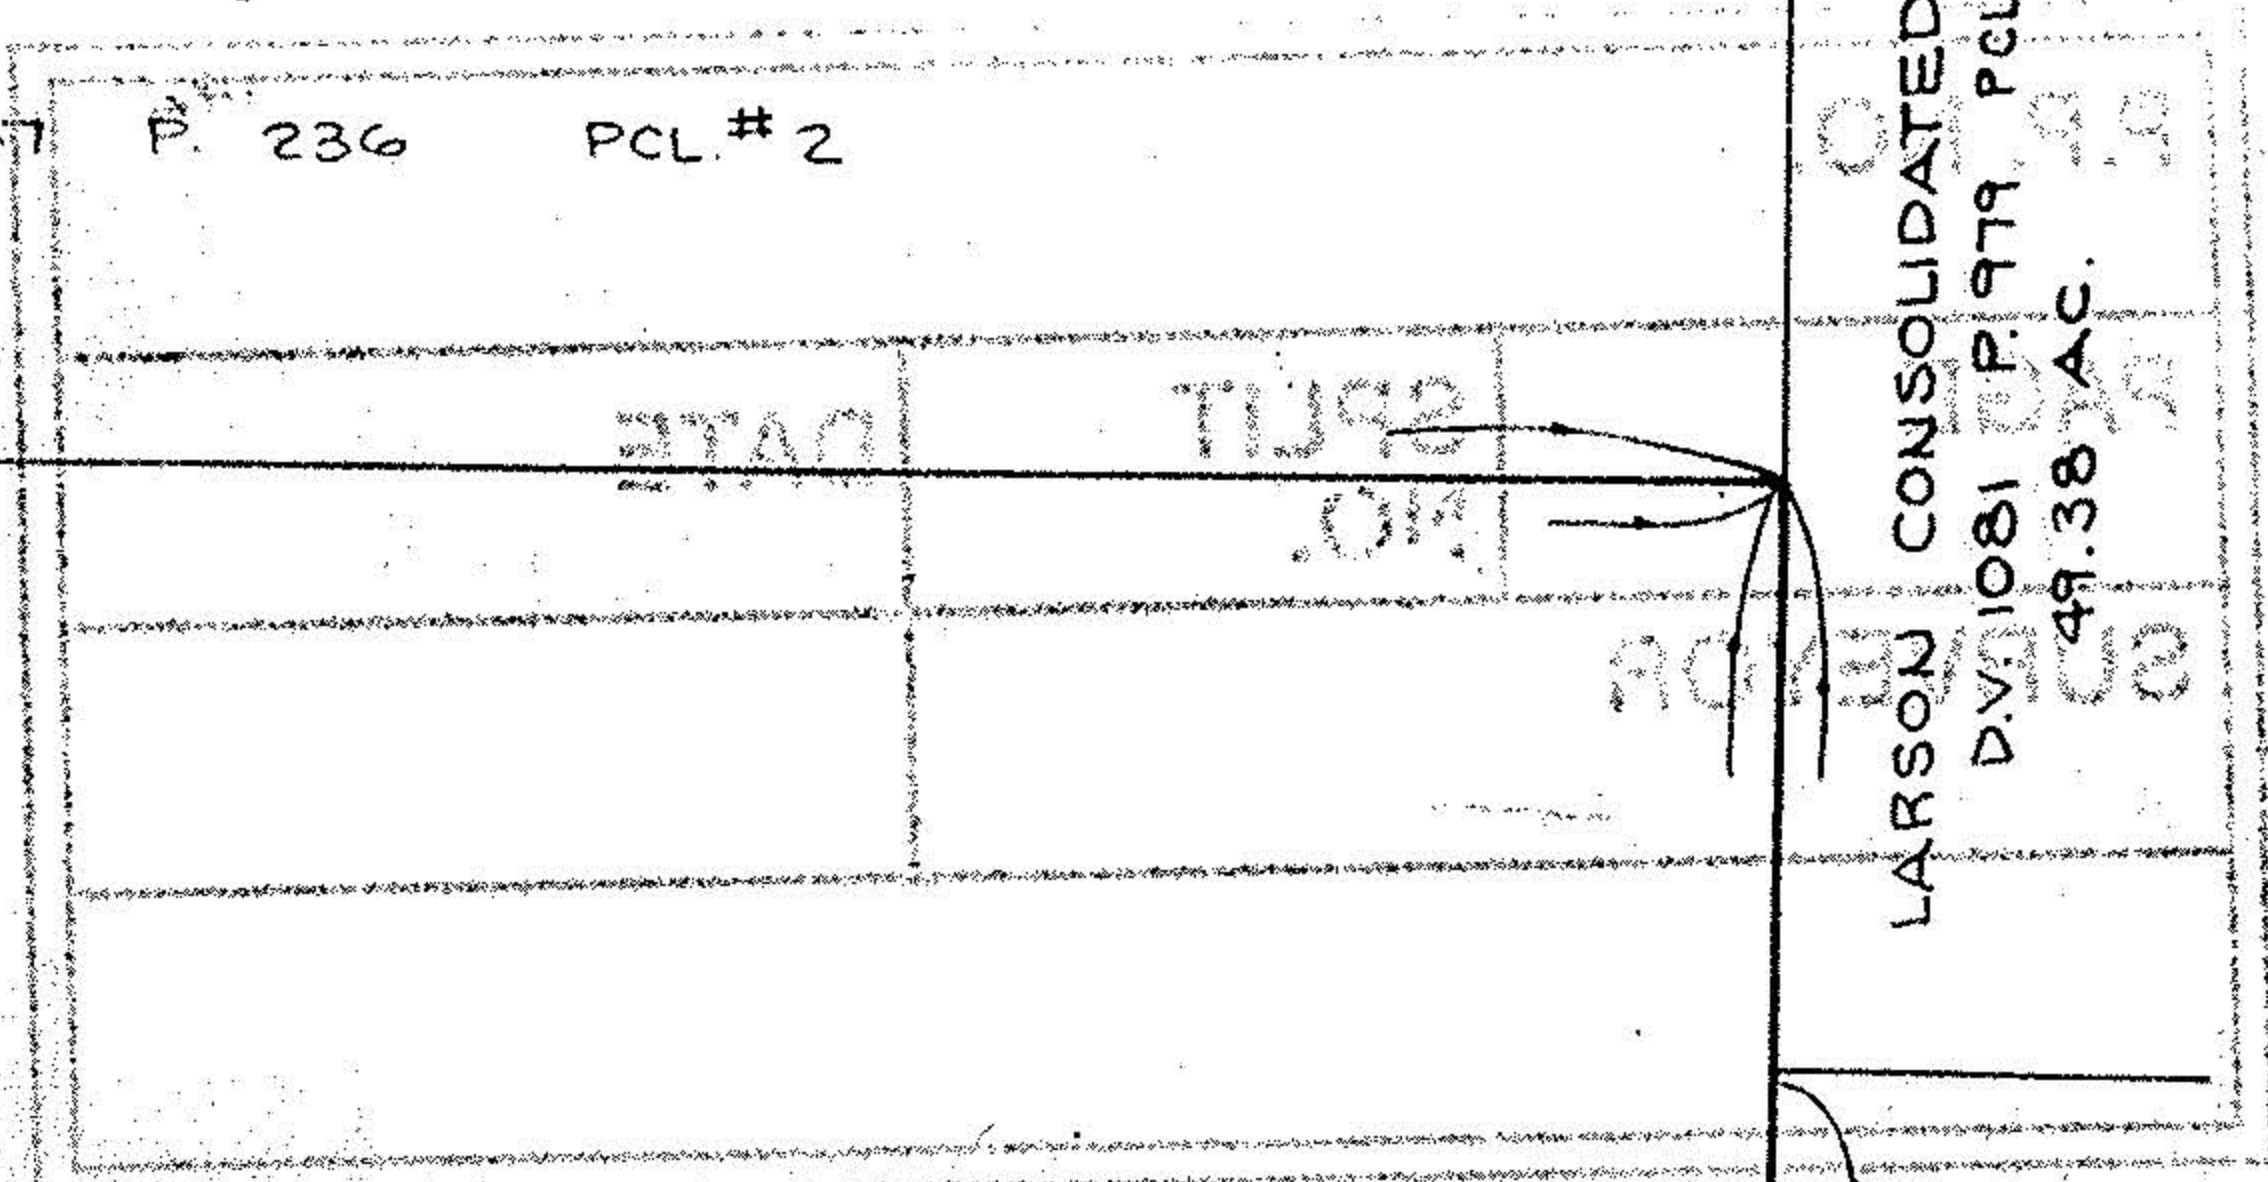

LARSON CONSOLIDATED INC.  
D.V. 1081 P. 979 PCL #2  
49.38 AC.

MENNELL ROAD

60'

RUDY A. WELLS  
&  
SUSAN C. WELLS  
D.V. 1077 P. 848  
2.69 AC.

SWAYNE A. & JEAN C. WELLS  
D.V. 1097 P. 649  
2.00 AC.

JAMES B. WELLS SR.  
&  
JACQUELINE WELLS  
D.V. 1101 P. 33  
(2.00 AC.)

CHARLES K. WELLS  
&  
CHERYL WELLS  
D.V. 1214 P. 409  
2.00 AC.

418.24 Meas.  
418 REC.  
S-86°37'19"E I.P.SET  
350.95'

*SOLD*  
2.130 AC.  
(KS SURV. 3-14-89)

*To BE Combined as 1 Parcel*

2.15 AC.  
FLOYD D. &  
TERRI L.  
WELLS  
D.V. 1305 P. 345

LARRY E. &  
DIANE S.  
WELLS  
D.V. 1299  
P. 297  
2.15 AC.

(KSA SURV.:  
10-21-81  
81-132

GARY W. &  
BARBARA A.  
RUTHERFORD  
D.V. 1265  
P. 383  
(2.24 AC.)

(KSA SURV.:  
7-17-80  
80-108

S-86°37'40"E  
350.96'

ESMT.  
D.V. 1066 P. 95  
TO STATE OF OHIO


WAKEMAN - LAGRANGE - RICHFIELD ROAD

1359 D.V. 1029 P. 996)  
1366 D.V. 1229 P. 100)  
1367 D.V. 1058 P. 619)

S.R. 303

813.53 ±  
1282.38 ± REC. (D.V. 1029 P. 996)  
134.75 REC.  
ROGER & ALBERTA UEHLEIN D.V. 1058 P. 619  
8.82 AC.

400.80 REC.  
GARY L. & CHARLENE M.  
PREDMORE  
D.V. 1229 P. 700

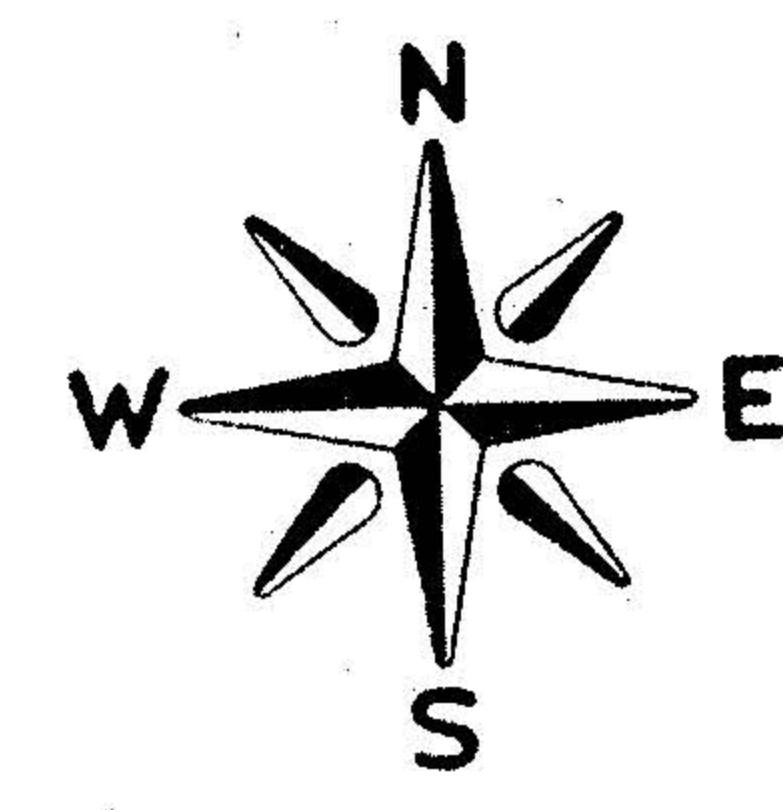

### PARCEL MAP

OF PART OF  
**GRAFTON TWP. ORIG. LOT 44**  
TOWNSHIP OF GRAFTON COUNTY OF LORAIN

STATE OF OHIO  
SCALE: 1" = 100' OCT. 21, 1981

PREPARED BY  
**KLEINOEDER-SCHMIDT & ASSOC.**  
CONSULTING ENGINEERS & SURVEYORS

-18999

APPROVED
LORAIN CO.
MAP DEPT.
DATE 6/21/90
PAGE 16-B
BY T. Hows & P.C.
VOID AFTER 18999

81-45  
81-132  
82-82  
80-108  
88-473

1.) REV. 7-30-82 - UPDATE OWNERSHIPS - ADD 2.15 AC. PCL. K.V.S.  
2.) REV. 3-14-89 - UPDATE OWNERSHIPS - ADD 2.130 AC. 02  
3.) REV. 5-22-90 - ADD 1.961 AC. PCL. 02