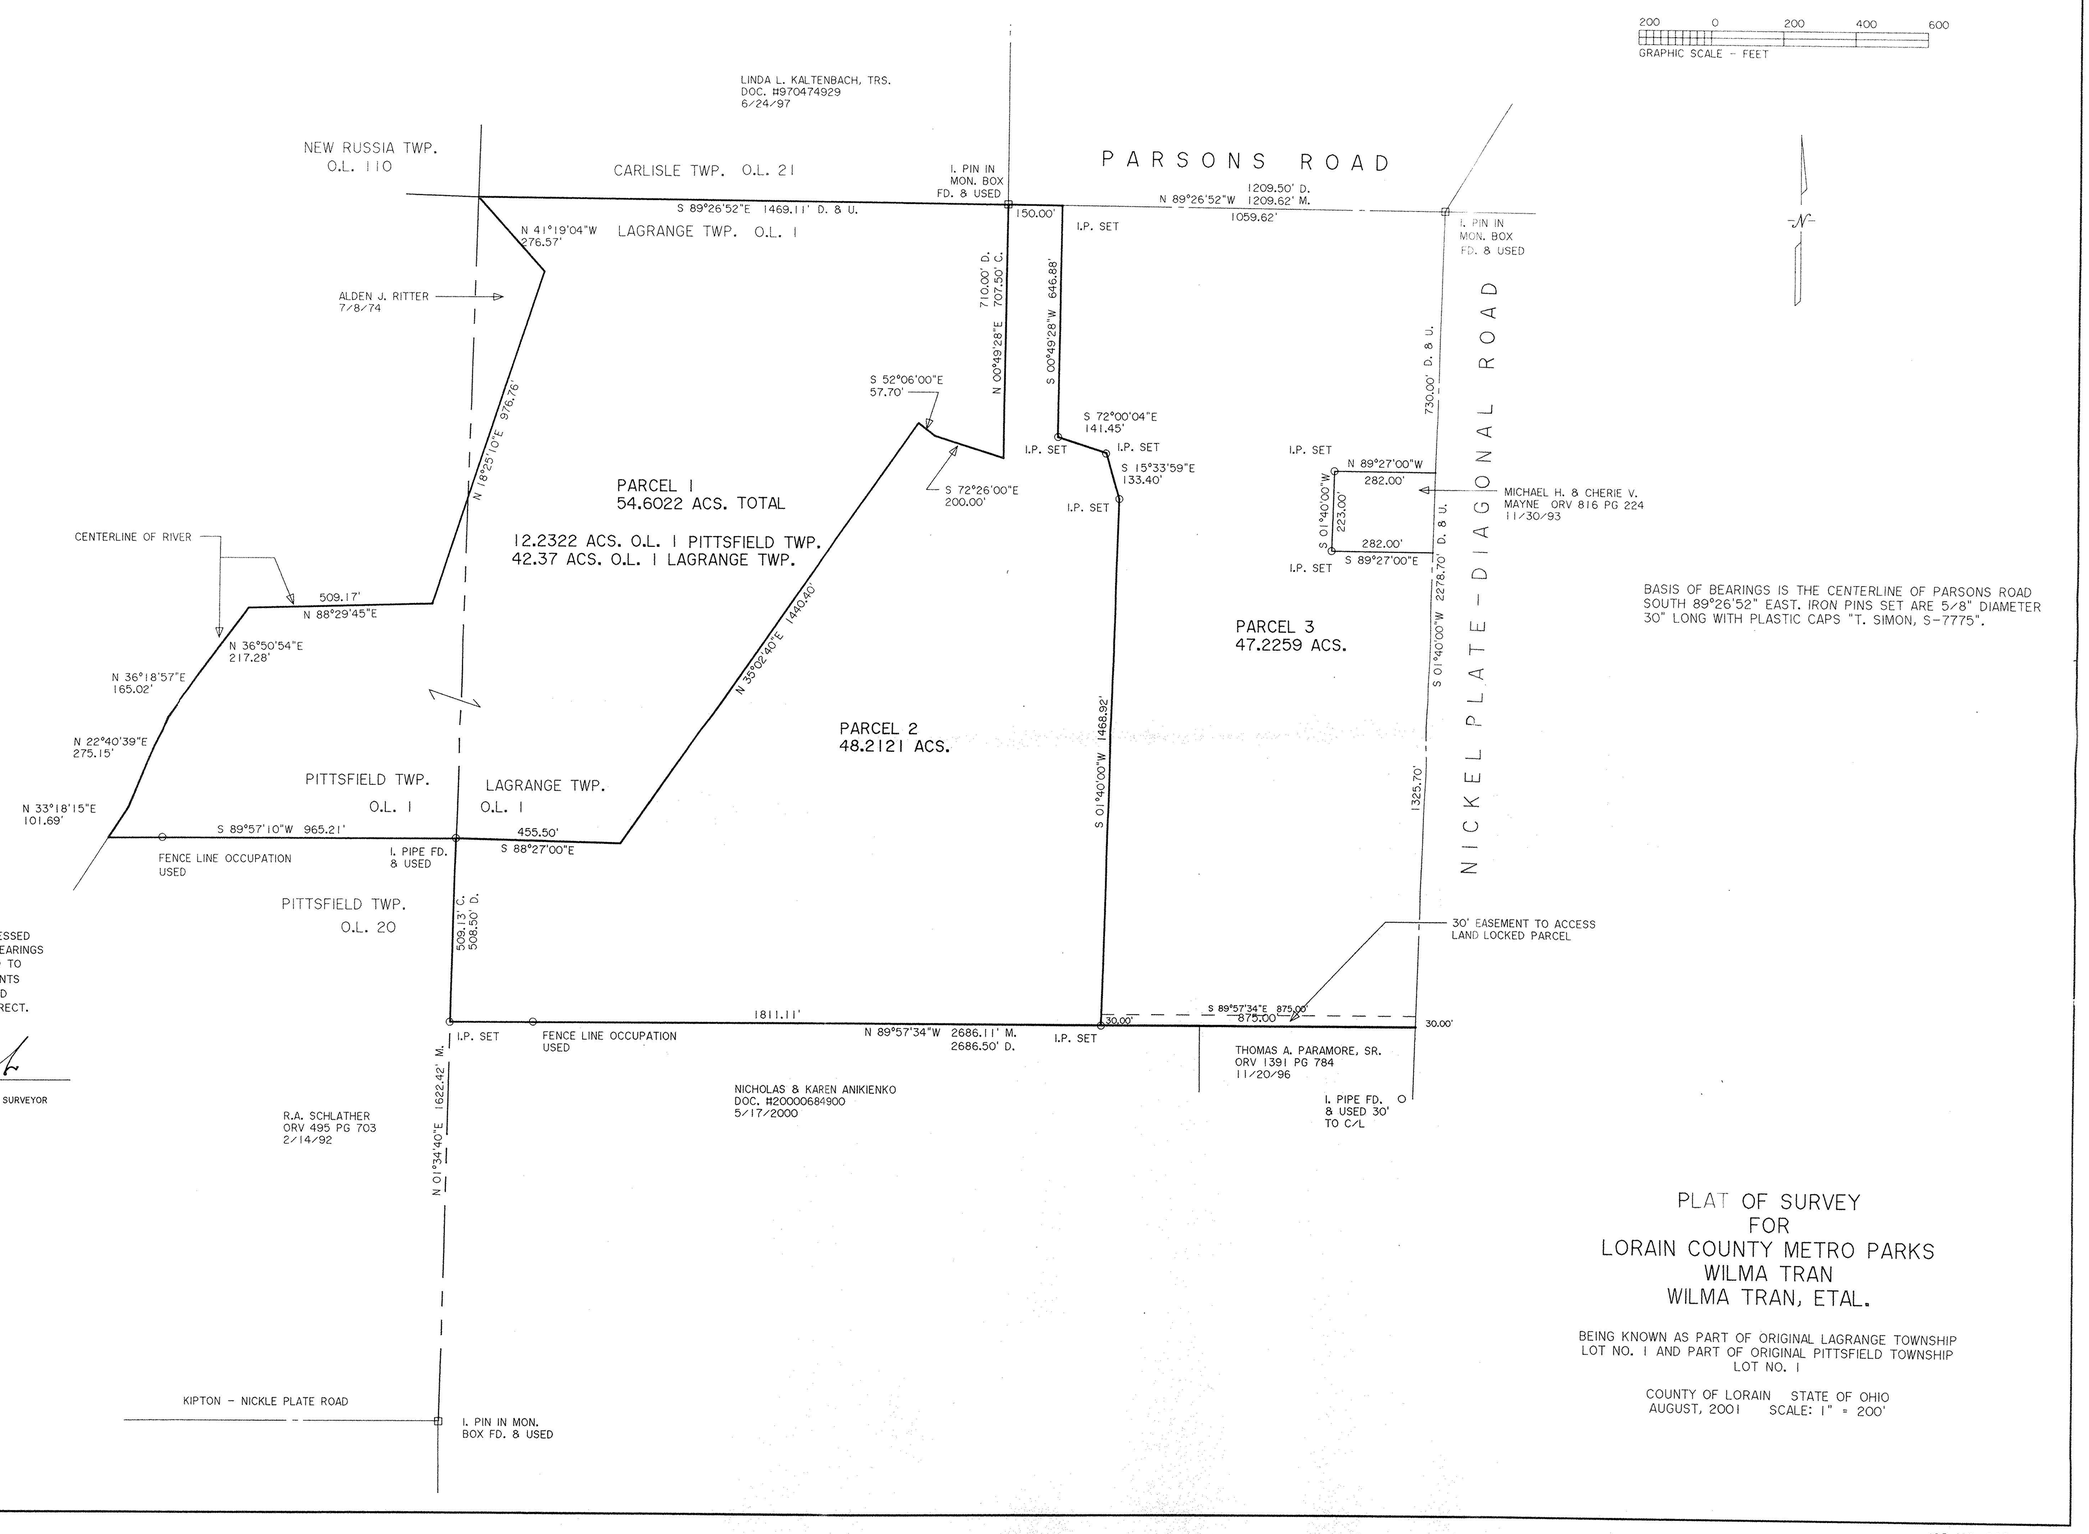


JOB NO. 2001-054

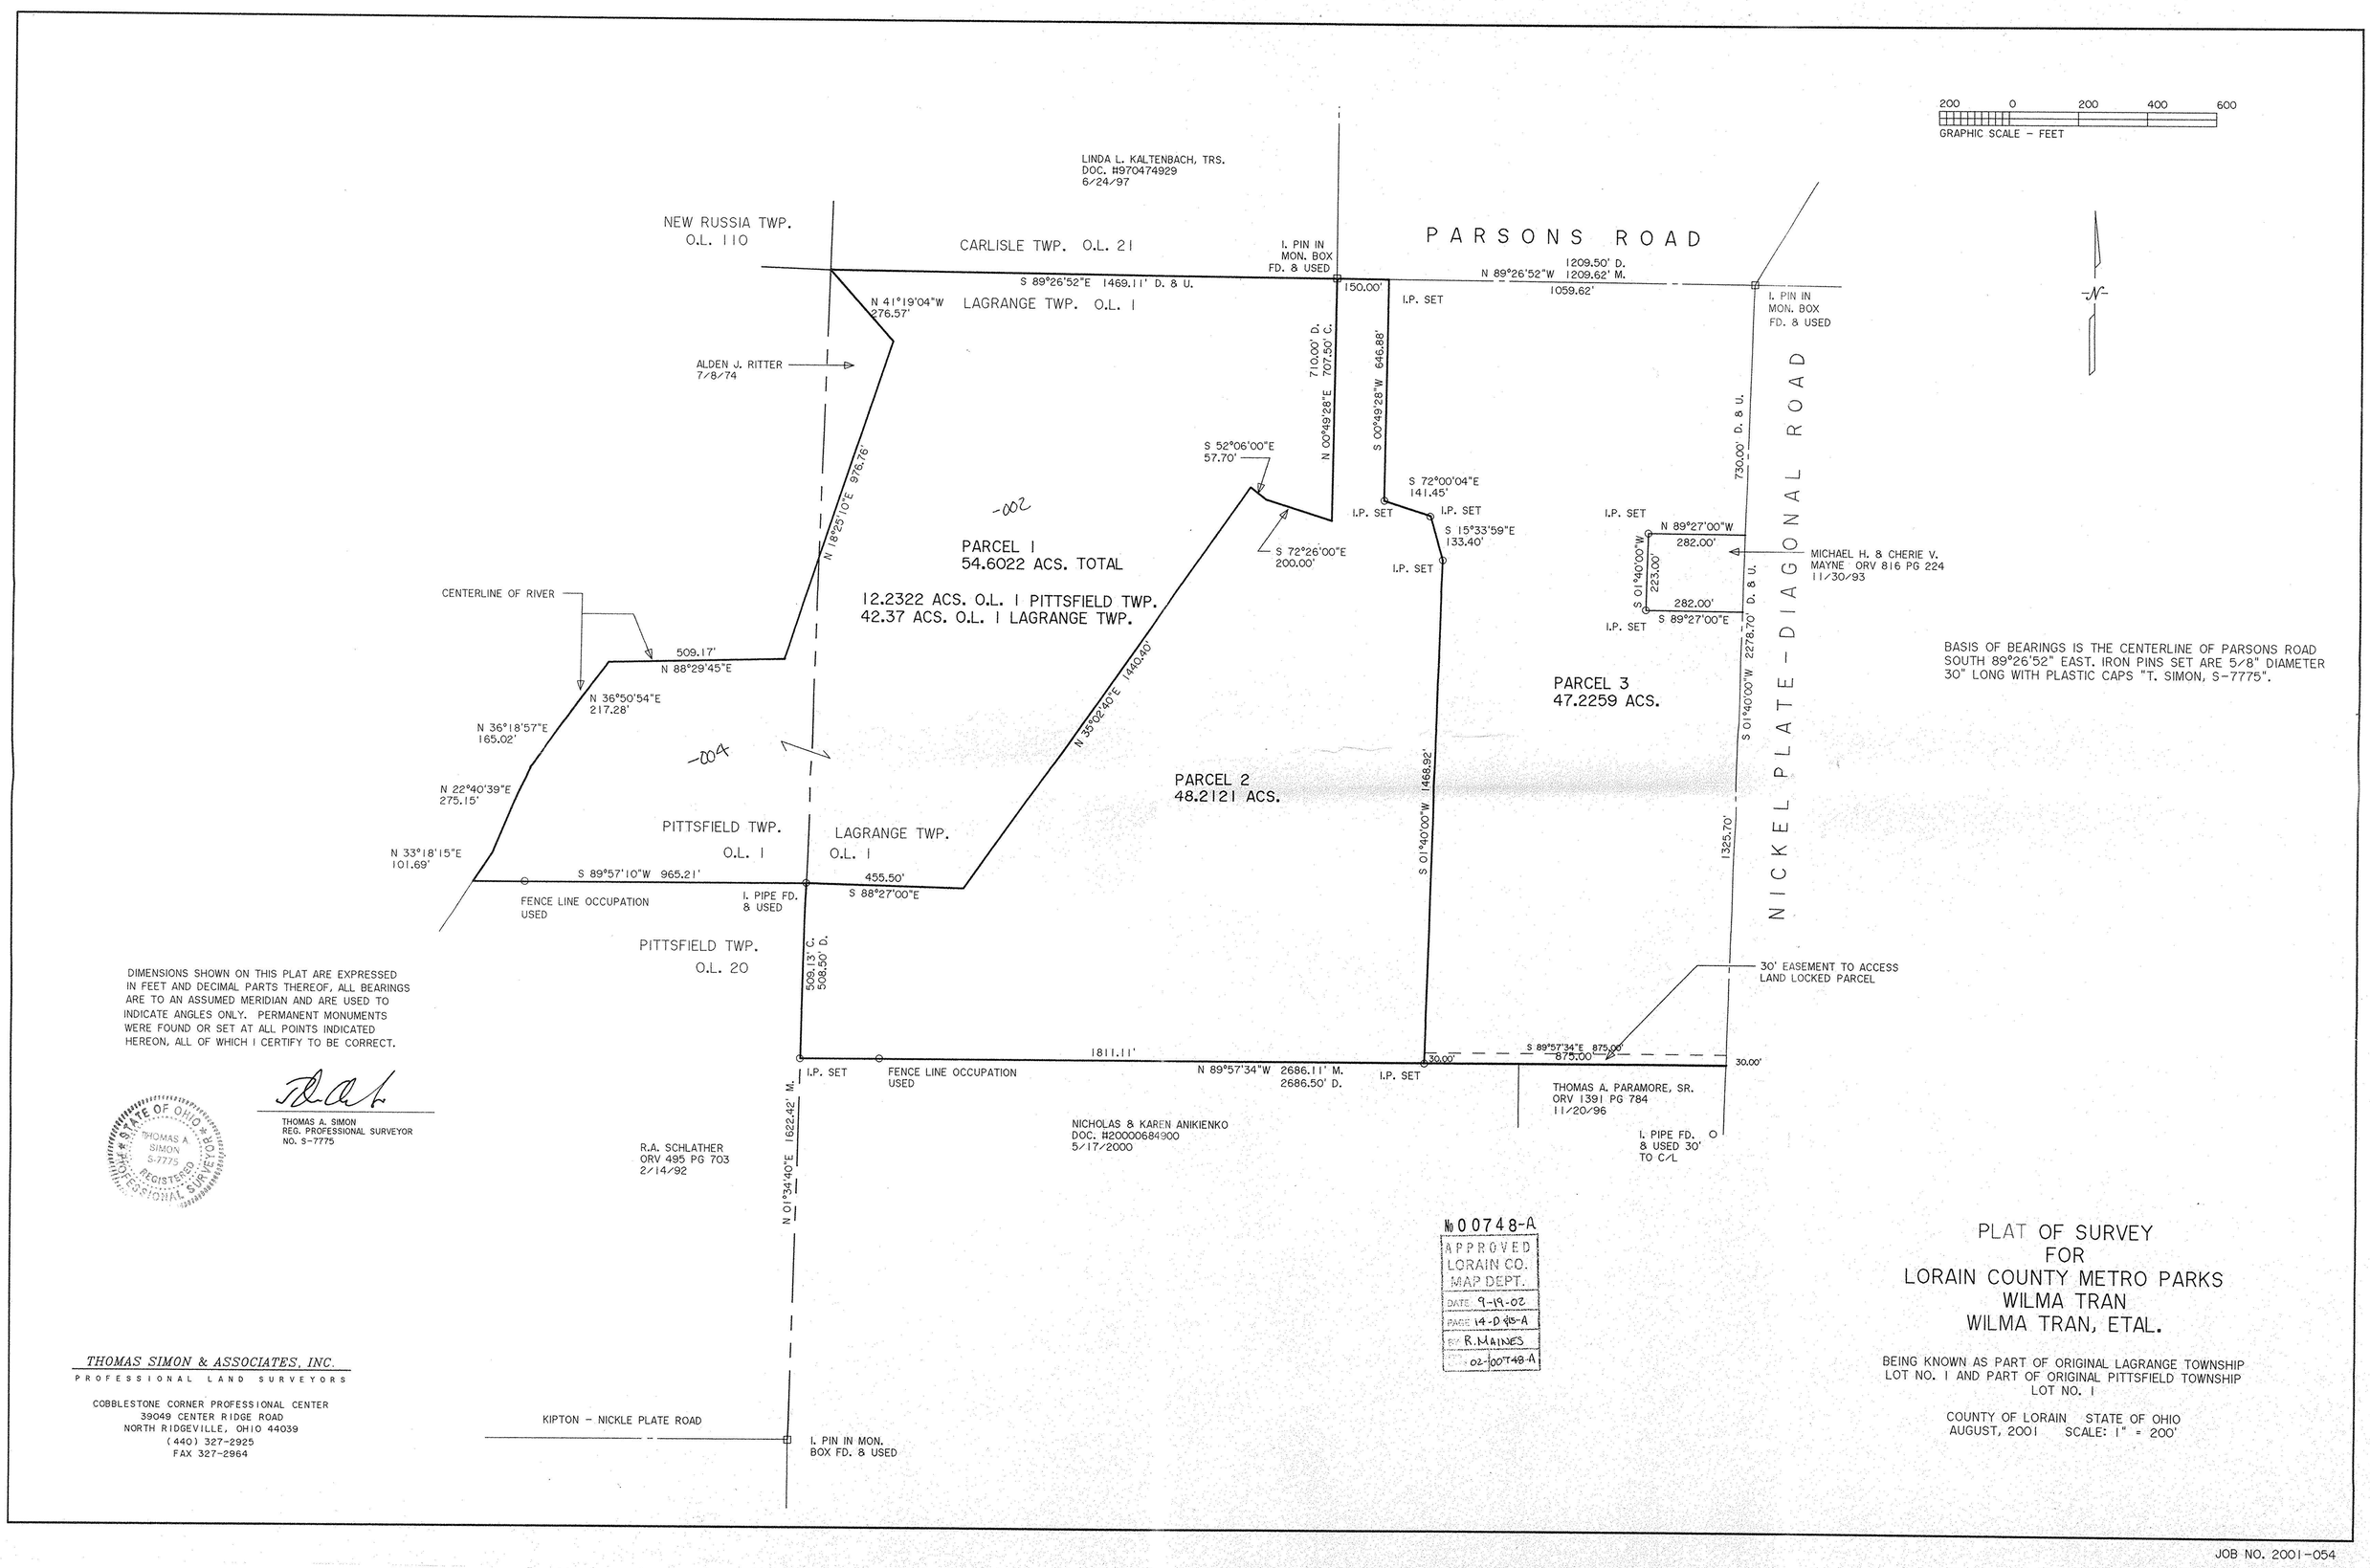


No 00748-A
APPROVED
LORAIN CO.
MAP DEPT.
DATE 9-19-02
PAGE 14-D & 15-A
BY R. MAINES
02-100T48-A

JOB NO. 2001-054