14-00-004-000-007, -010 thru -012

MAP OF SURVEY, LOT SPLIT AND ASSEMBLY

PREPARED FOR

L. AND D. ENTERPRISES

SITUATED IN THE TOWNSHIP OF PITTSFIELD, COUNTY OF LORAIN, STATE OF OHIO AND BEING KNOWN AS PART OF ORIGINAL PITTSFIELD TOWNSHIP LOTS 4 AND 17

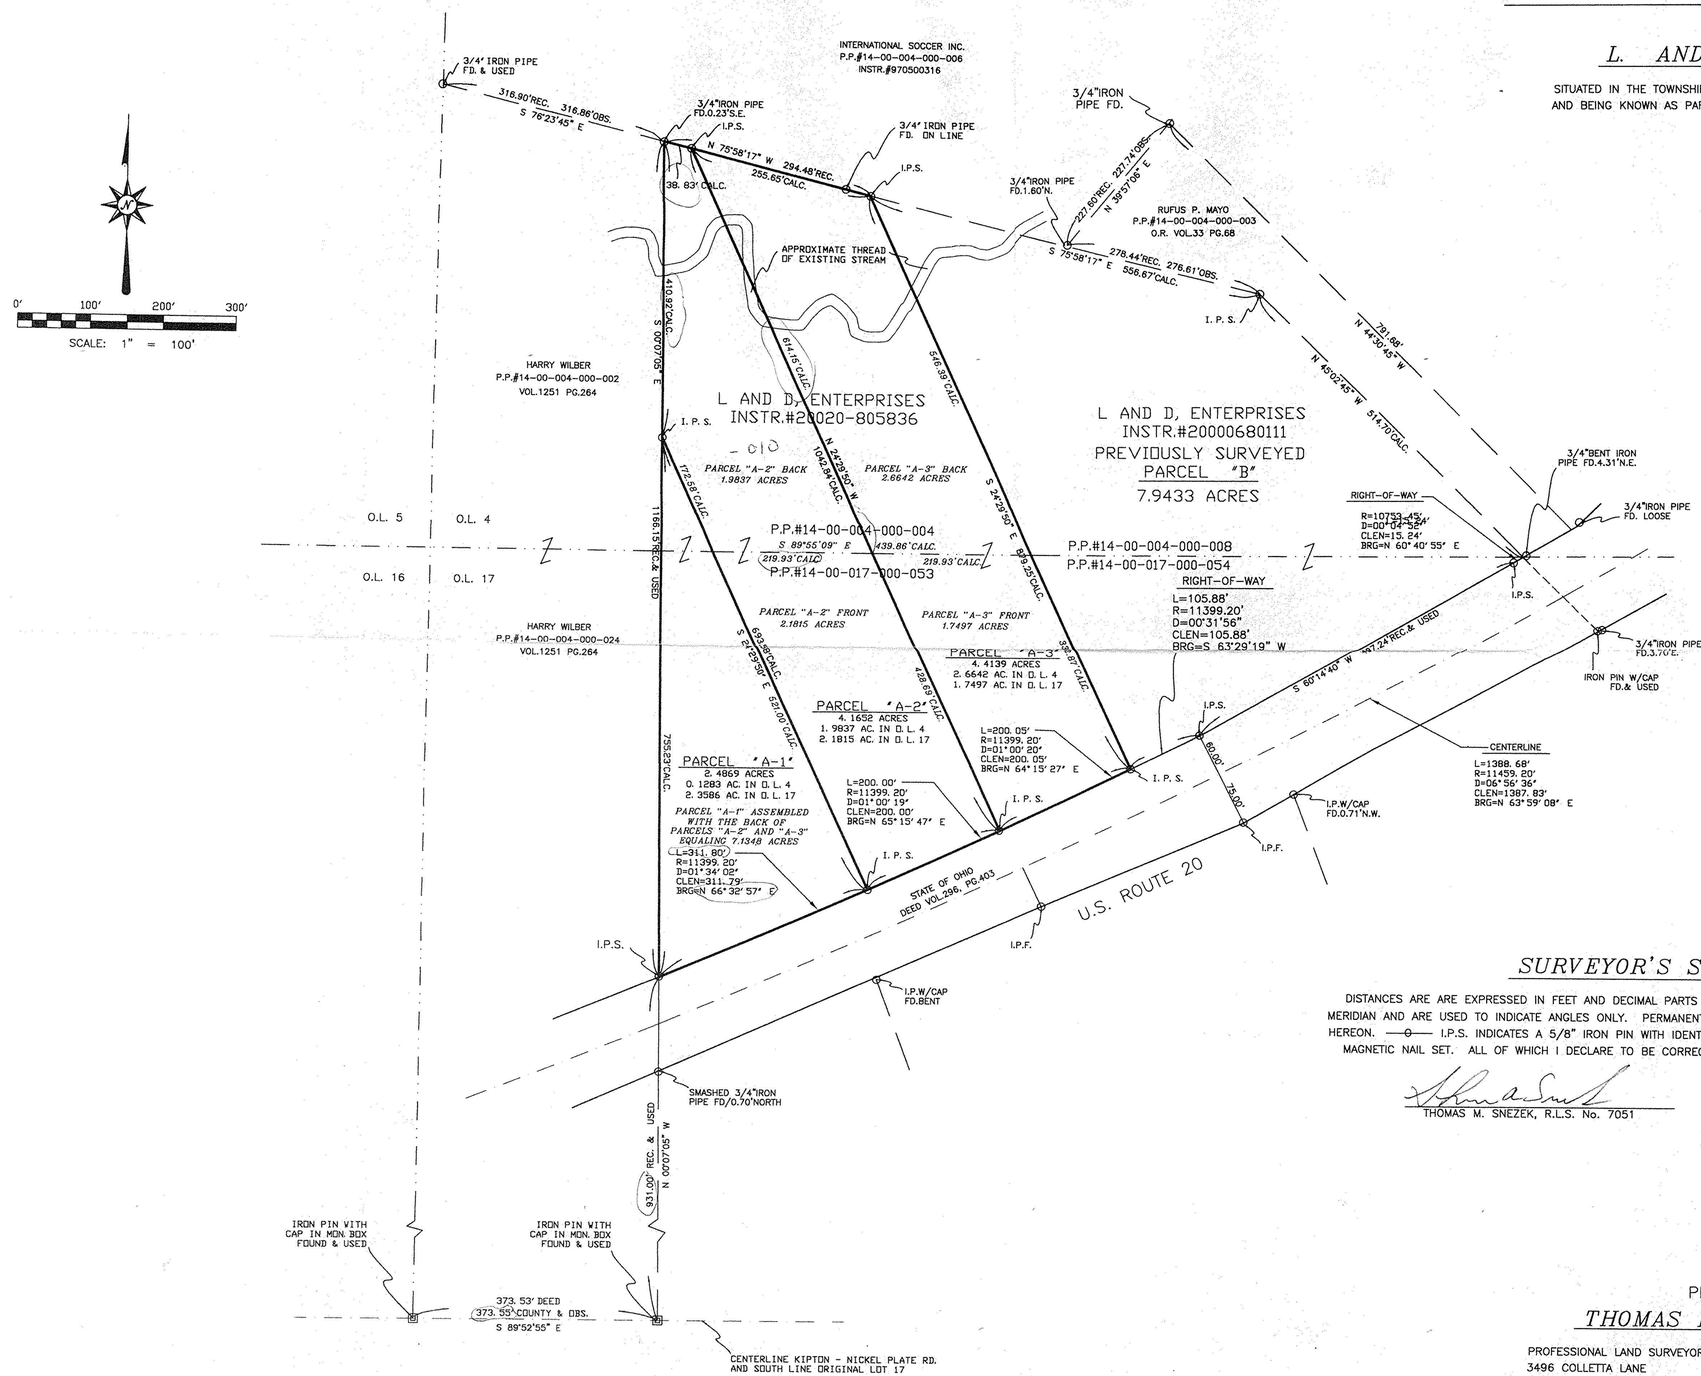

SURVEYOR'S STATEMENT

DISTANCES ARE ARE EXPRESSED IN FEET AND DECIMAL PARTS THEREOF. BEARINGS ARE BASED AN ASSUMED MERIDIAN AND ARE USED TO INDICATE ANGLES ONLY. PERMANENT MONUMENTS WERE FOUND OR SET AS INDICATED HEREON. —o— I.P.S. INDICATES A 5/8" IRON PIN WITH IDENTIFICATION CAP SET. —o— M.N.S. INDICATES A MAGNETIC NAIL SET. ALL OF WHICH I DECLARE TO BE CORRECT TO THE BEST OF MY ABILITY AND BELIEF.

THOMAS M. SNEZEK, R.L.S. No. 7051

STATE OF OHIO THOMAS M. SNEZEK S-7051 SURVEYOR

4-26-02
DATE

№ 01115

APPROVED
LORAIN CO.
MAP DEPT.
DATE 6-18-02
PAGE 14-C
BY J Hatfield
№ 02-0115

PREPARED BY:

THOMAS M. SNEZEK, P.S.

PROFESSIONAL LAND SURVEYOR NO. 7051
3496 COLLETTA LANE
(216) 671-4902

DATE: 1/29/02
CLEVELAND, OHIO
44111

REVISED 4-25-02
PROJECT NO. 0111