




LAUNDON . SIMON . CAHL & ASSOC. INC.
CONSULTING ENGINEERS & SURVEYORS
219 COURT ST. ELYRIA, OHIO 44035

SURVEY FOR:

DAVID R. & LAURA J. WICKES

Orig. Lot 23	City of	Date JULY 22, 1987 Scale 1"=100'
Orig. Sec	Village of	Dwn. by R.G.S. Chkd. by C.J.
Tract	County of LORAIN	Job No. 87-1626 F.B.
Township of PITTSFIELD	State of OHIO	Printed

KIPTON-NICKLE PLATE RD. 60'

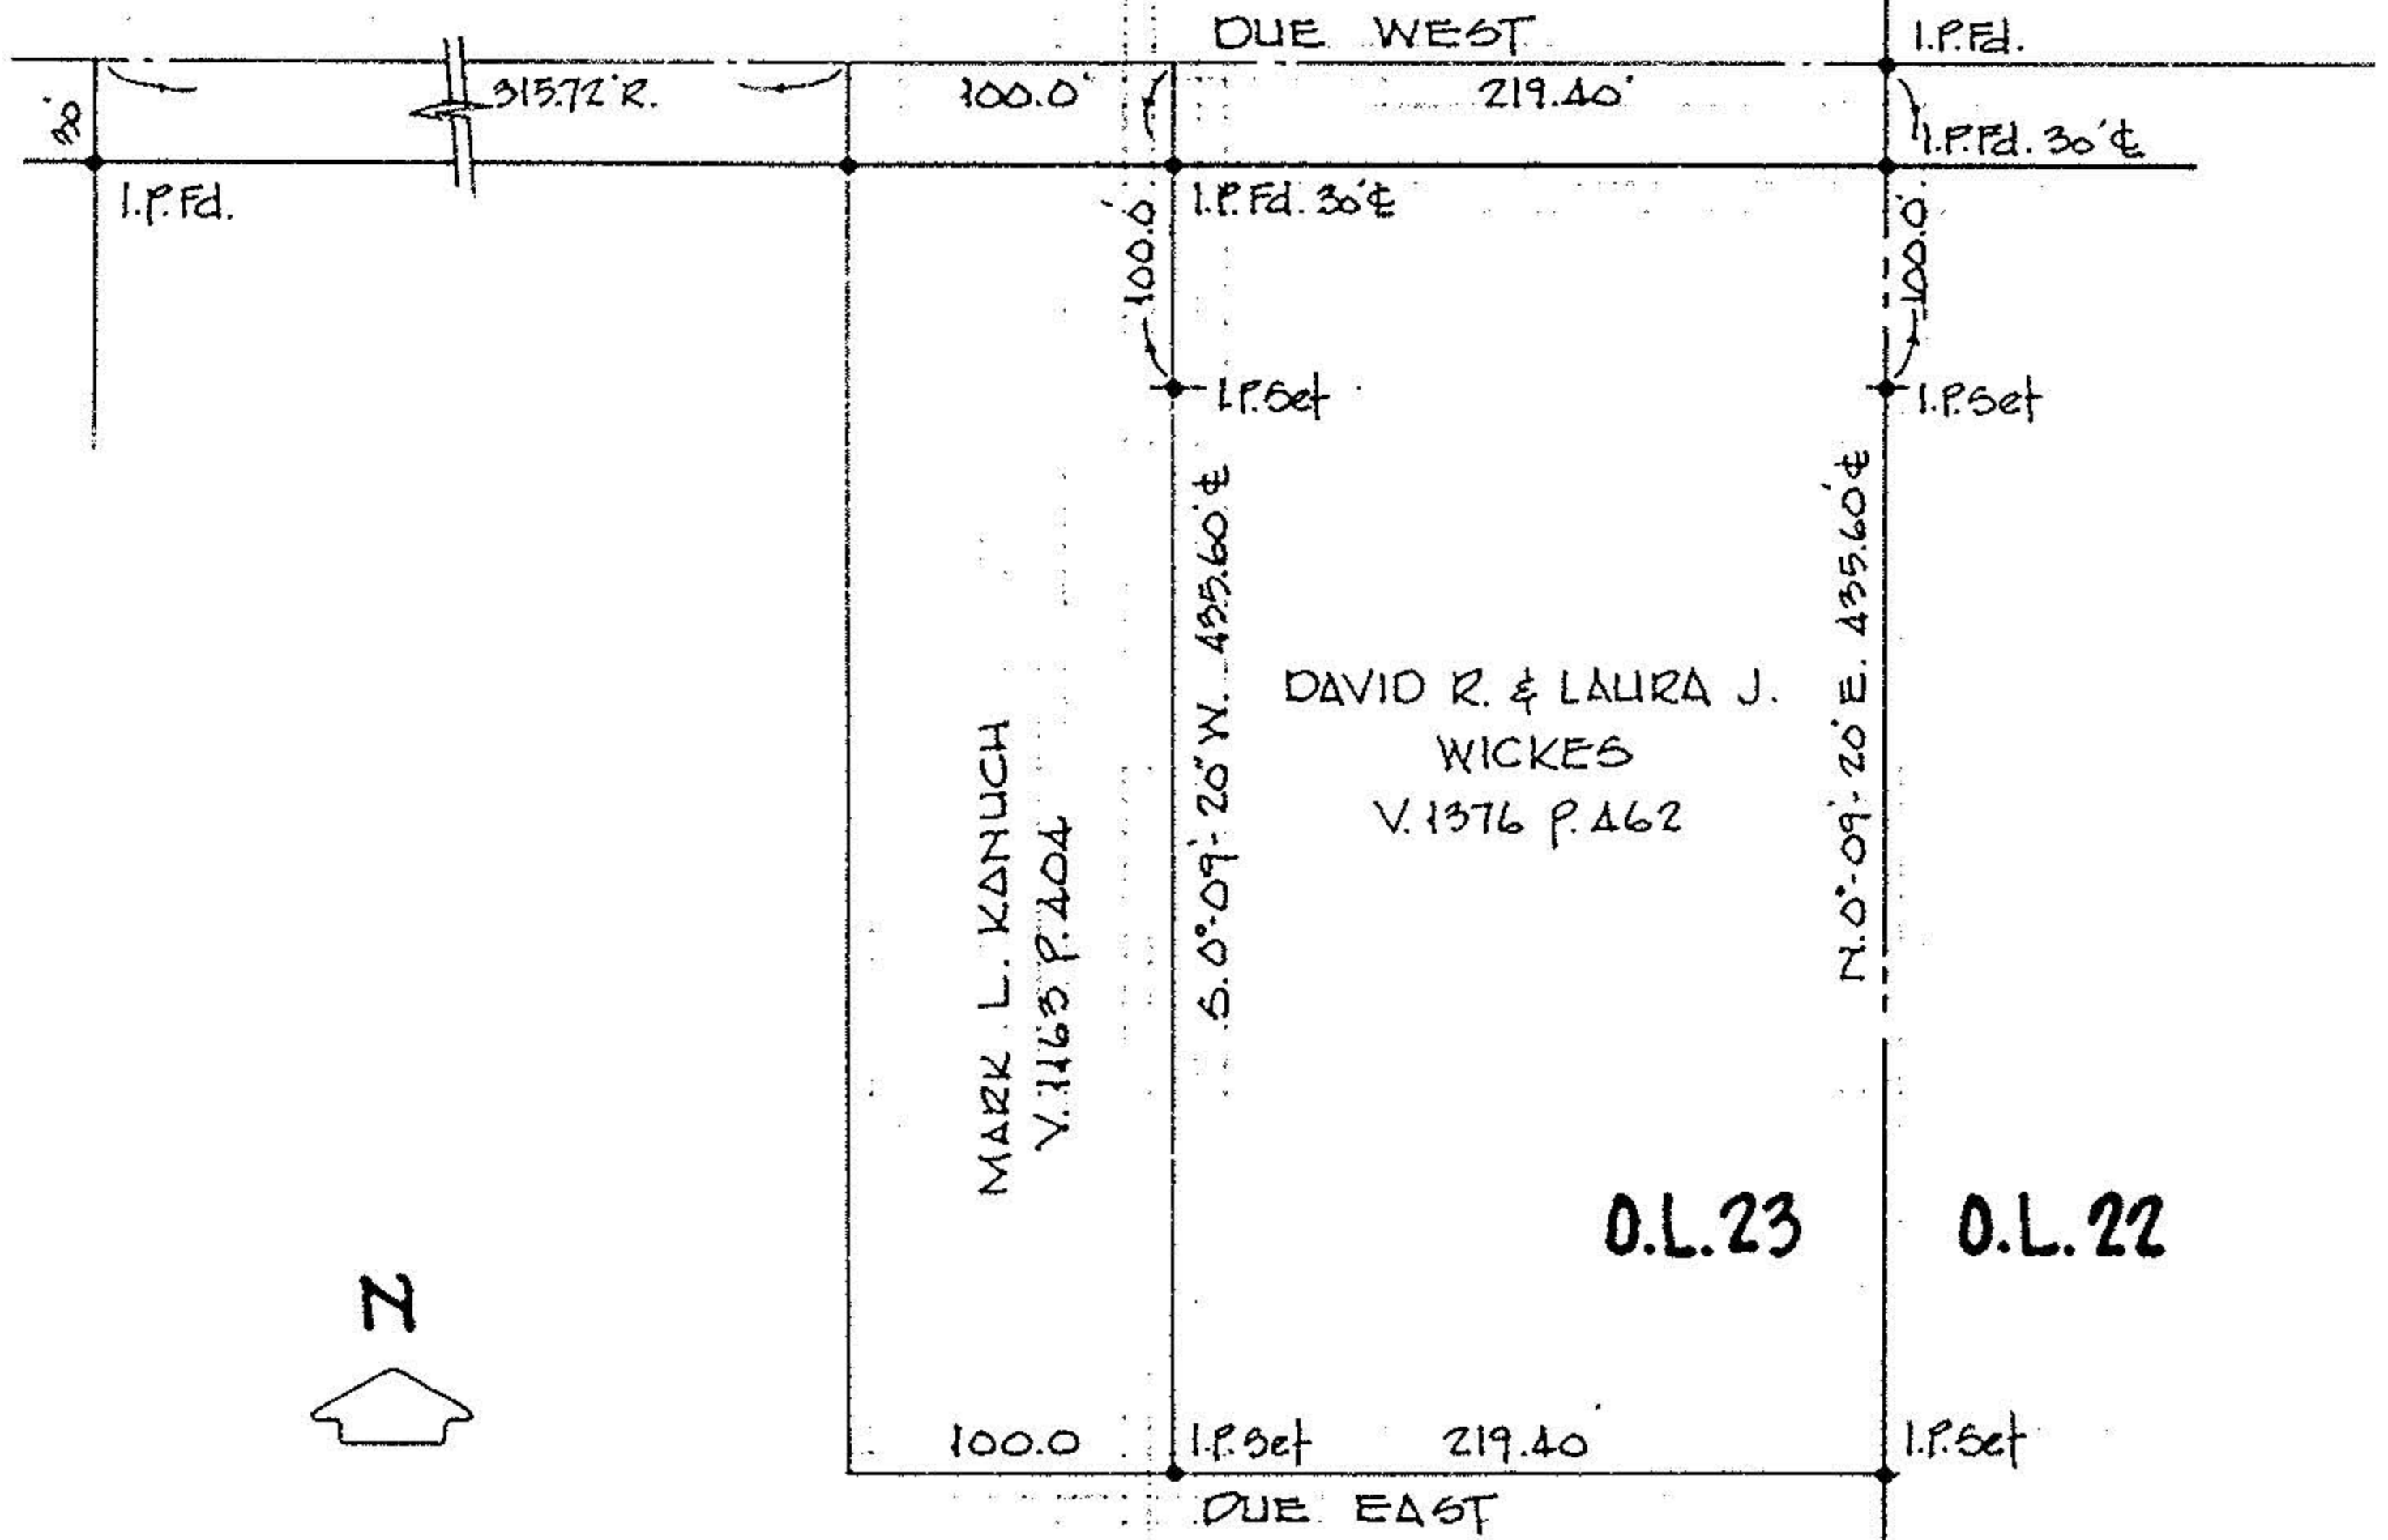

MARK L. KANUCH
V. 1163 P. 404

DAVID R. & LAURA J.
WICKES
V. 1376 P. 462

O.L. 23

O.L. 22