



LAUNDON • SIMON • CAHL & ASSOC., INC.
 CONSULTING ENGINEERS & SURVEYORS
 110 MIDDLE AVE., ELYRIA, O. 44035

SURVEY FOR:

ROBT. A & BRENDA D. HANMEK

Orig. Lot 16	City of	Date AUG. '94 Scale 1"=100'
Orig. Sec	Village of	Dwn. by R.G.S. Chkd. by R.C.
Tract	County of LORAIN	Job No. 94-2575 F.B. 233/34
Township of PITTSFIELD	State of OHIO	Printed

N. LINE O.L. 16

I.P. Used.

610.80 ±

I.P. Set

N. 88°-20'-12" E

I.P. Set

254.07'

0.8710 AC.

150.00'

150.00'

I.P. Pd.

252.06'

I.P. Pd.

S. 88°-19'-20" W.

DAVID L. HANMEK - TRUSTEE
 O.R.V. 918 P. 864
 857

N. 0°-19'-00" W.

HARRY WILBER
 D.V. 1026 P. 977
 SURVEY OF MAY '71

492.80'


ROBT. A. & BRENDA
 D. HANMEK

D.V. 1016 P. 601

SURVEY OF NOV. '70

N. 0°-27'-00" E.

377.13'

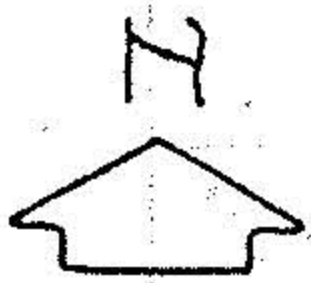

Arc = 254.48' Δ = 1°-16'-46"
 Ch. = 254.47' S. 75°-39'-17" W.

I.P. Used

I.P.

20 NORWALK-KIPTON EAST RD.