14-B

14-00-066-000-

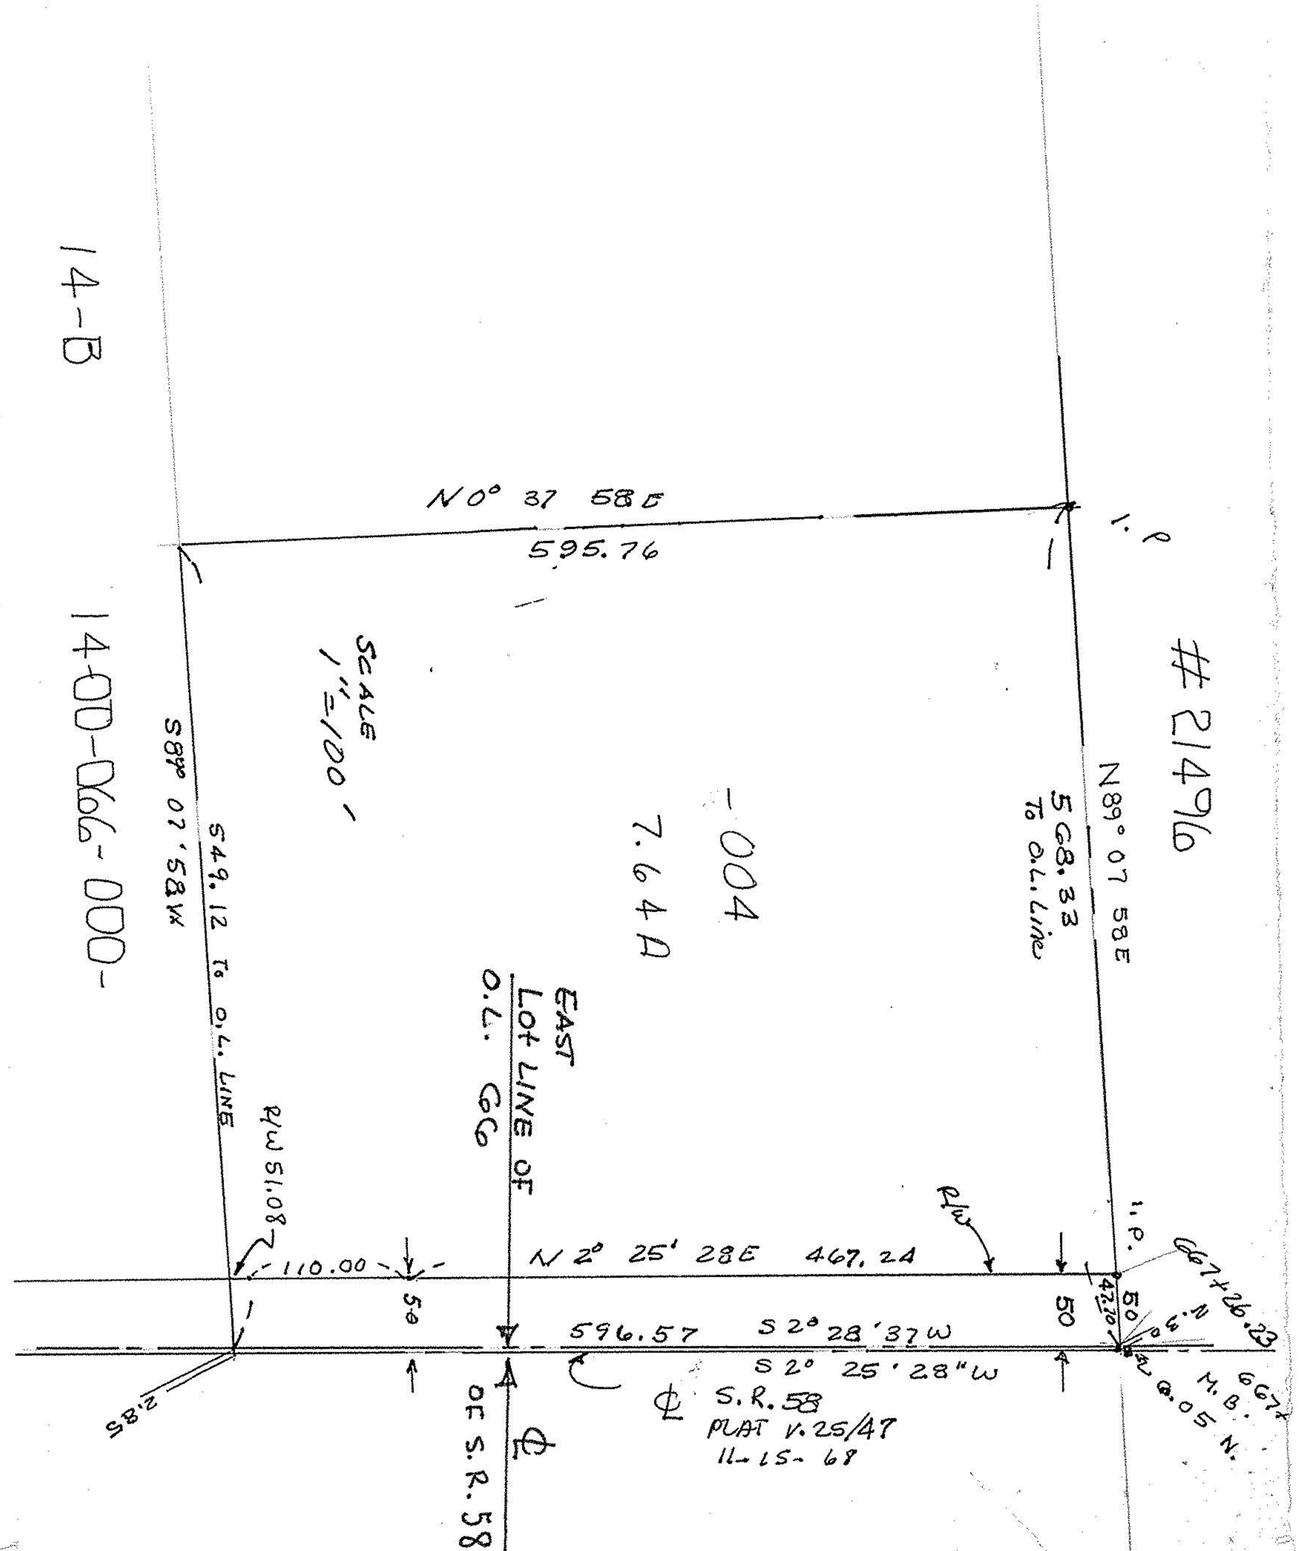

21496

LAUNDON • SIMON • CAHL and ASSOC.
ENGINEERS SURVEYORS
504 MIDDLE AVE. ELYRIA, OHIO 4035

APPROVED
LORAIN CO.
MAP DEPT

FOR: CHALMER MOSHER

DATE 9-20-95

TOWNSHIP PITTSFIELD	VILLAGE	DATE 12.17.79	PAGE 14-B
ORIG. LOT or SEC. 66	COUNTY LORAIN	SCALE 1"=100'	
CITY	STATE OHIO	JOB NO. 79-931	F.B. 135/67

BY Carol Franels

#21496

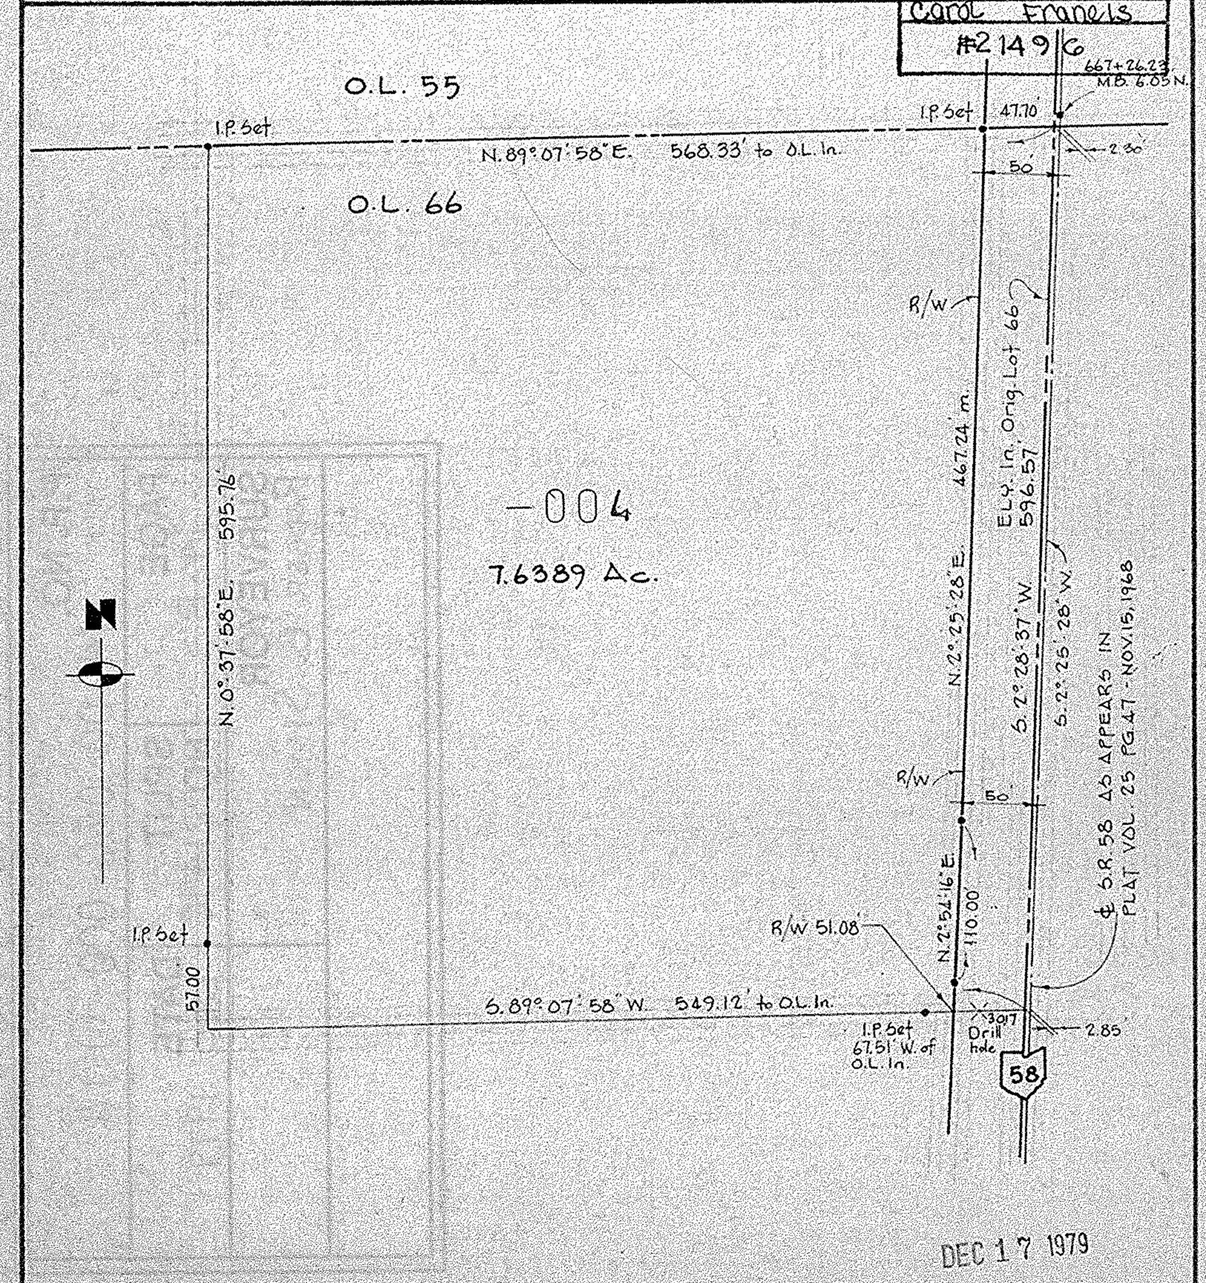

DEC 17 1979