PLAT OF SURVEY AND PARTITION

PREPARED FOR THE ESTATE OF

MARGARET M. BENO

IN THE TOWNSHIP OF PITTSFIELD, COUNTY OF LORAIN, AND STATE OF OHIO, AND KNOWN AS BEING A PART OF ORIGINAL PITTSFIELD TOWNSHIP LOT NO. 58.

JUNE 25, 1997

SCALE : 1" = 50'

50 30 10 0 25 50

#22337

APPROVED
LORAIN CO.
MAP DEPT

DATE 10/30/97

PAGE 14-C

BY K. Colbert

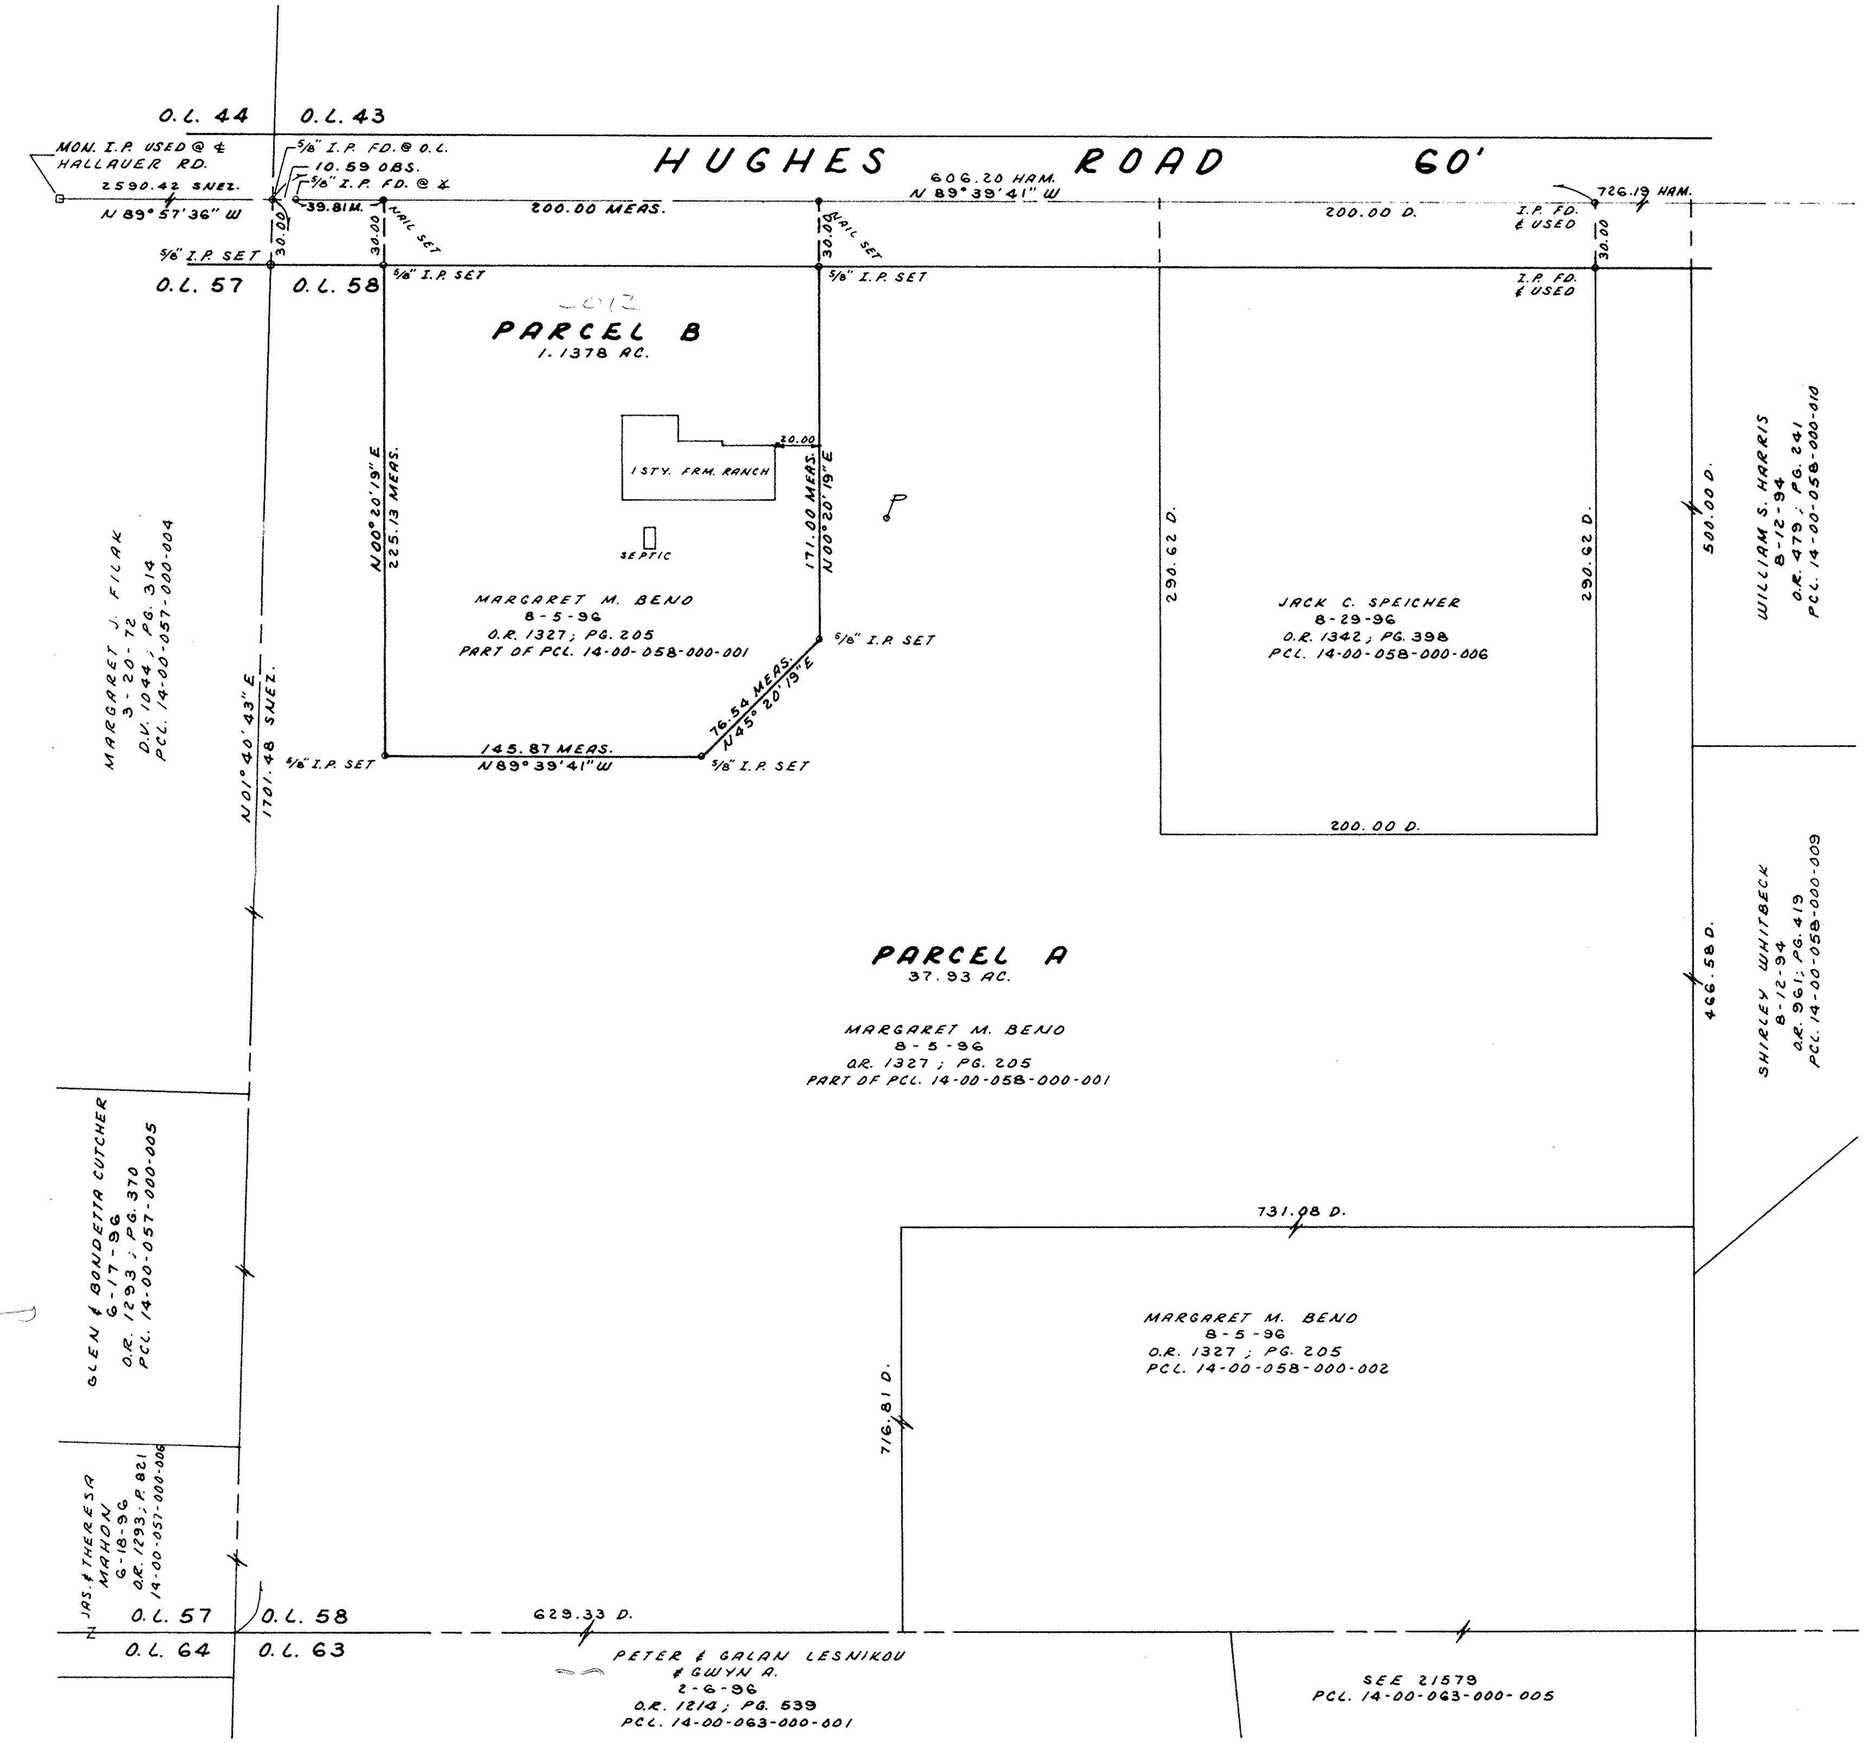

THIS PLAT WAS PREPARED FROM A FIELD SURVEY DONE UNDER MY DIRECTION AND CONFORMS TO THE MINIMUM STANDARDS FOR BOUNDARY SURVEYS IN THE STATE OF OHIO. BEARINGS ARE TO AN ASSUMED MERIDIAN AND ARE INTENDED TO DENOTE ANGLES ONLY. DISTANCES ARE GIVEN IN FEET AND DECIMAL PARTS THEREOF. ALL OF WHICH I ACKNOWLEDGE TO BE CORRECT.

David J. Bruckner

DAVID J. BRUCKNER, P.S.
REGISTERED OHIO PROFESSIONAL
SURVEYOR NO. 6939

STATE OF OHIO
DAVID J. BRUCKNER
6939
REGISTERED
PROFESSIONAL
SURVEYOR

DAVID J. BRUCKNER
4270 WEST 182ND ST
CLEVELAND, OHIO 44135
PH. 216-941-0720

OWNER'S ACCEPTANCE:

I, THE UNDERSIGNED EXECUTOR FOR THE ESTATE OF MARGARET M. BENO, DO HEREBY ACCEPT THIS PLAT AND PARTITION OF THE LAND SHOWN HEREON.

John Beno Exec

JOHN T. BENO, EXECUTOR