DIMENSIONS SHOWN ON THIS PLAT ARE EXPRESSED IN FEET AND DECIMAL PARTS THEREOF, ALL BEARINGS ARE TO AN ASSUMED MERIDIAN AND ARE USED TO INDICATE ANGLES ONLY. PERMANENT MONUMENTS WERE FOUND OR SET AT ALL POINTS INDICATED HEREON, ALL OF WHICH I CERTIFY TO BE CORRECT.

THOMAS A. SIMON
REG. PROFESSIONAL SURVEYOR
NO. S-7775

BASIS OF BEARINGS IS THE CENTERLINE OF HUGHES ROAD (NORTH 89°34'50"EAST). IRON PINS SET ARE 5/8" DIAMETER, 30" LONG WITH PLASTIC CAPS "T. SIMON,S-7775".

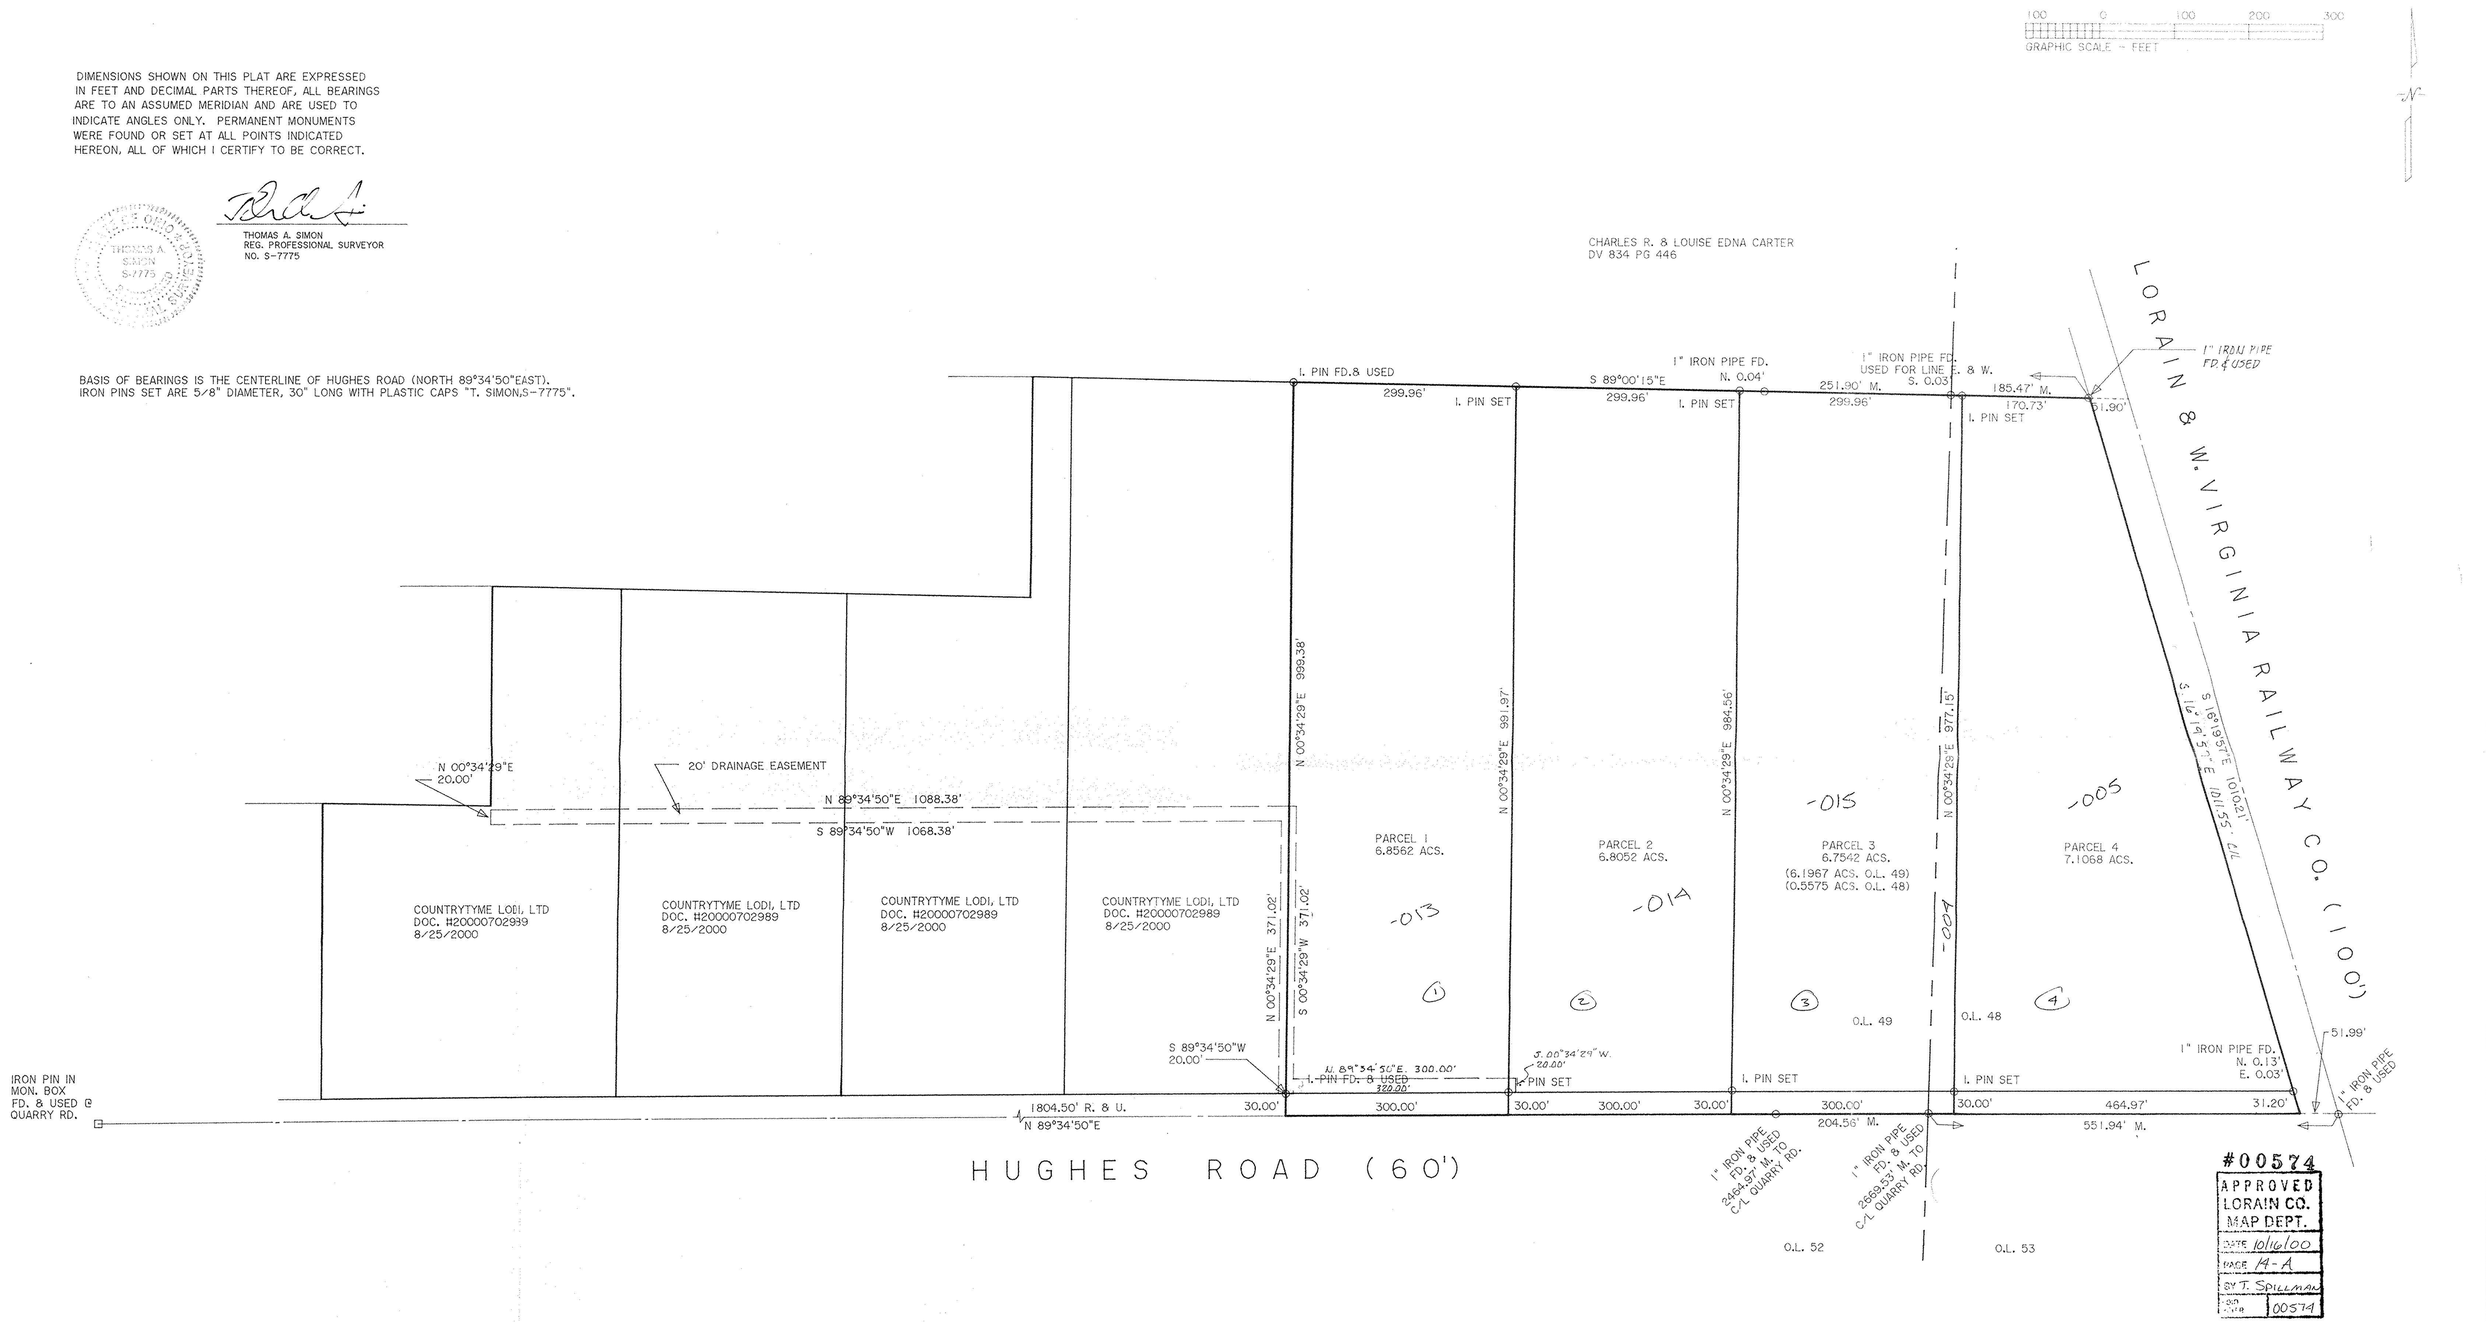

#00574
APPROVED
LORAIN CO.
MAP DEPT.
DATE 10/16/00
PAGE 14-A
BY T. SPILLMAN
JOB NO. 00574

PLAT OF SURVEY AND SPLIT
FOR
COUNTRYTYME LODI, LTD.

BEING KNOWN AS PARTS OF ORIGINAL LOT NOS. 48 AND 49 OF PITTSFIELD TOWNSHIP

COUNTY OF LORAIN STATE OF OHIO

SEPTEMBER, 2000 SCALE: 1" = 100'

THOMAS SIMON & ASSOCIATES, INC.
PROFESSIONAL LAND SURVEYORS

COBBLESTONE CORNER PROFESSIONAL CENTER
39049 CENTER RIDGE ROAD
NORTH RIDGEVILLE, OHIO 44039
(440) 327-2925
FAX 327-2964

JOB NO. 2000-041