


14-00-030-


NORTH
SCALE 1"=100'

JOHN SCHLICHTERLE + ELFRIEDE
SCHLICHTERLE O.R. VOL. 157 P. 246

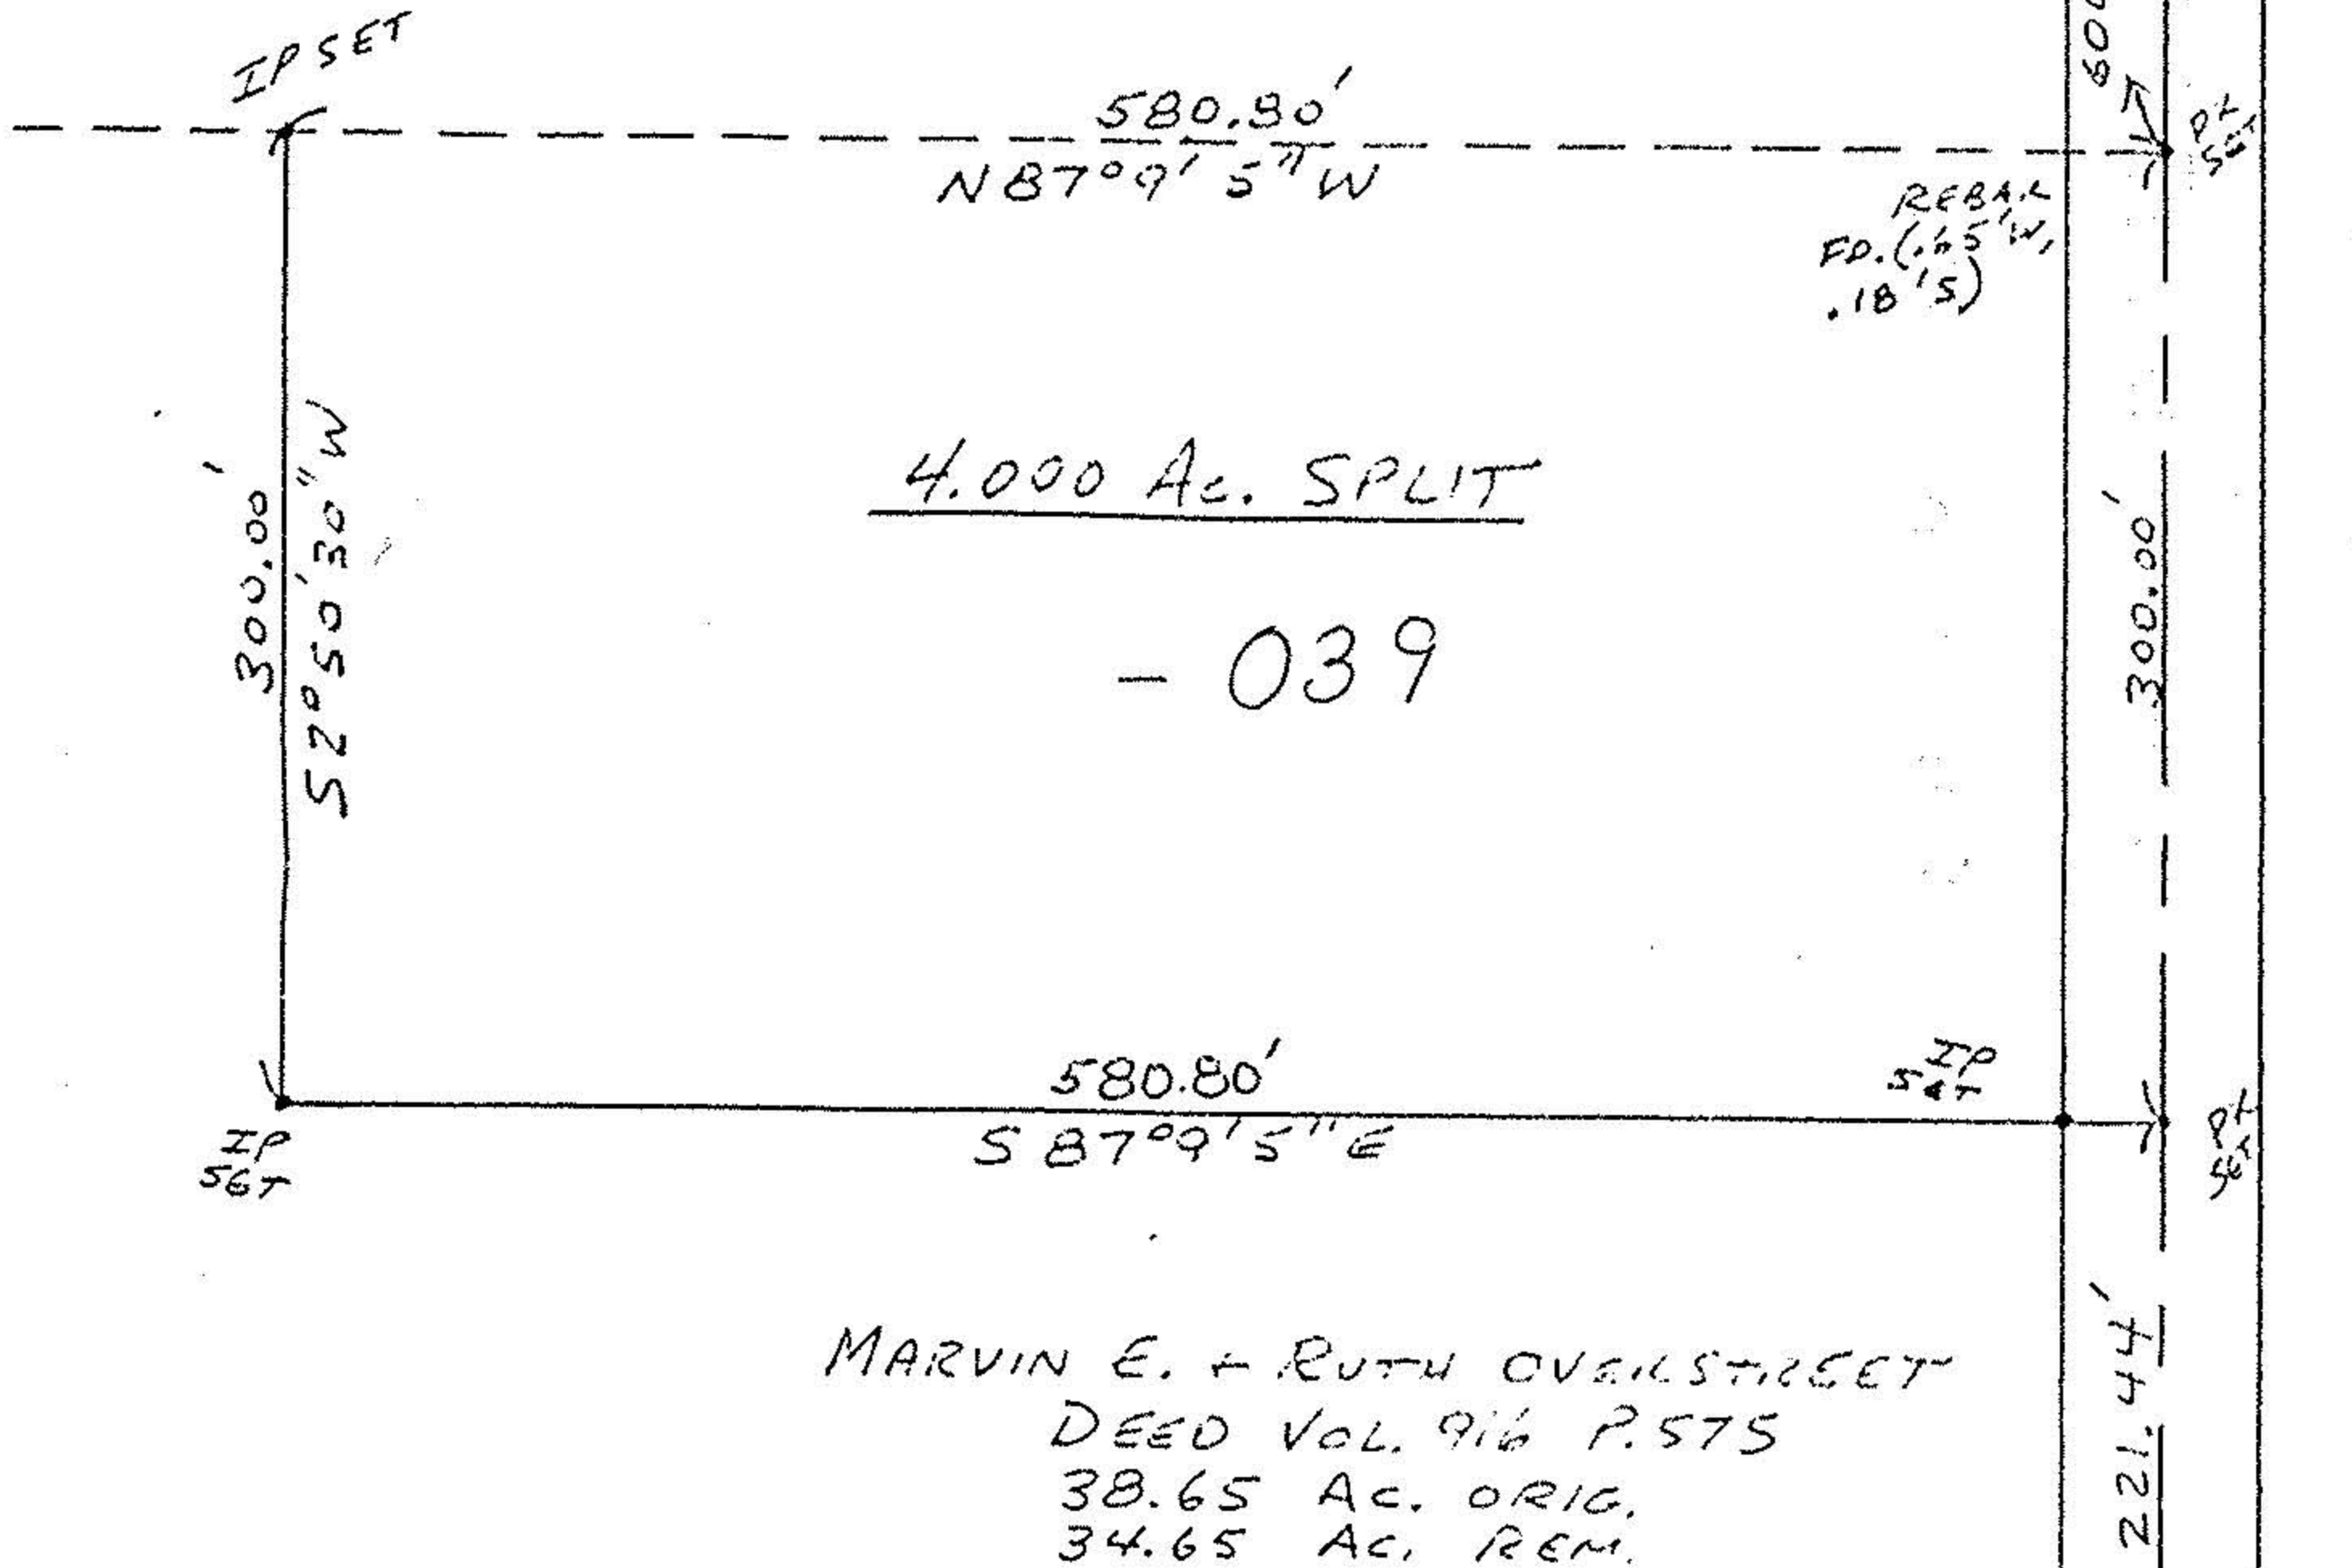

18595

APPROVED LORAIN CO. MAP DEPT
DATE 8-24-89
PAGE 14-A
BY CAROLYN FRANCS
18595

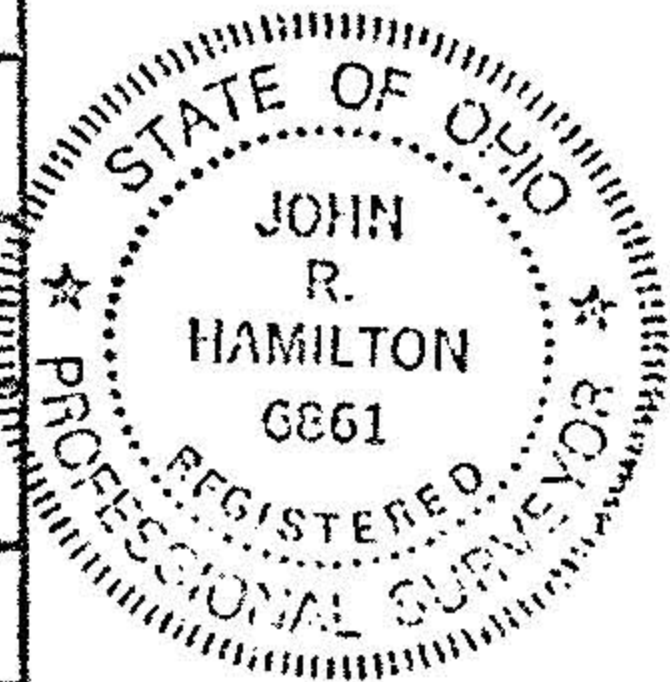

0.L. 30
0.L. 31
KIPTON-NICKLE PLATE R.O.
(45') VACATED

MAP OF SURVEY FOR M. OVERSTREET
O.L. #30 - PITTSFIELD TWP - LORAIN CO.
AUG. 1989 SCALE 1"=100'
JOHN R. HAMILTON REG. SURV. #6861