


6163

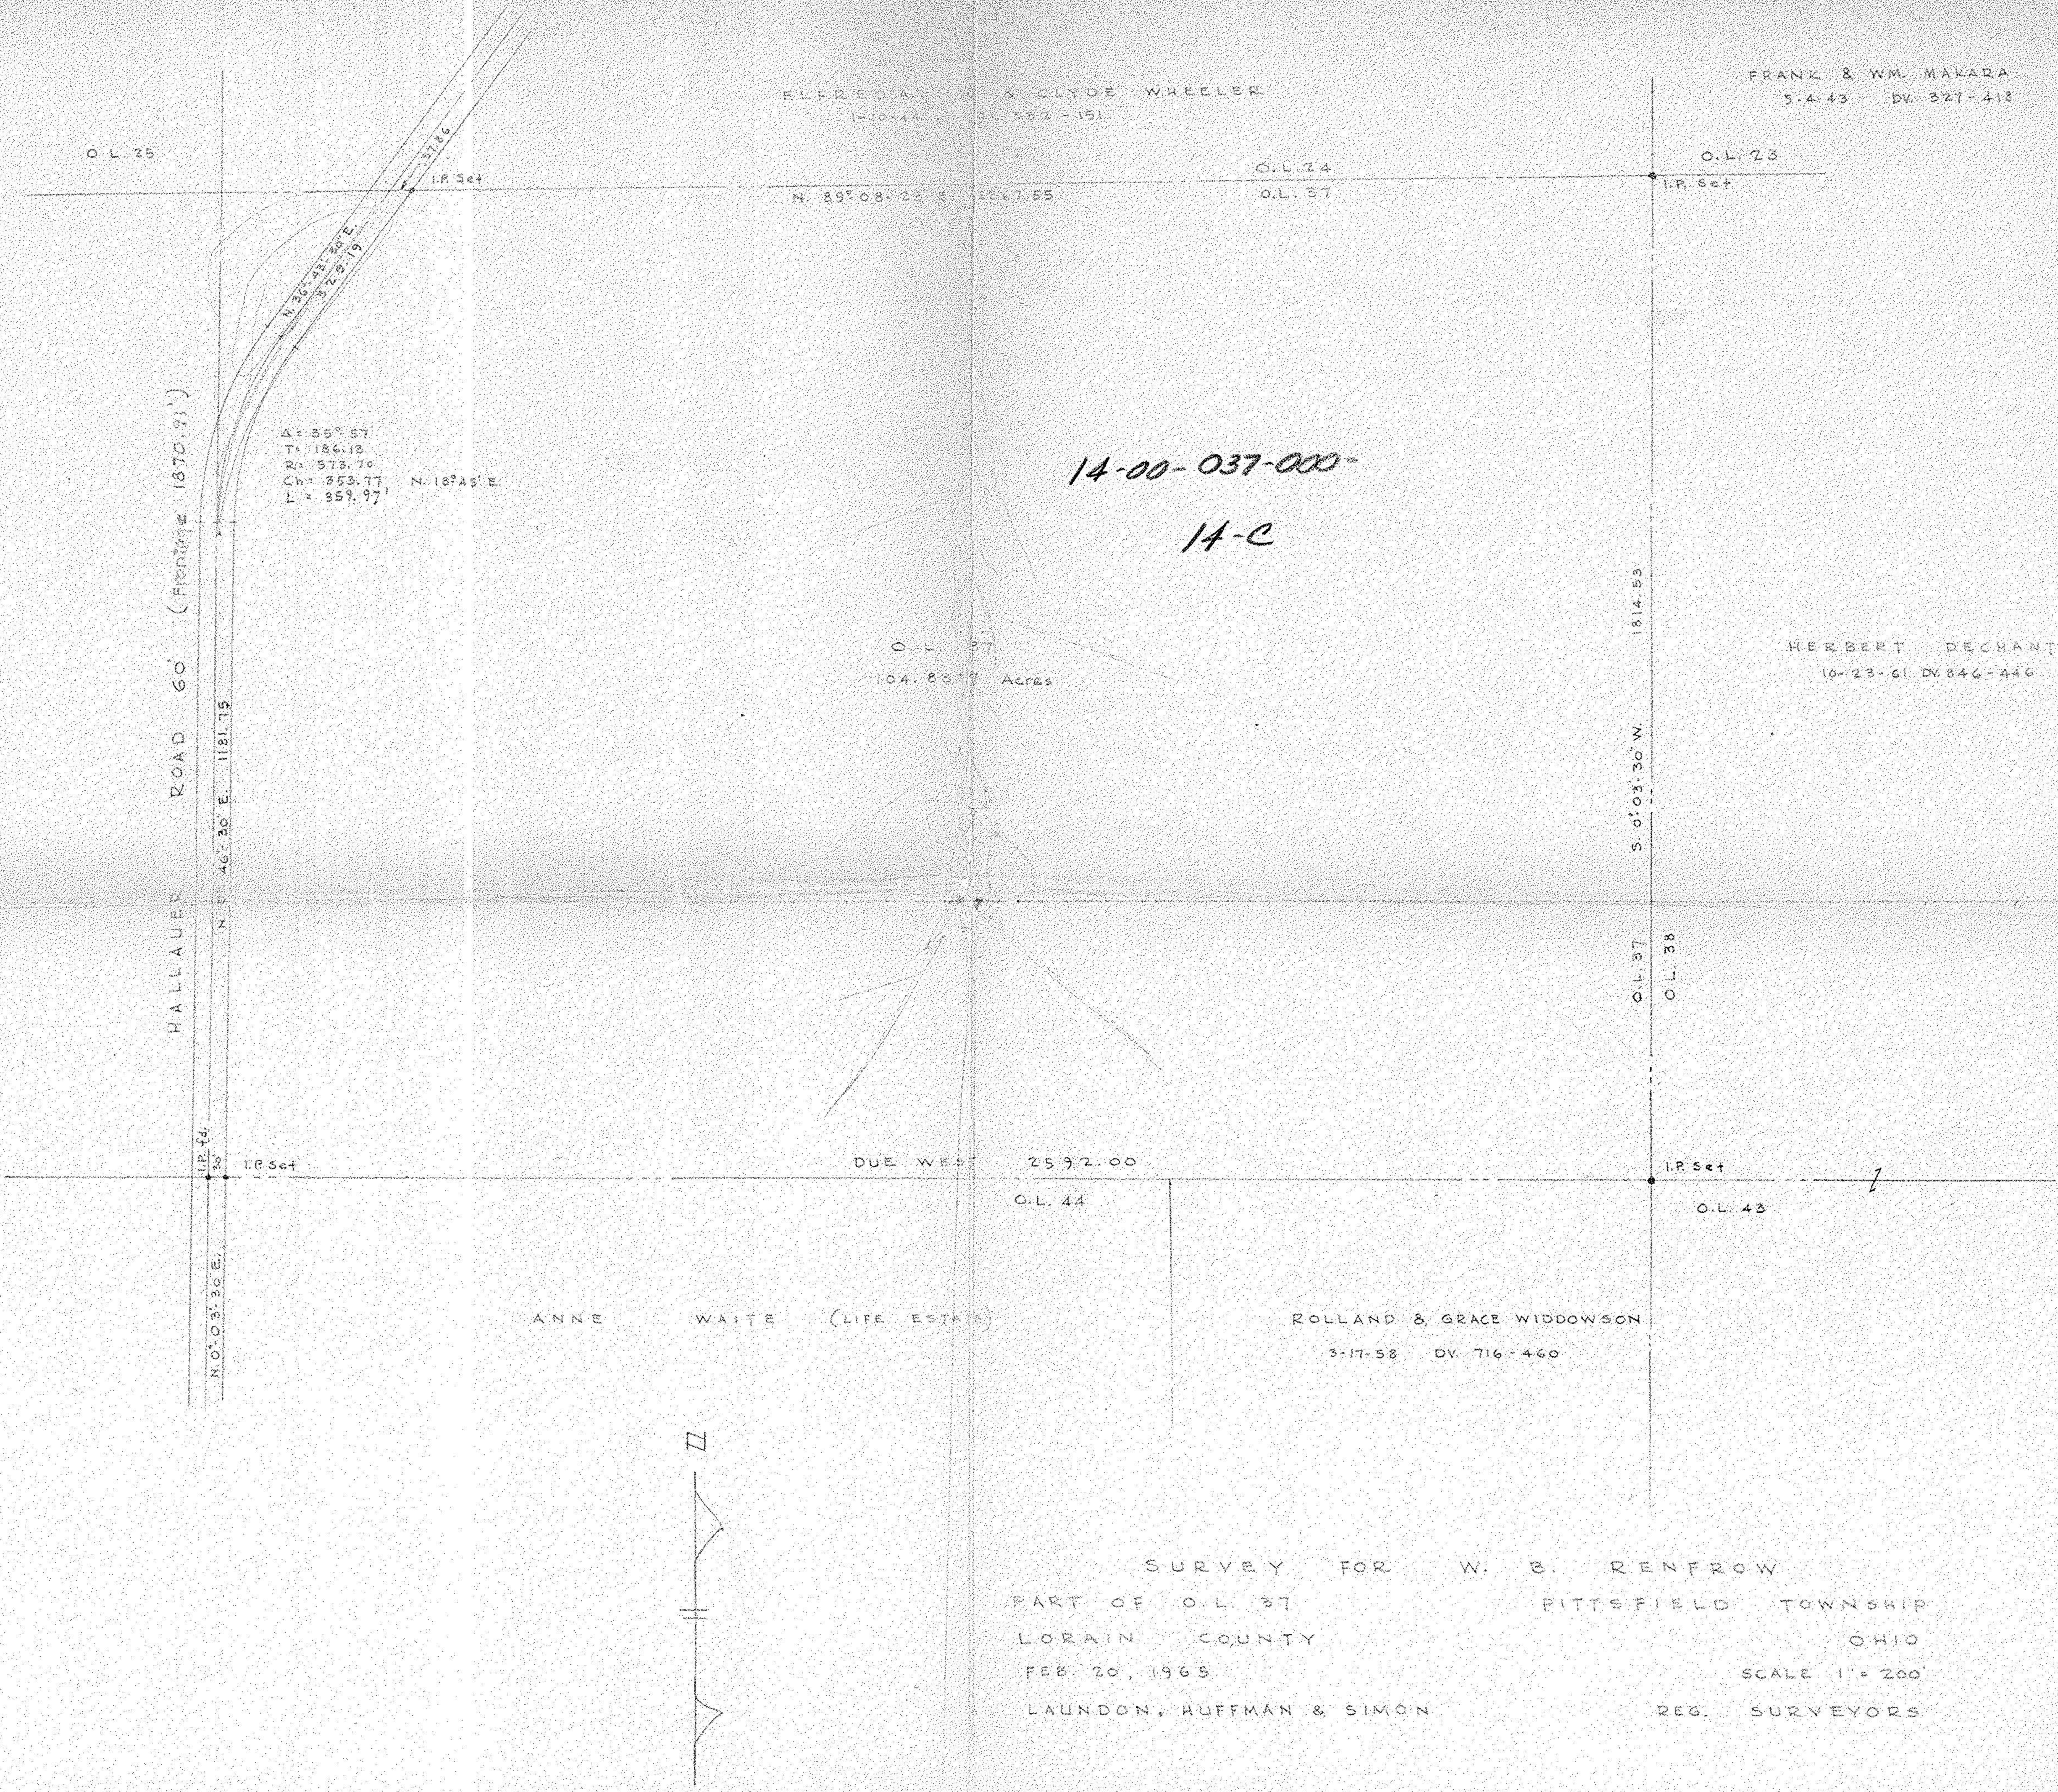

ALFRED A. WHEELER & CLYDE WHEELER
1-10-44 DV 732-151

FRANK & WM. MAKADA
5-4-43 DV 327-418

14-00-037-000-
14-C

O.L. 57

HERBERT DECHANT
10-23-61 DV 846-446

DUE WEST 2592.00
O.L. 44

ANNE WAITE (LIFE ESTATE)

ROLLAND & GRACE WIDDOWSON
3-17-58 DV 716-460

SURVEY FOR W. B. RENFROW
PART OF O.L. 37 PITTSFIELD TOWNSHIP
LORAIN COUNTY OHIO
FEB. 20, 1965 SCALE 1" = 200'
LAUNDON, HUFFMAN & SIMON REG. SURVEYORS

Δ = 25° 57'
T = 156.12
R = 573.70
Ch = 253.77
L = 359.97'
N 18° 48' E

HALLAUER ROAD 60' (FRONTAGE 1870.91')

N 0° 46' 30" E 1181.15
I.P. Set
N 0° 03' 30" E

S 0° 03' 30" W 1814.53
O.L. 37
O.L. 38

I.P. Set
O.L. 42

O.L. 25

O.L. 24
O.L. 27

O.L. 23
I.P. Set

