MAP OF SURVEY, LOT SPLIT & ASSEMBLY

PREPARED FOR

ROBERT D. BRASEE

SITUATED IN THE TOWNSHIP OF BRIGHTON, COUNTY OF LORAIN, STATE OF OHIO AND BEING KNOWN AS PART OF ORIGINAL BRIGHTON TOWNSHIP LOT 23 & 24, TRACT 8

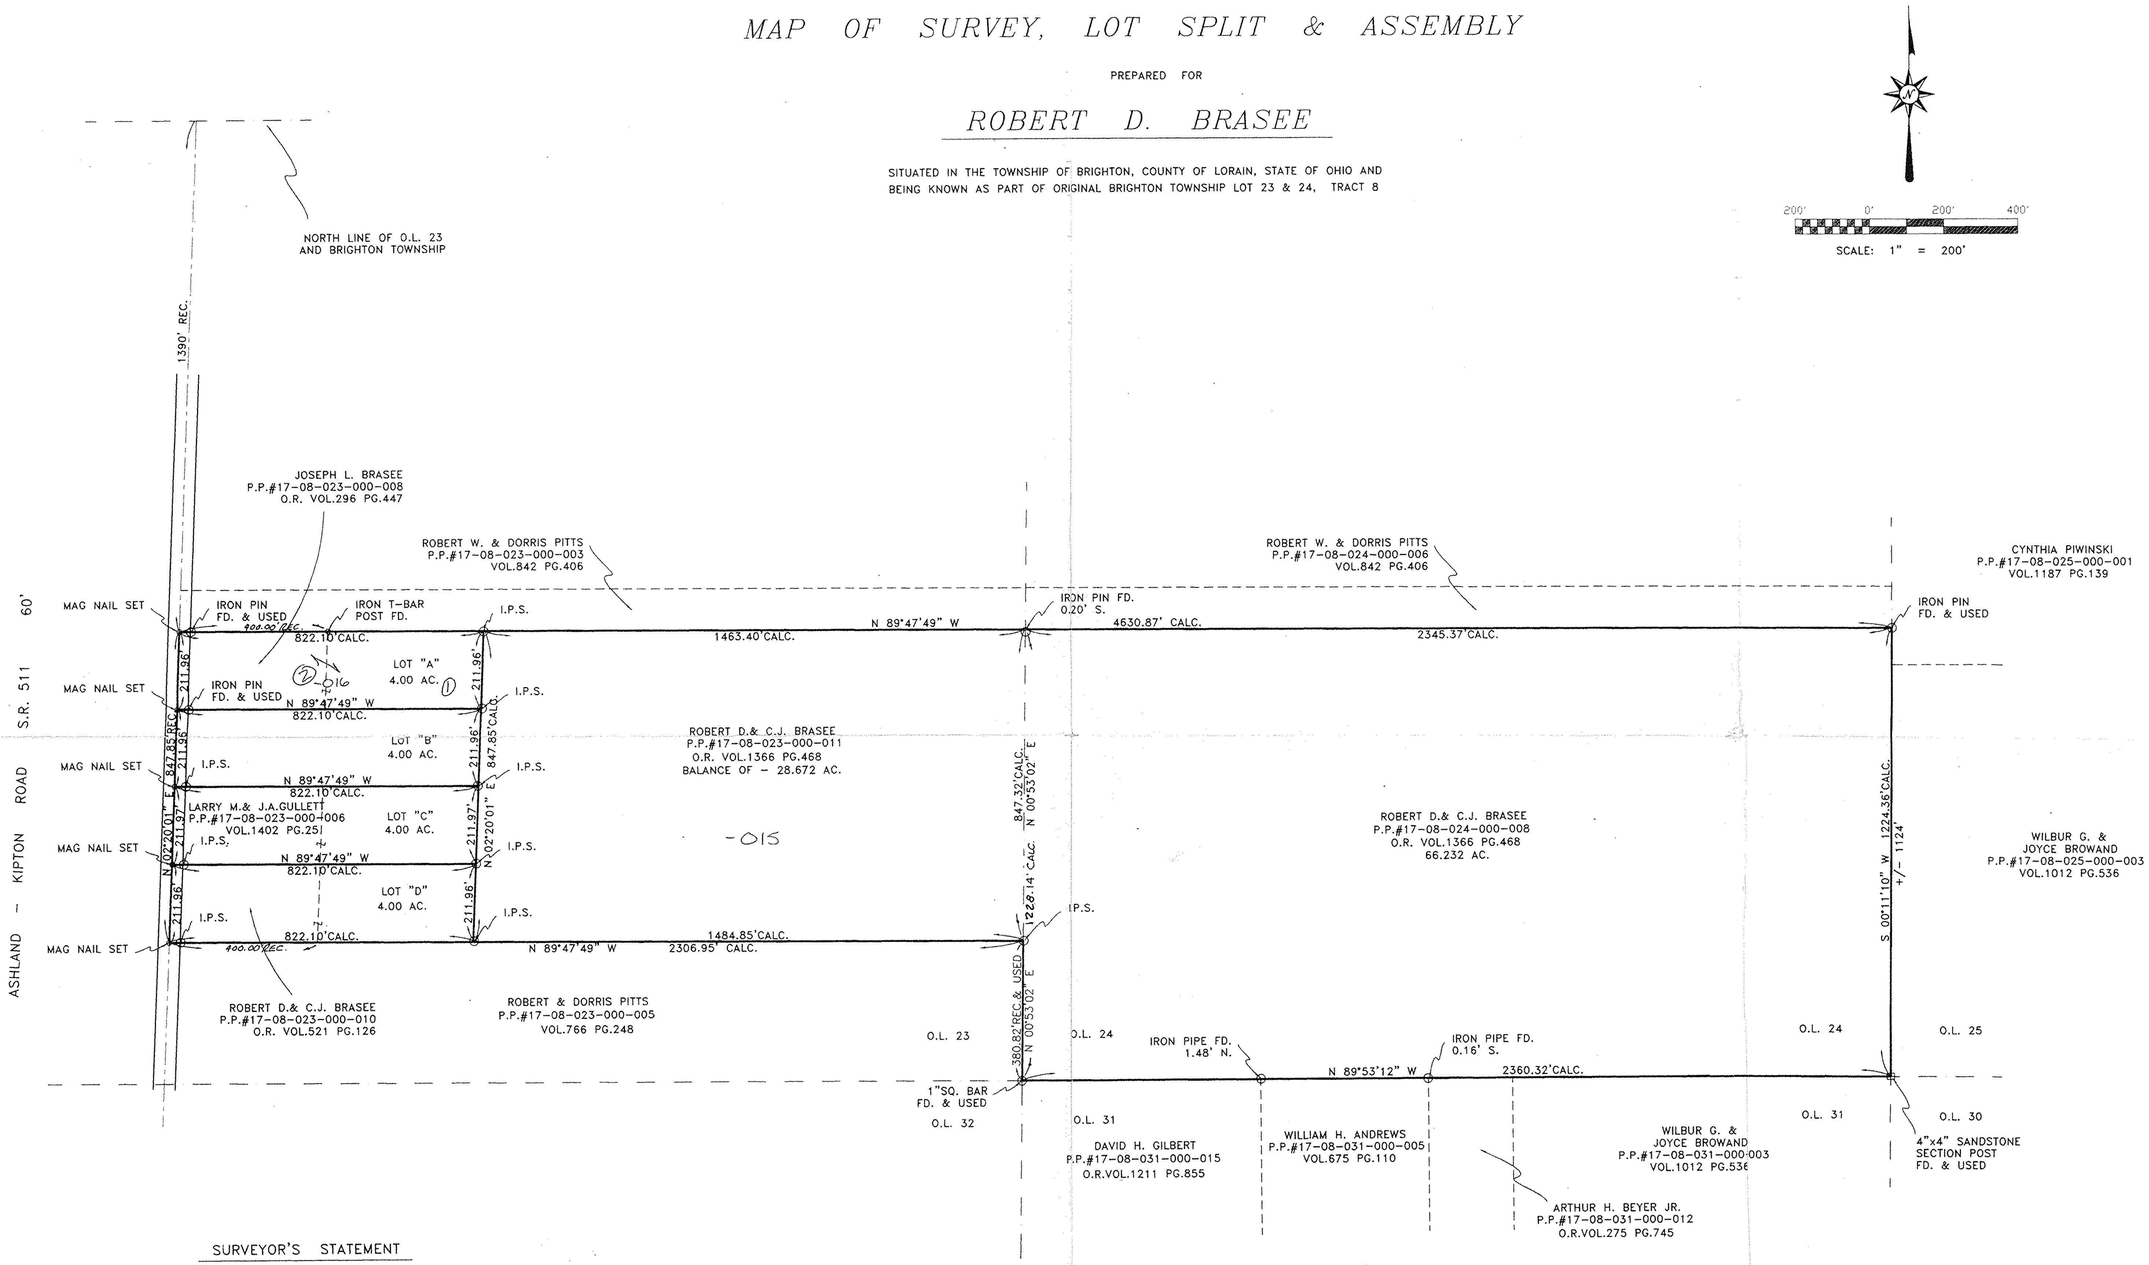

SURVEYOR'S STATEMENT

DISTANCES ARE EXPRESSED IN FEET AND DECIMAL PARTS THEREOF. BEARINGS ARE TO AN ASSUMED MERIDIAN AND ARE USED TO INDICATE ANGLES ONLY. PERMANENT MONUMENTS WERE FOUND OR SET AS INDICATED HEREON. —⊖— I.P.S. INDICATES A 5/8" IRON PIN WITH CAP SET. ALL OF WHICH I DECLARE TO BE CORRECT TO THE BEST OF MY ABILITIES AND BELIEF.

Thomas M. Snezek
THOMAS M. SNEZEK, R.L.S. 7051

4-24-98
DATE

STATE OF OHIO THOMAS M. SNEZEK 7051 SURVEYOR

#00070
APPROVED
LORAIN CO.
MAP DEPT.
DATE 4-21-99
PAGE 17-C
BY T. Spik
CHG. NUMBER 000070

PROJ.#9804 4/21/98