MAP OF SURVEY AND LOT SPLIT WITH INGRESS & EGRESS EASEMENT

PREPARED FOR

LORAIN-MEDINA RURAL ELECTRIC COOP., INC.

SITUATED IN THE TOWNSHIP OF BRIGHTON, COUNTY OF LORAIN, STATE OF OHIO
AND BEING PART OF ORIGINAL BRIGHTON TOWNSHIP LOT NO. 28, TRACT NO. 8

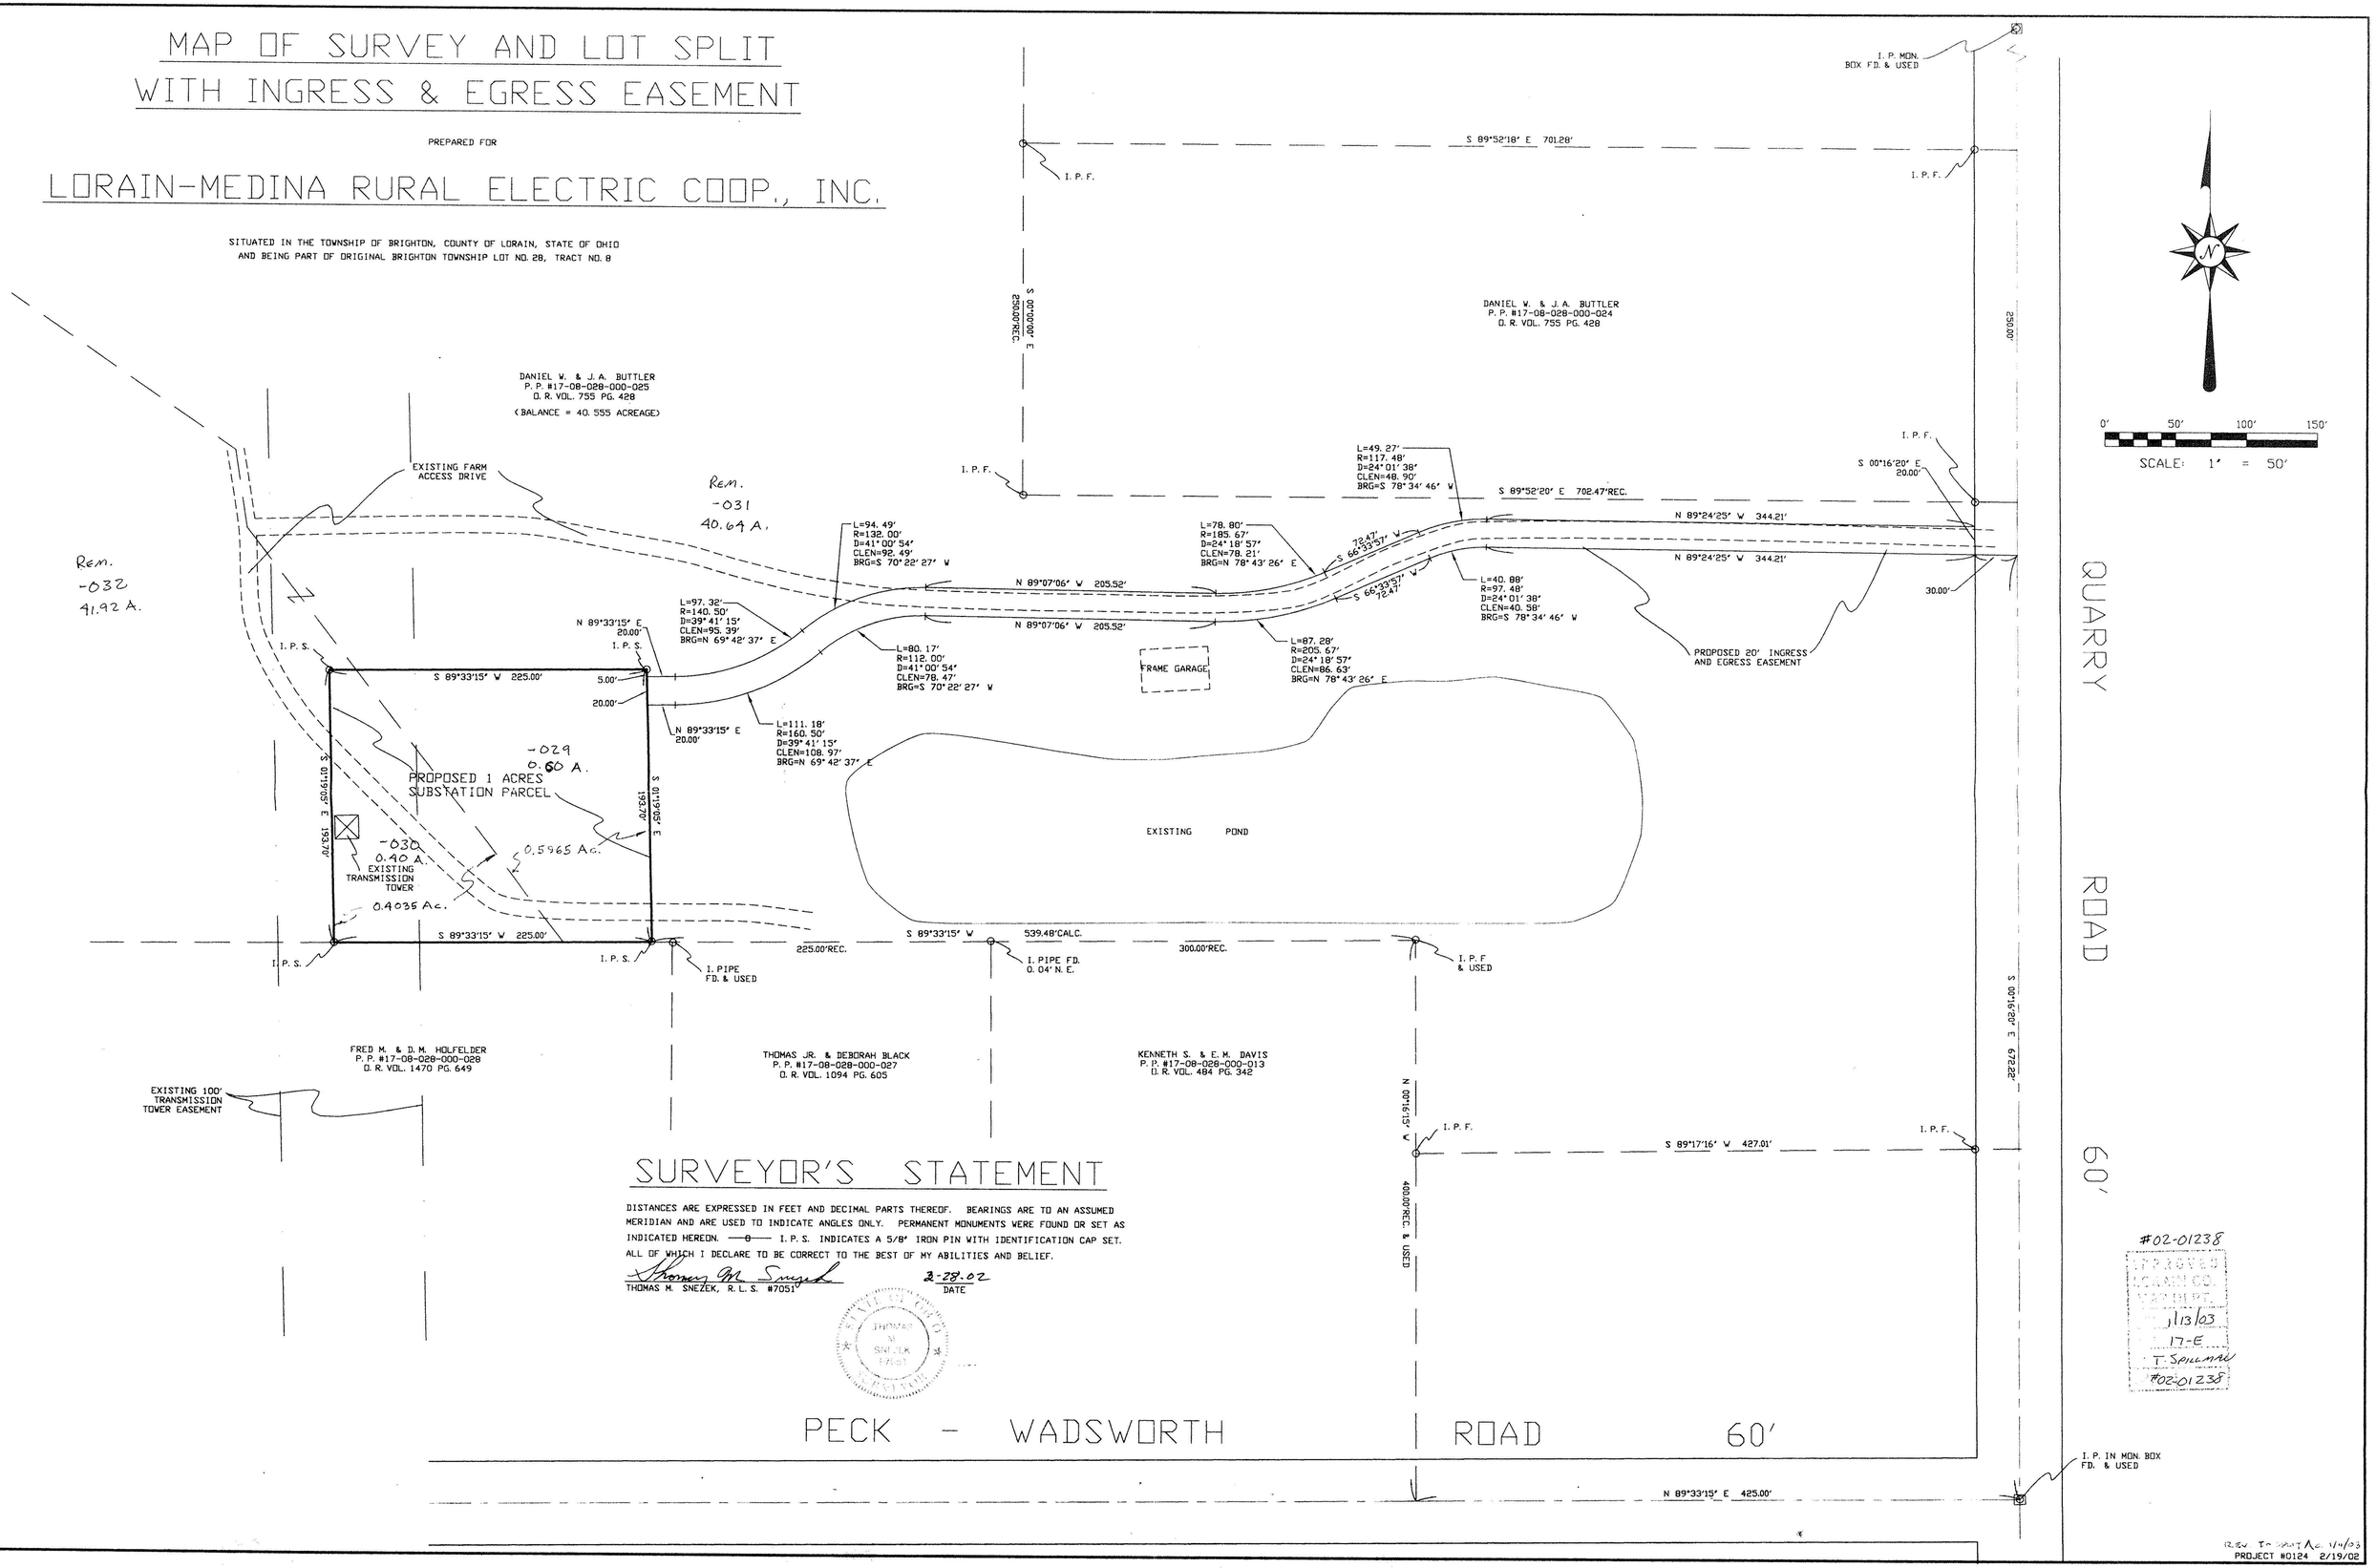

SURVEYOR'S STATEMENT

DISTANCES ARE EXPRESSED IN FEET AND DECIMAL PARTS THEREOF. BEARINGS ARE TO AN ASSUMED MERIDIAN AND ARE USED TO INDICATE ANGLES ONLY. PERMANENT MONUMENTS WERE FOUND OR SET AS INDICATED HEREON. —0— I. P. S. INDICATES A 5/8" IRON PIN WITH IDENTIFICATION CAP SET. ALL OF WHICH I DECLARE TO BE CORRECT TO THE BEST OF MY ABILITIES AND BELIEF.

Thomas M. Snezek
THOMAS M. SNEZEK, R. L. S. #7051

2-28-02
DATE

STATE OF OHIO THOMAS M. SNEZEK 7051 REGISTERED SURVEYOR

#02-01238
APPROVED LORAIN CO. TRANSFER
1/13/03
17-E
T. Spillman
#02-01238

REV. TR. SPLIT Ac. 1/14/03
PROJECT #0124 2/19/02