MAP OF SURVEY

PREPARED FOR

DAVID M. KING

SITUATED IN THE TOWNSHIP OF WELLINGTON, COUNTY OF LORAIN AND STATE OF OHIO AND KNOWN AS BEING PART OF ORIGINAL WELLINGTON TOWNSHIP LOT 30

№ 0783-C

1-6-03
18-B
R.MAINES
02-00783 C

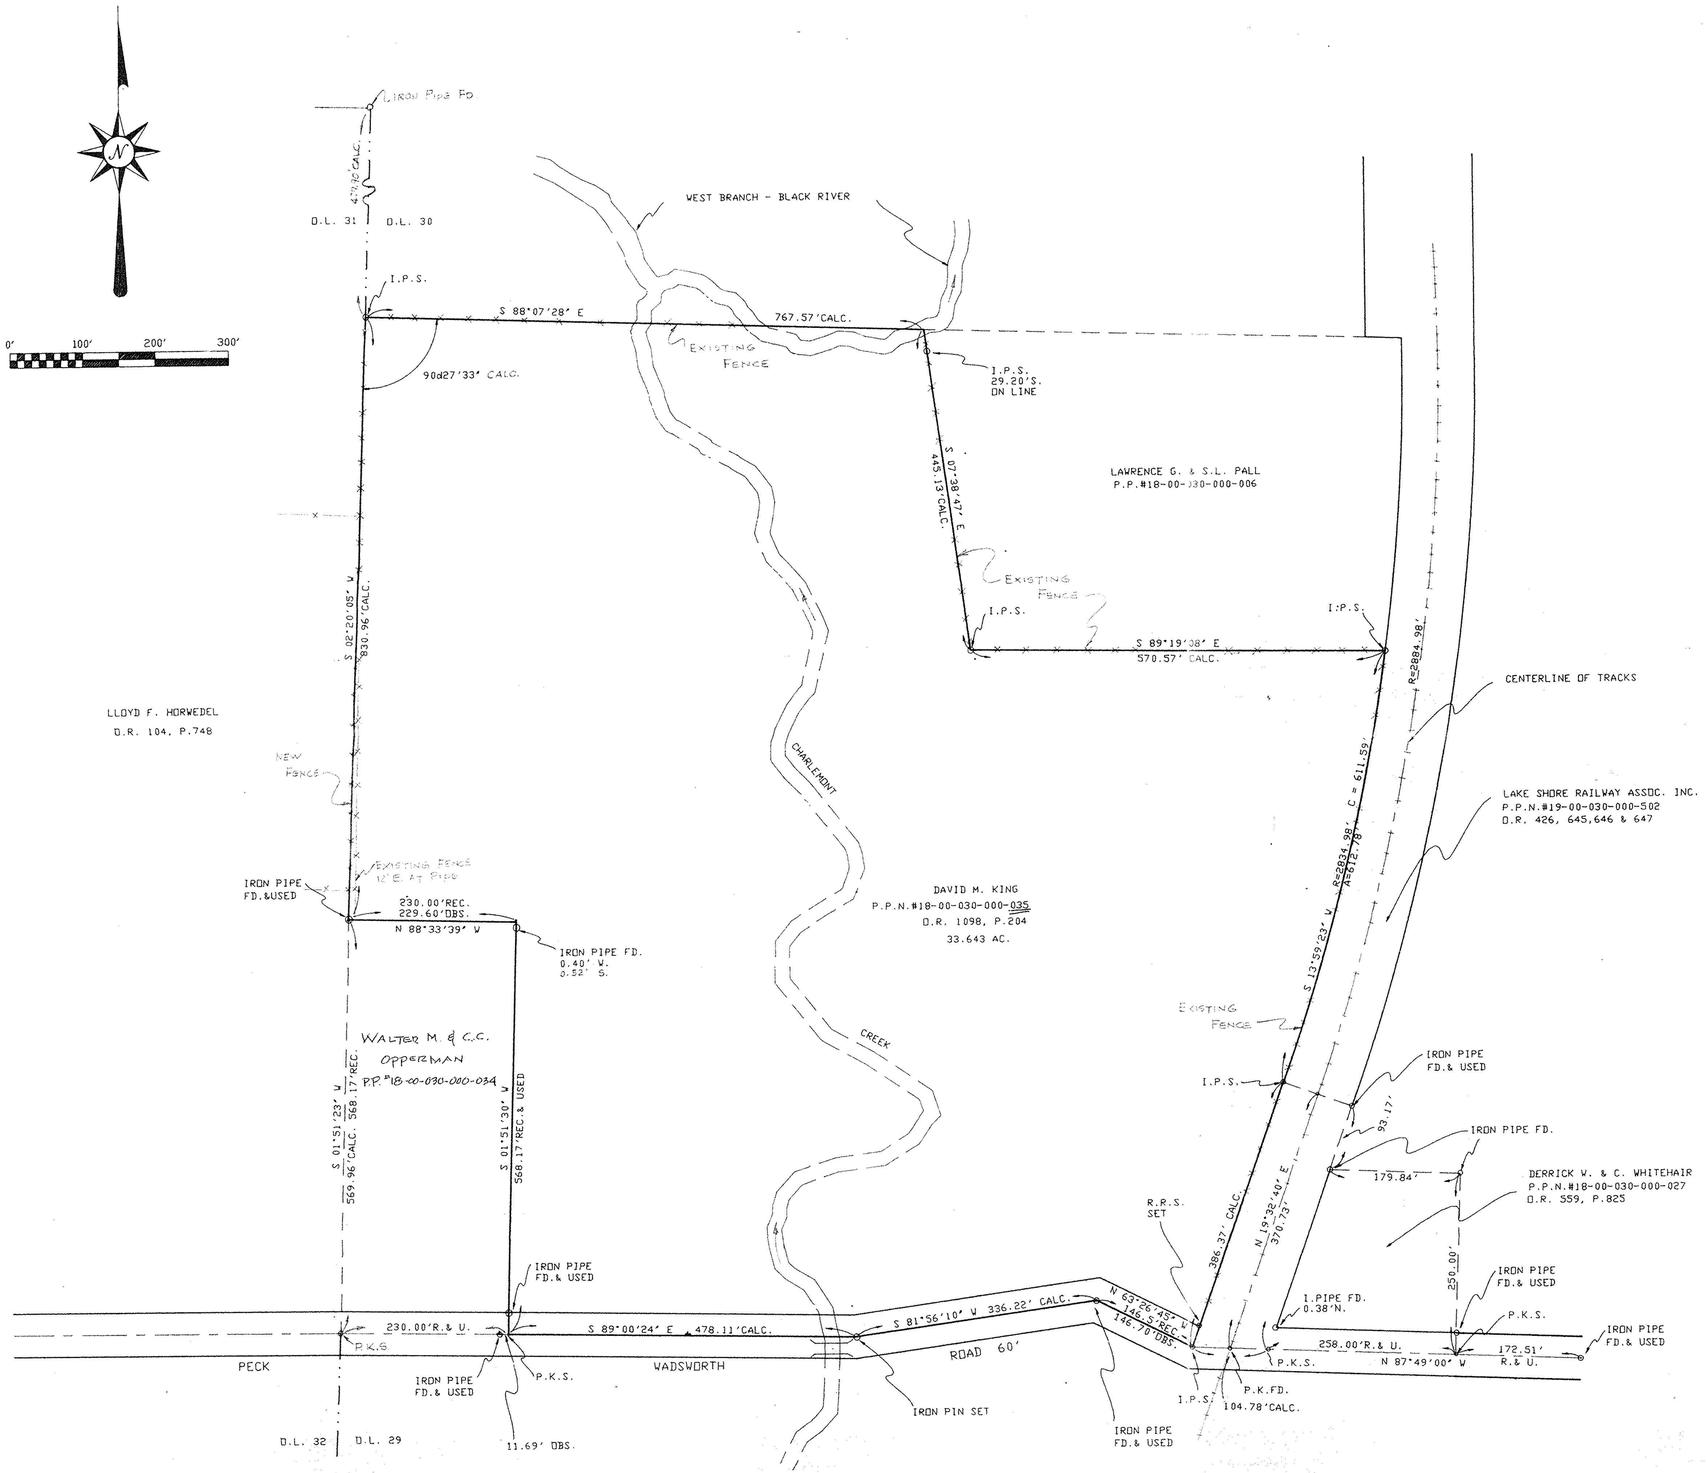

SURVEYOR'S STATEMENT

DISTANCES ARE EXPRESSED IN FEET AND DECIMAL PARTS THEREOF. BEARINGS ARE TO AN ASSUMED MERIDIAN AND ARE USED TO INDICATE ANGLES ONLY. PERMANENT MONUMENTS WERE FOUND OR SET AS INDICATED HEREON. ALL OF WHICH I DECLARE TO BE CORRECT TO THE BEST OF MY ABILITIES AND BELIEF.

THOMAS M. SNEZEK, P.S. NO. 7051 — DATE

STATE OF OHIO — THOMAS M. SNEZEK 7051 — SURVEYOR

NOTE: DENOTES 5/8" DIA. ROD WITH CAP SET — I.P.S.

9609