
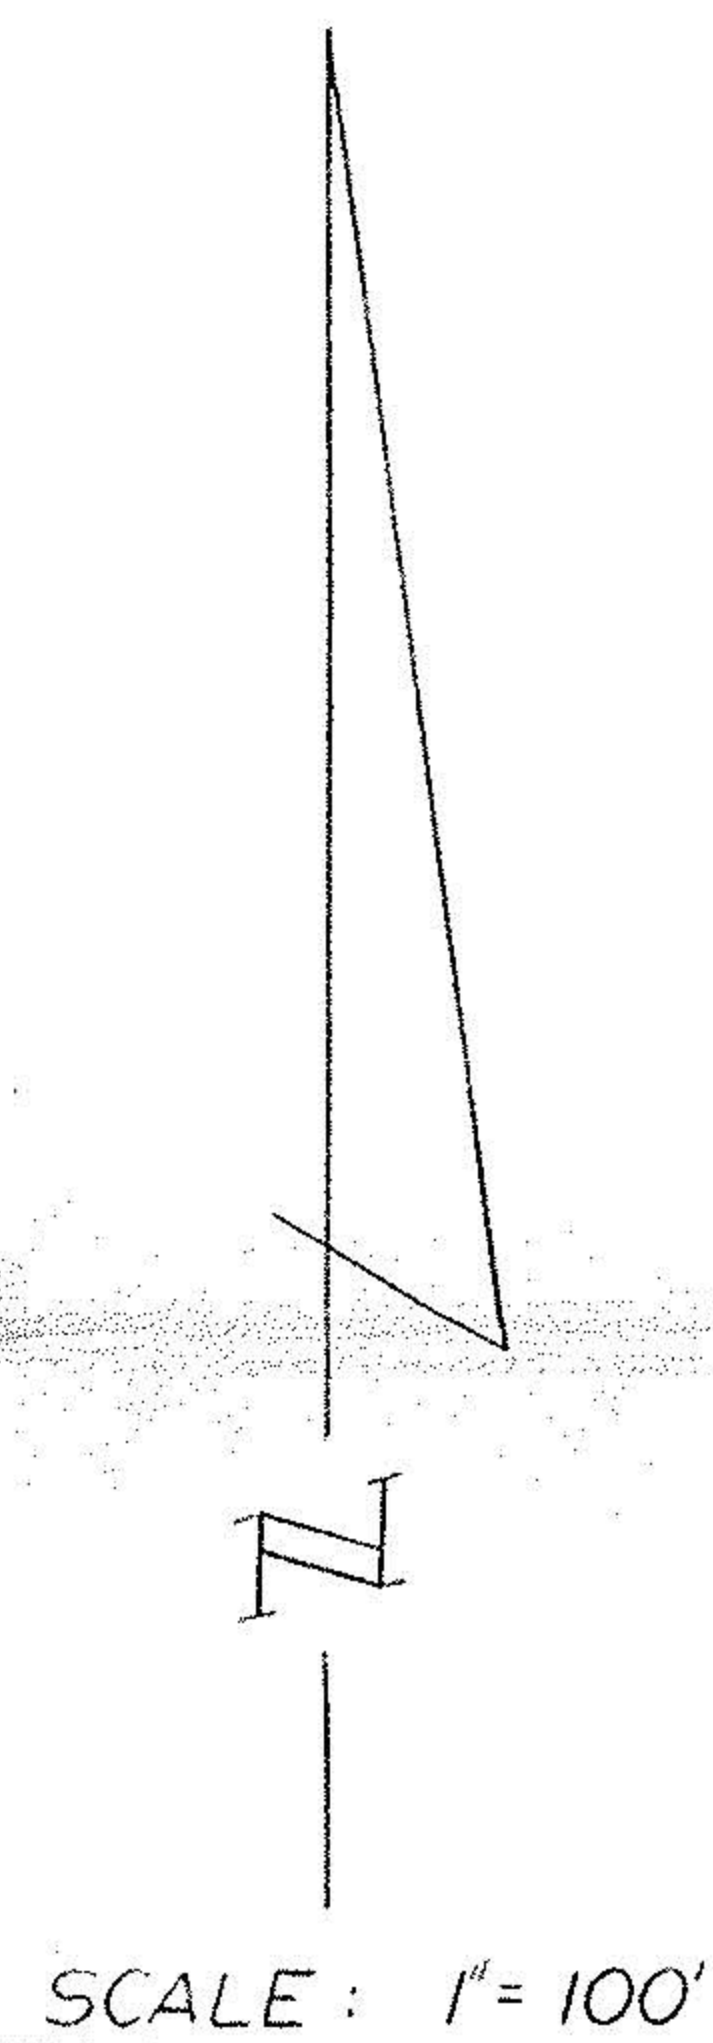


SURVEY FOR THE VILLAGE OF WELLINGTON

PT. ORIGINAL LOTS 36 & 37, VILLAGE OF WELLINGTON,
LORAIN CO., OHIO

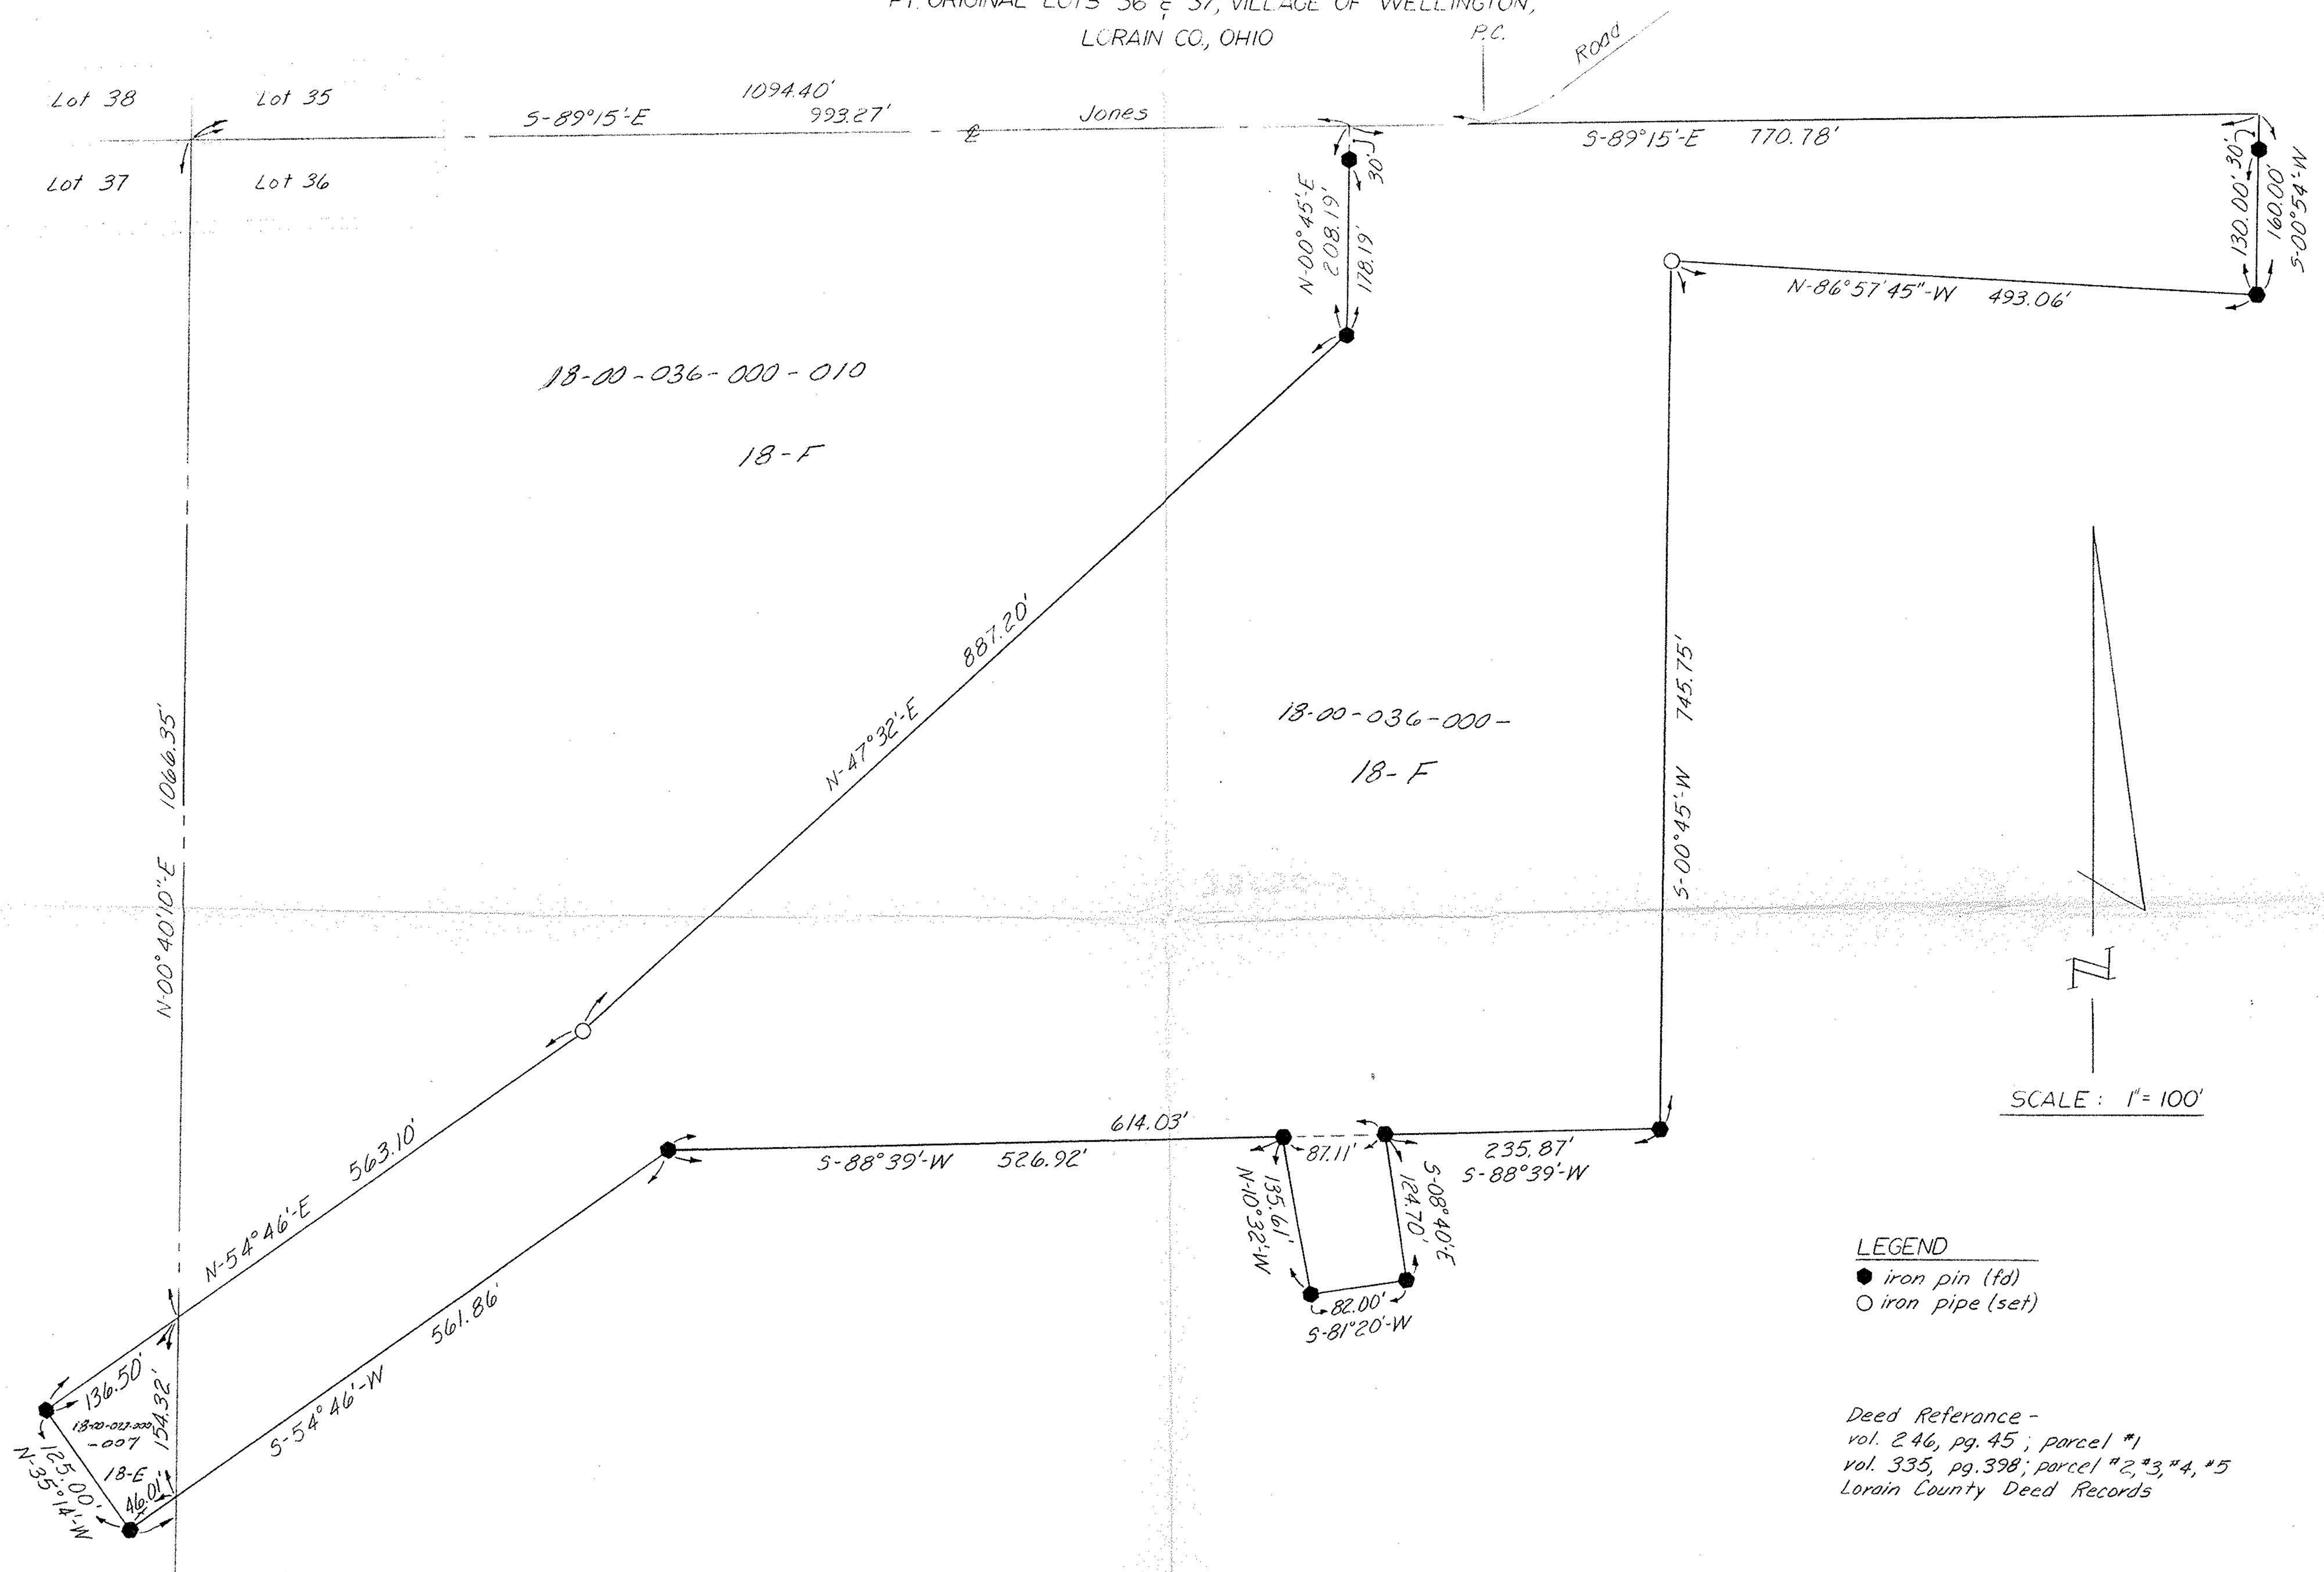

LEGEND
 ● iron pin (fd)
 ○ iron pipe (set)

Deed Reference -
 vol. 246, pg. 45; parcel #1
 vol. 335, pg. 398; parcel #2, #3, #4, #5
 Lorain County Deed Records

18F

We hereby certify the above described parcel was surveyed during July 1973.
 All distances are in feet and decimals thereof.

LESTER H. POGGEMEYER, P.E., INC.
 Engineers & Surveyors, Bowling Green, Ohio

Arthur O. Lybarger
 Arthur O. Lybarger - Reg. Surveyor #11,118