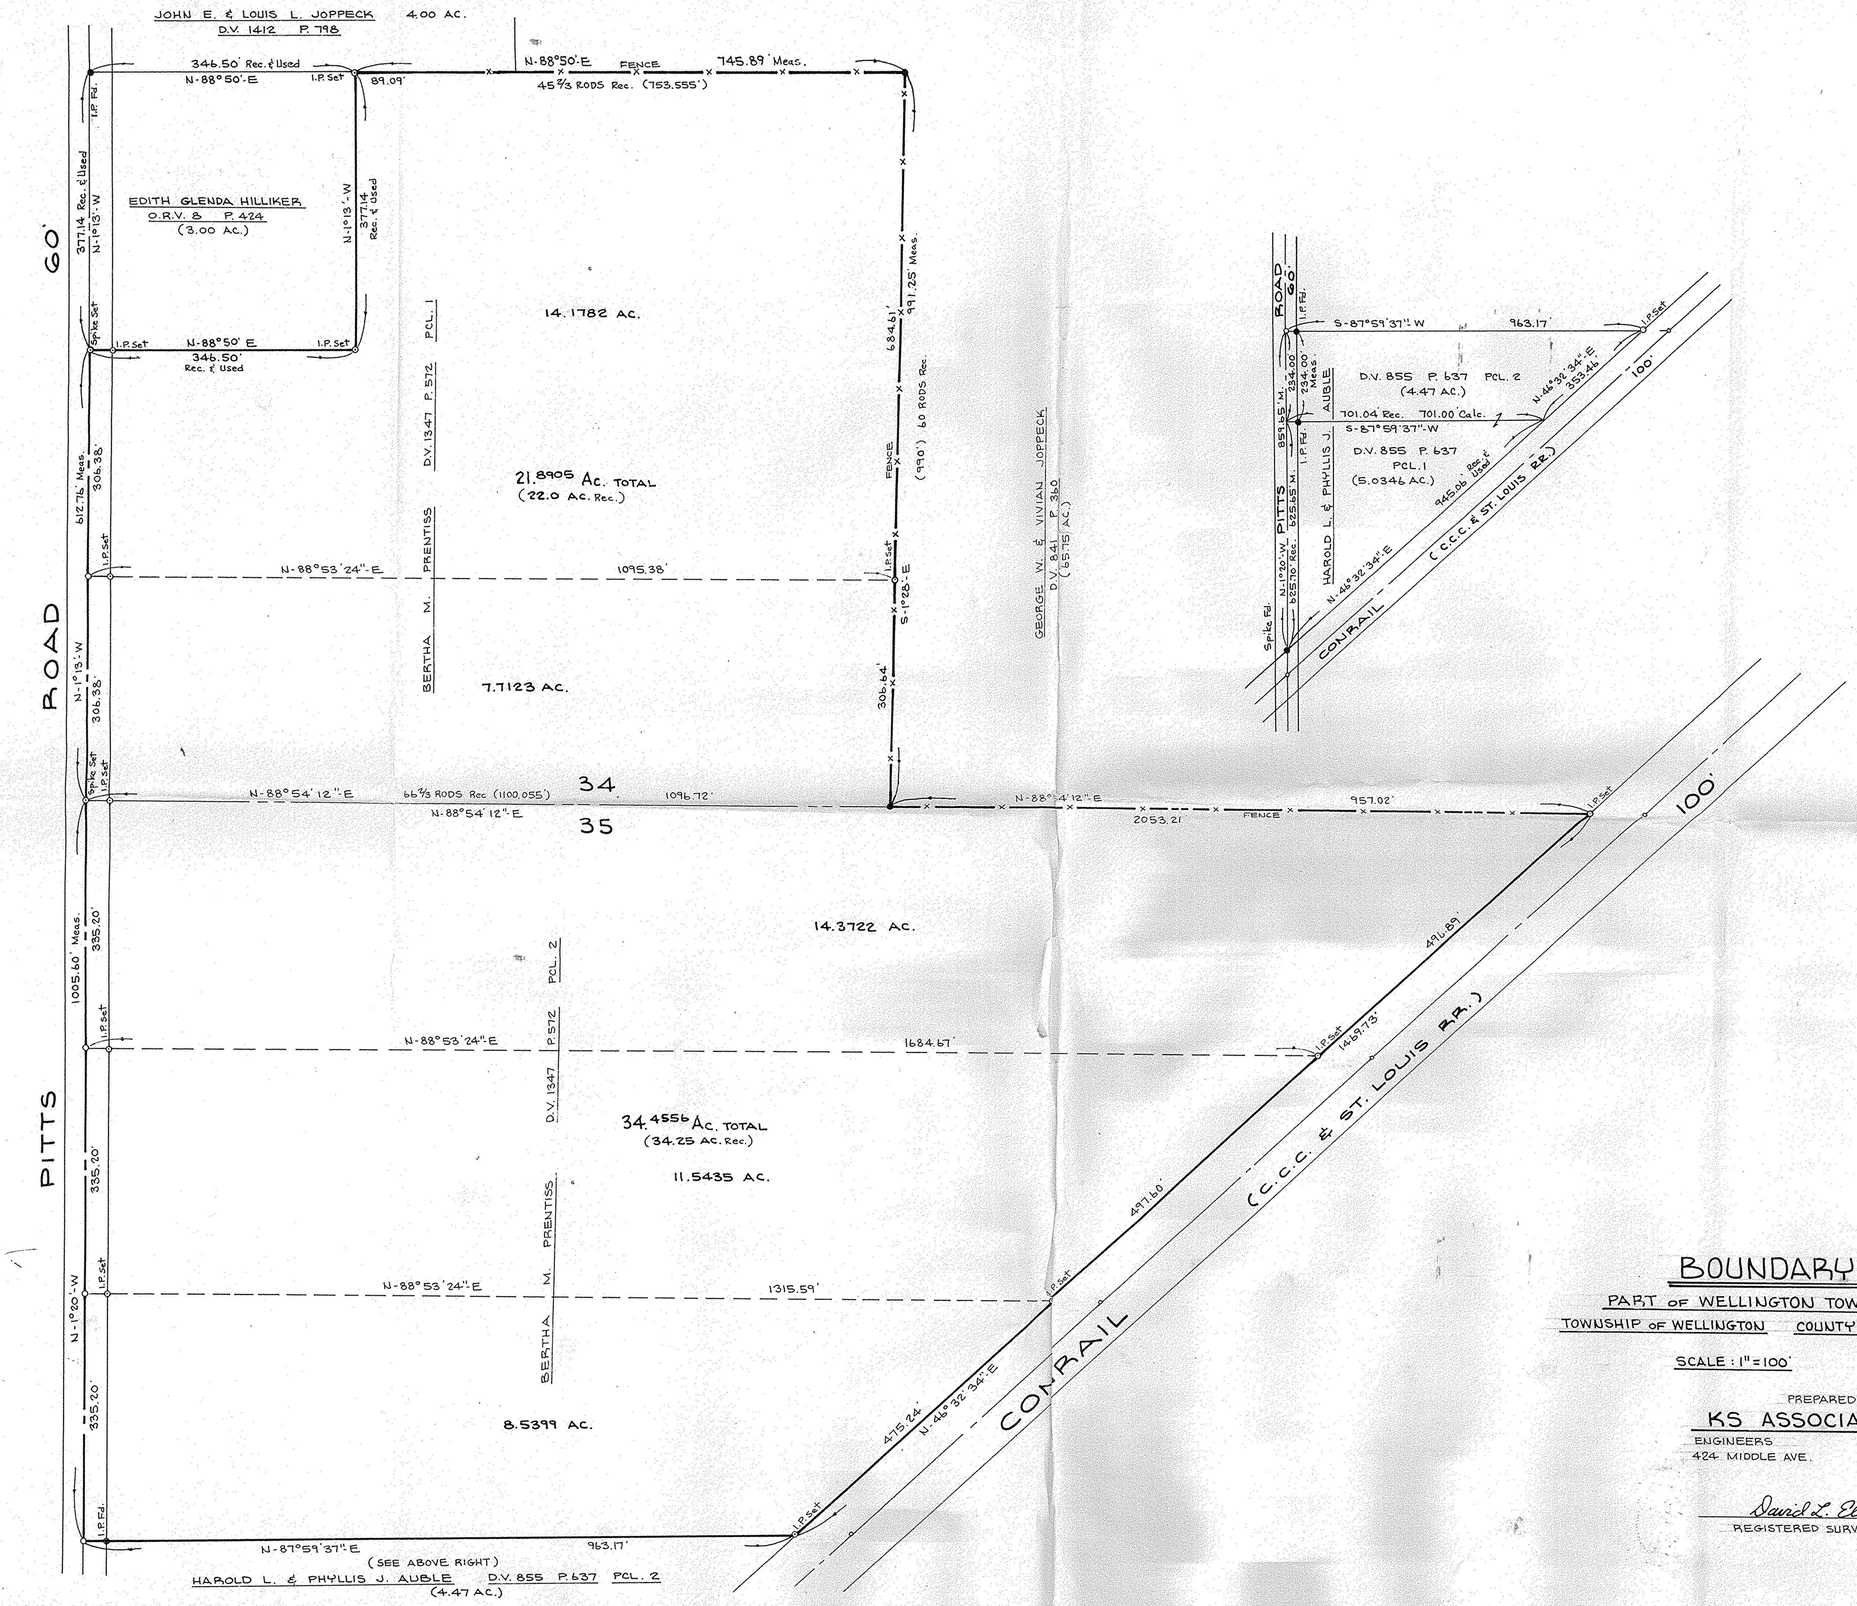

BOUNDARY SURVEY

PART OF WELLINGTON TOWNSHIP ORIG. LOTS 34 & 35

TOWNSHIP OF WELLINGTON COUNTY OF LORAIN STATE OF OHIO

SCALE : 1" = 100' DEC. 1, 1988

PREPARED BY

KS ASSOCIATES INC.

ENGINEERS SURVEYORS

424 MIDDLE AVE. ELYRIA, OHIO

David L. Elwell

REGISTERED SURVEYOR NO. 6333

STATE OF OHIO
DAVID L. ELWELL
6333
REGISTERED SURVEYOR

#18478

APPROVED
LORAIN CO.
MAP DEPT.

DATE 6-13-89
PAGE 18-F
BY Carolyn Francis
VOID AFTER # 18478

88-479