
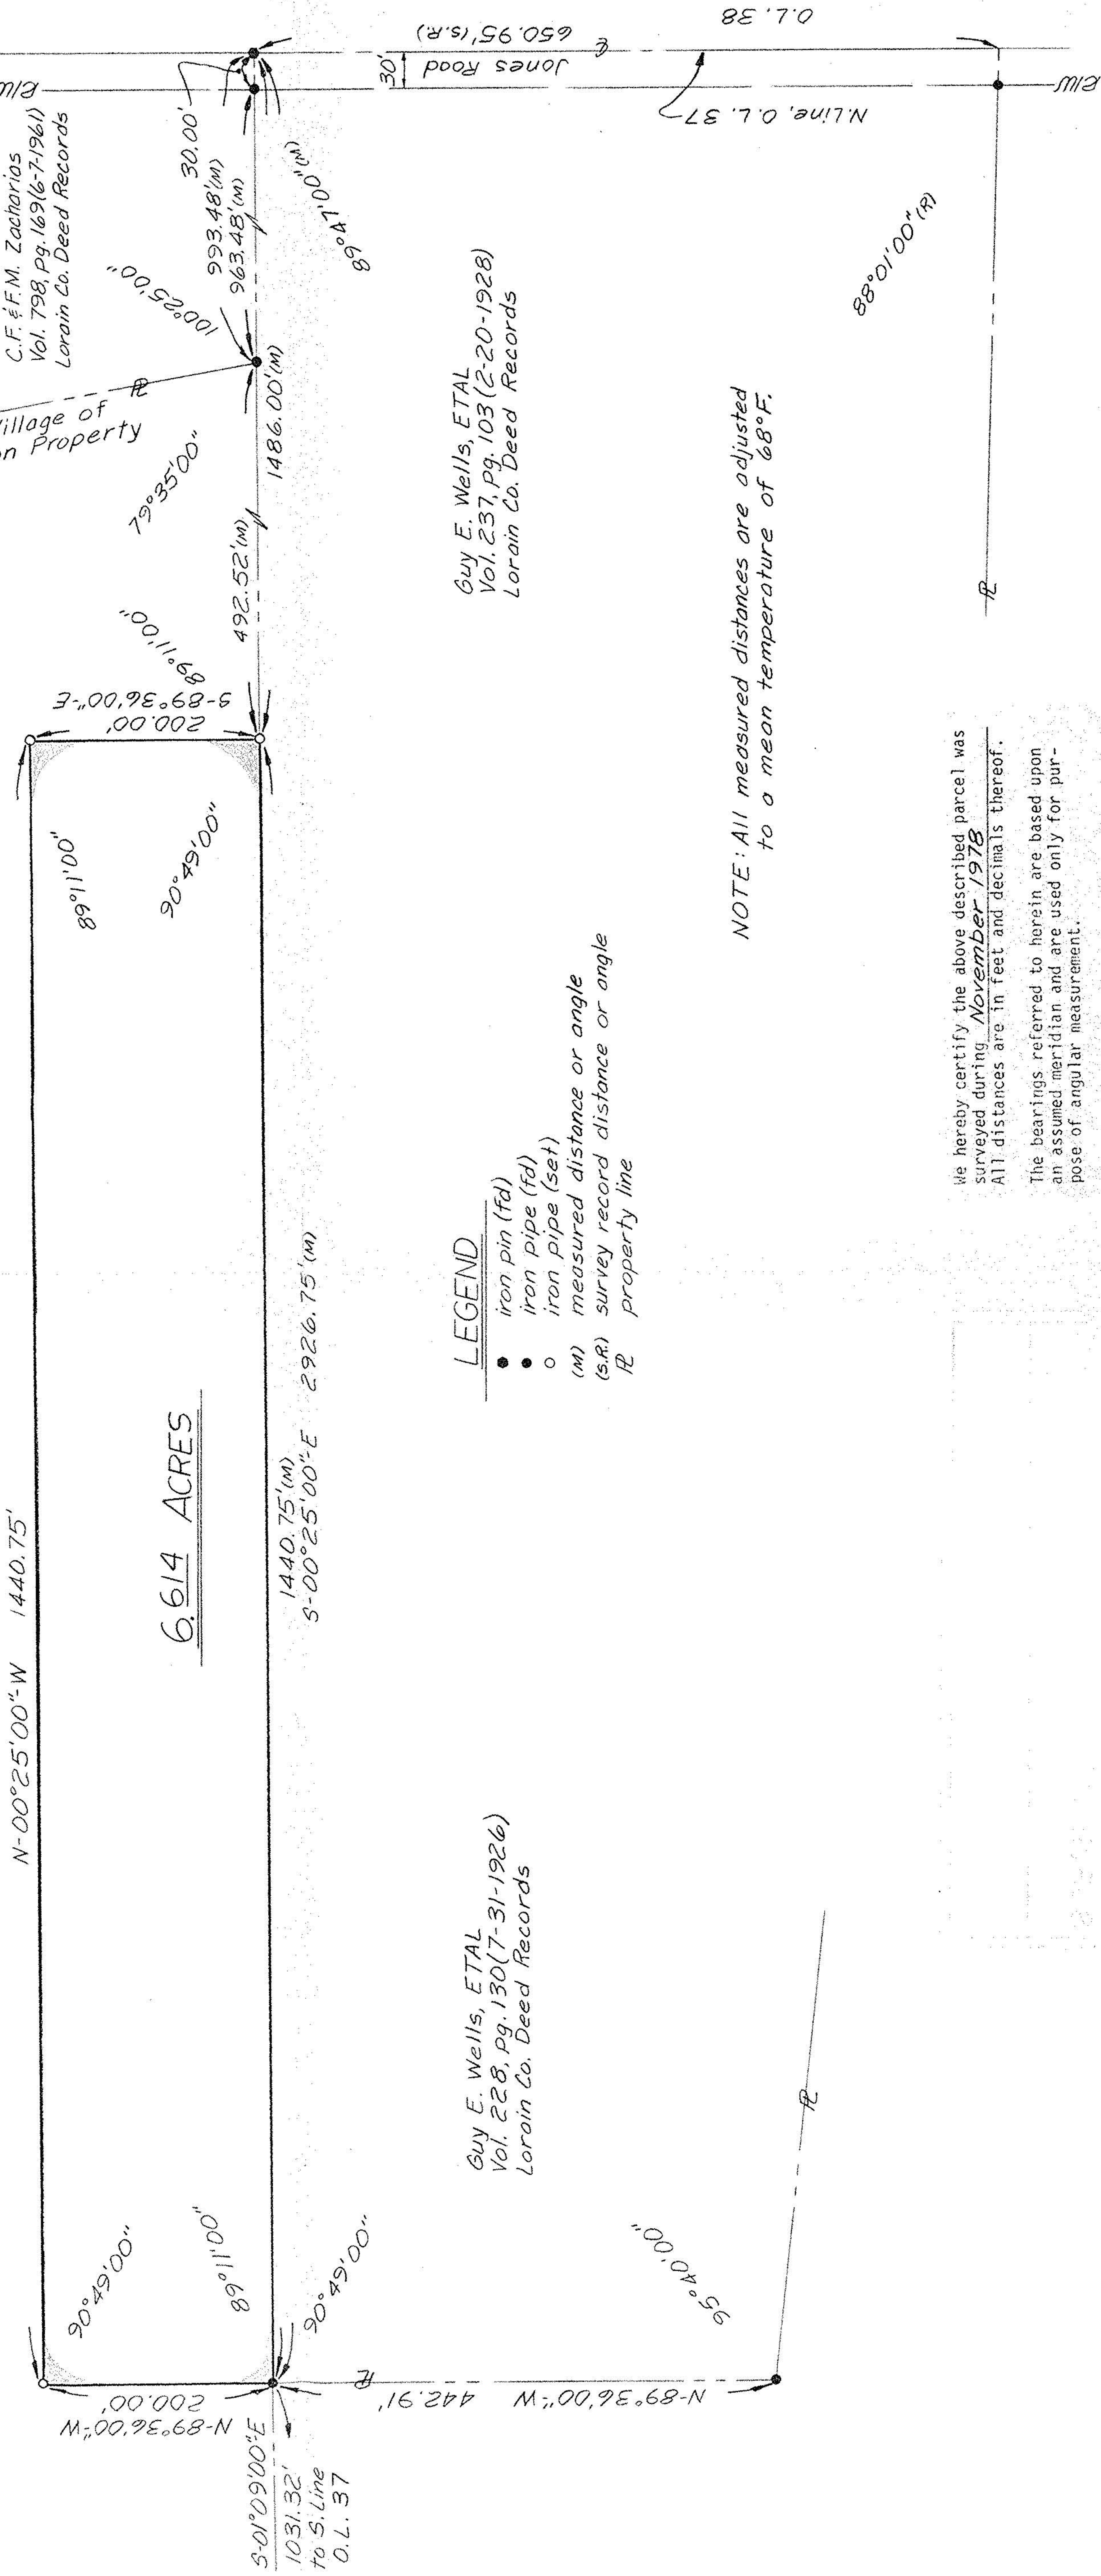


SURVEY FOR THE VILLAGE OF WELLINGTON

(The Village of Wellington to Guy E. Wells, ETAL)

Pt. O.L. 37, Wellington Township, Lorain County, Ohio

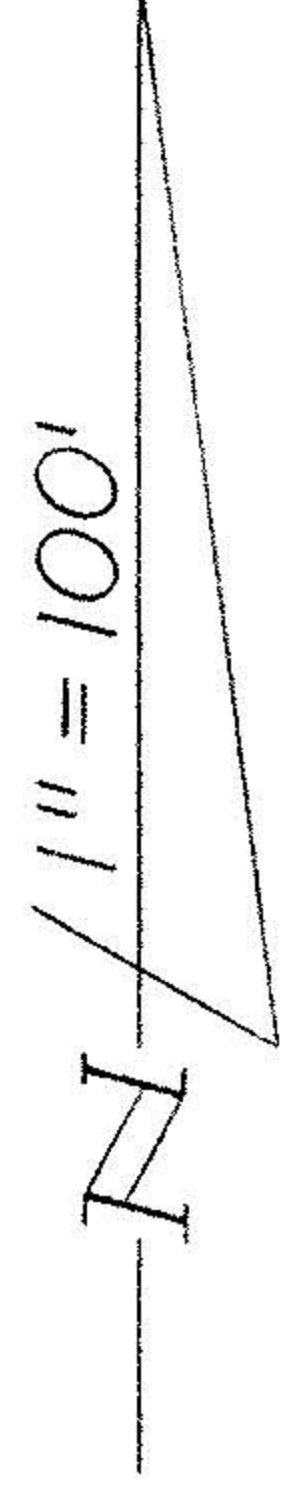

Guy E. Wells, ETAL
Vol. 228, pg. 130 (7-31-1926)
Lorain Co. Deed Records

LEGEND

- iron pin (fd)
- iron pipe (fd)
- iron pipe (set)
- (M) measured distance or angle
- (S.R) survey record distance or angle
- R property line

NOTE: All measured distances are adjusted to a mean temperature of 68°F.

We hereby certify the above described parcel was surveyed during November 1978. All distances are in feet and decimals thereof.

The bearings referred to herein are based upon an assumed meridian and are used only for purpose of angular measurement.

LESTER H. POGGEYER, P.E., INC.
Engineers-Architects-Surveyors
Bowling Green, Ohio

Arthur O. Lybarger
Arthur O. Lybarger --- Reg. Surveyor #4478