SURVEY FOR THE VILLAGE OF WELLINGTON

(Guy E. Wells, ETAL to The Village of Wellington - 6.823 Acres)
(C.F. & F.M. Zocharias to The Village of Wellington - 4.569 Acres)

Pt. O.L. 37, Wellington Township, Lorain County, Ohio

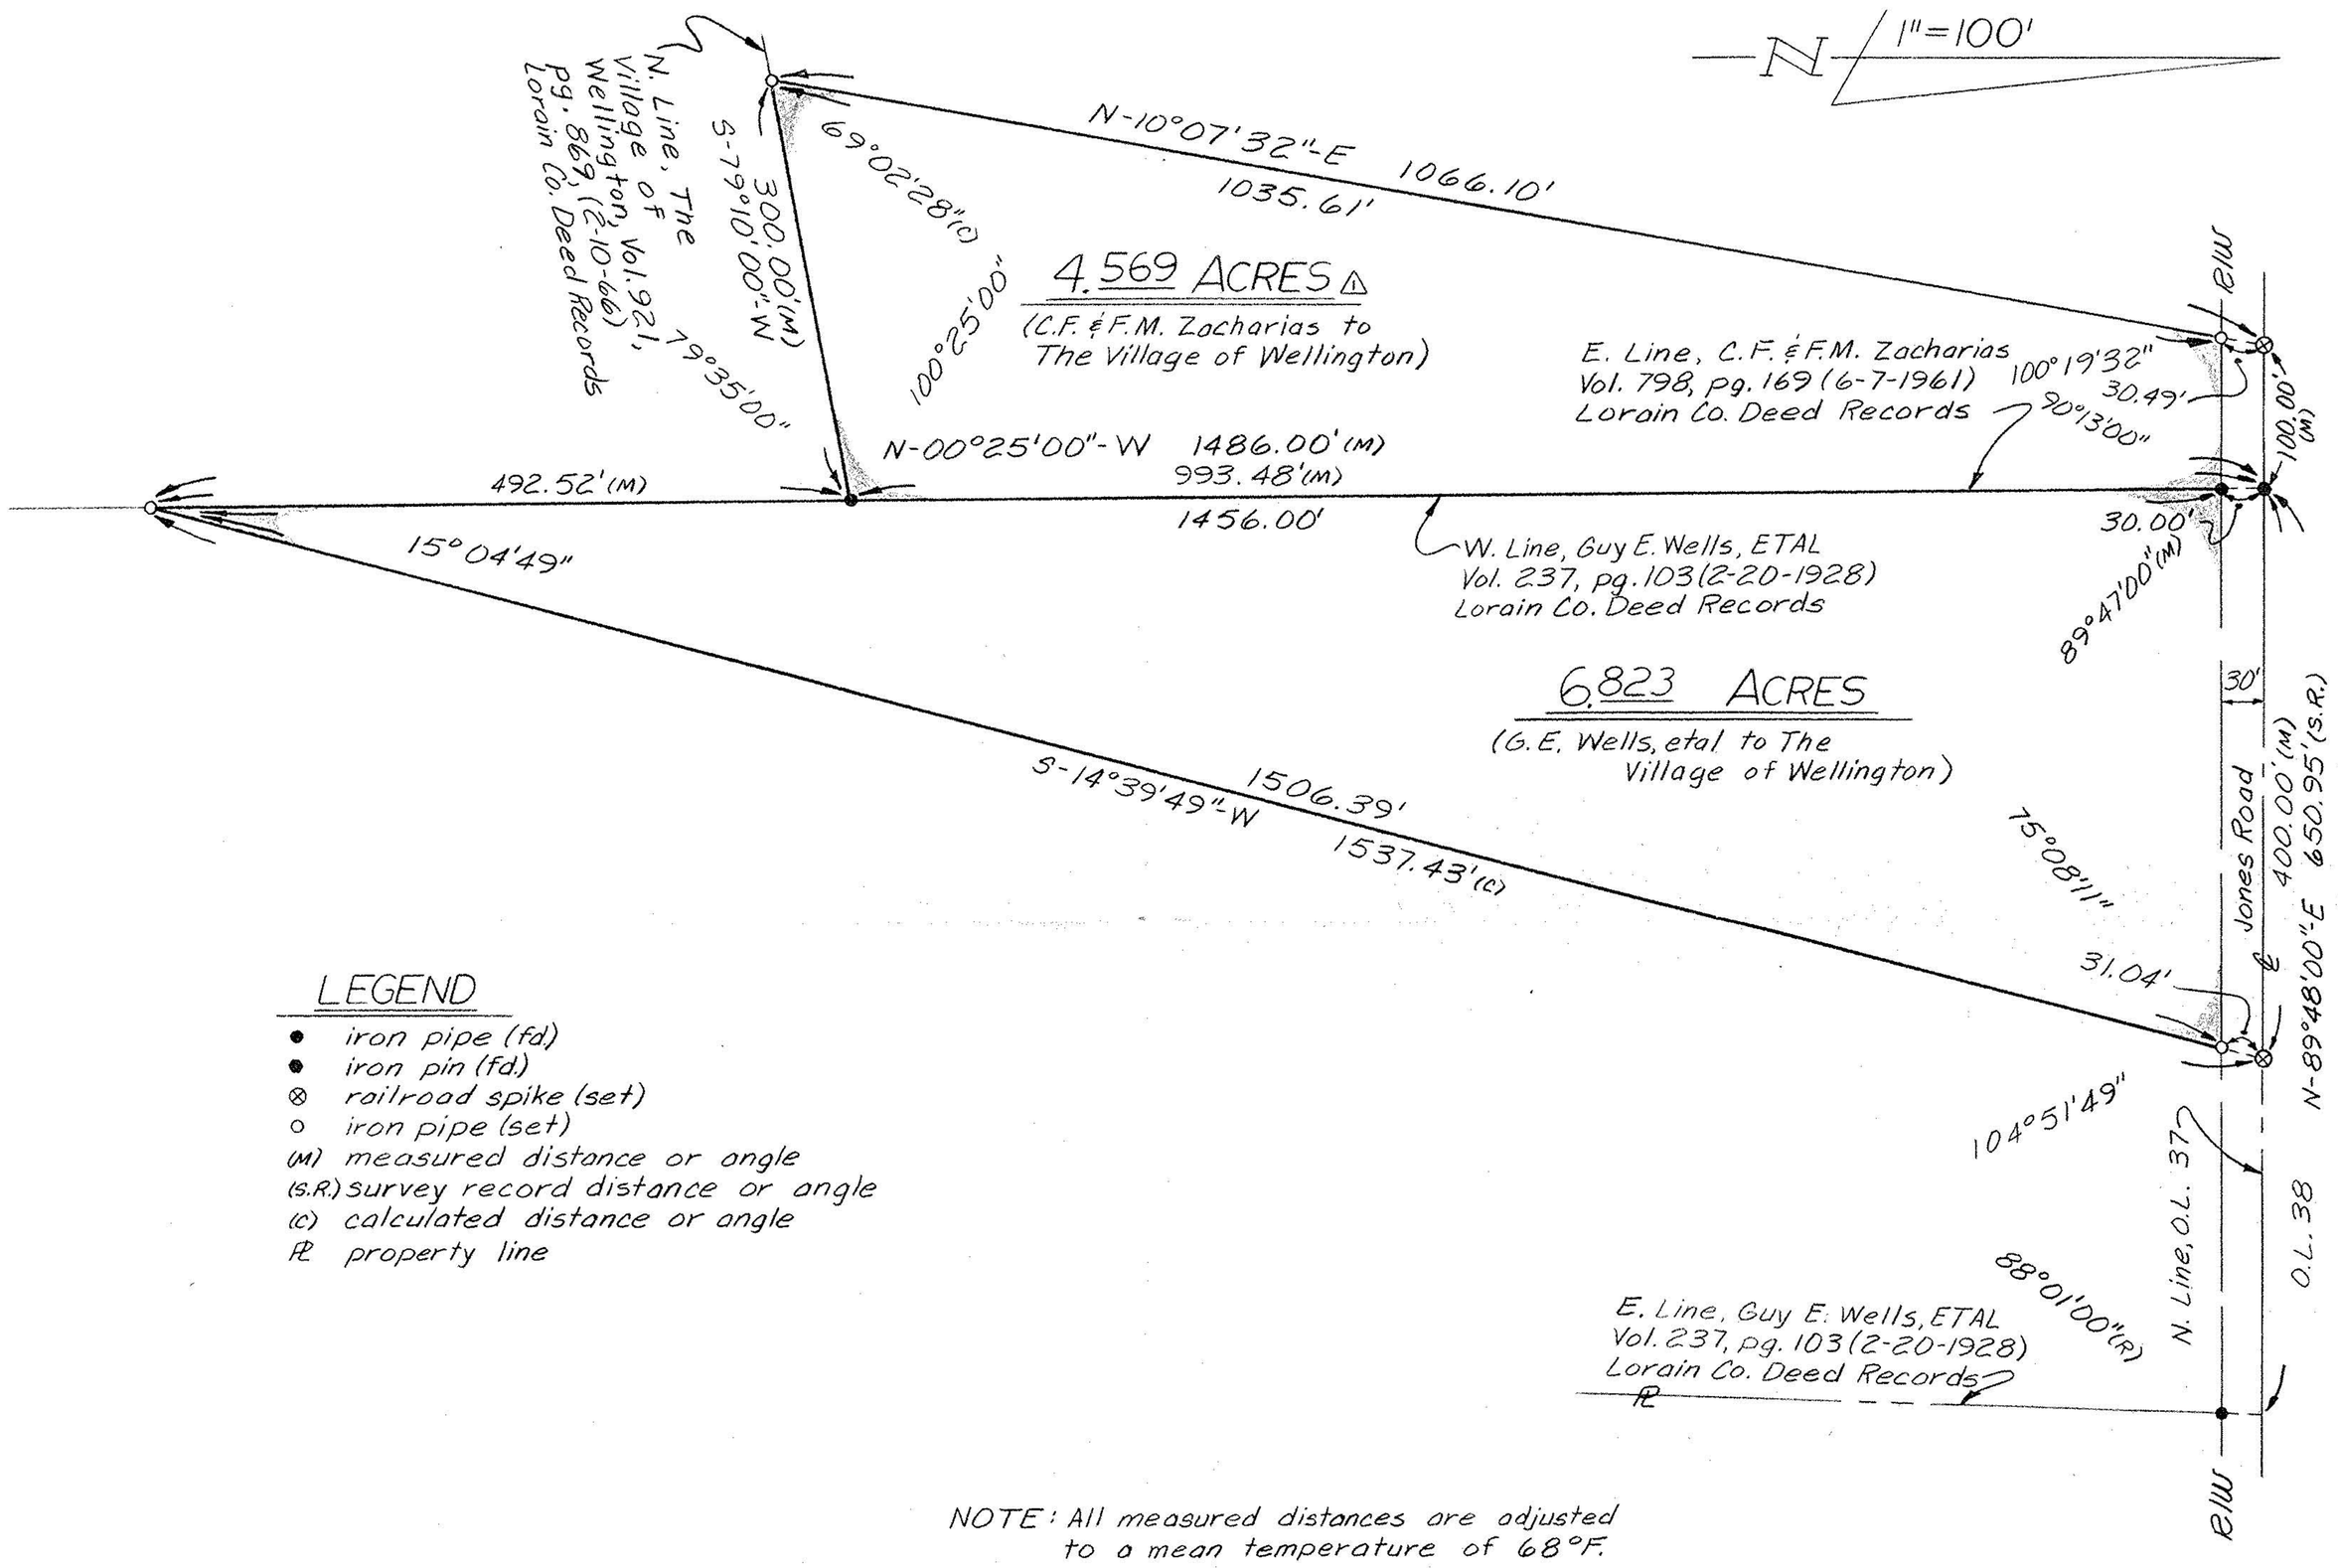

LEGEND

- ● iron pipe (fd.)
- ◉ iron pin (fd.)
- ⊗ railroad spike (set)
- ○ iron pipe (set)
- (M) measured distance or angle
- (S.R.) survey record distance or angle
- (C) calculated distance or angle
- P.L. property line

NOTE: All measured distances are adjusted to a mean temperature of 68°F.

We hereby certify the above described parcel was surveyed during November 1978
All distances are in feet and decimals thereof.

The bearings referred to herein are based upon an assumed meridian and are used only for purpose of angular measurement.

LESTER H. POGGEMEYER, P.E., INC.
Engineers-Architects-Surveyors
Bowling Green, Ohio

Arthur O. Lybarger

Arthur O. Lybarger -- Reg. Surveyor #4418

△ revised 5-23-80 KCD

78188-5 ½ KCD