THOMAS SIMON & ASSOCIATES, INC.
PROFESSIONAL LAND SURVEYORS
COBBLESTONE CORNER PROFESSIONAL CENTER
39069 CENTER RIDGE RD.
NORTH RIDGEVILLE, OH. 44039
(440) 327-2925
FAX 327-2964

SURVEY FOR: TONYA R. & DONALD W. CANTWELL
19875 QUARRY ROAD
WELLINGTON, OHIO 44090

| | | |
|---|---|---|
| ORIG. LOT 43 | CITY OF | DATE 10-2000 SCALE: 1" = 100' |
| ORIG. SEC. | VILLAGE OF | DWN. BY TAS |
| TRACT | COUNTY OF LORAIN | JOB NO. 2000-050 |
| TOWNSHIP OF WELLINGTON | STATE OF OHIO | |

DIMENSIONS SHOWN ON THIS PLAT ARE EXPRESSED IN FEET AND DECIMAL PARTS THEREOF. ALL BEARINGS ARE TO AN ASSUMED MERIDIAN AND ARE USED TO DESCRIBE ANGLES ONLY. PERMANENT MONUMENTS WERE FOUND OR SET AS INDICATED, ALL OF WHICH I CERTIFY TO BE CORRECT.

THOMAS A. SIMON
REG. PROFESSIONAL
SURVEYOR NO. S-7775

STATE OF OHIO * PROFESSIONAL * REGISTERED SURVEYOR
THOMAS A. SIMON
S-7775

BASIS OF BEARINGS IS THE CENTERLINE OF QUARRY ROAD N. 00° 40' 00"E. IRON PINS SET ARE 5/8" DIA. 30" LONG WITH PLASTIC CAPS "T. SIMON S-7775".

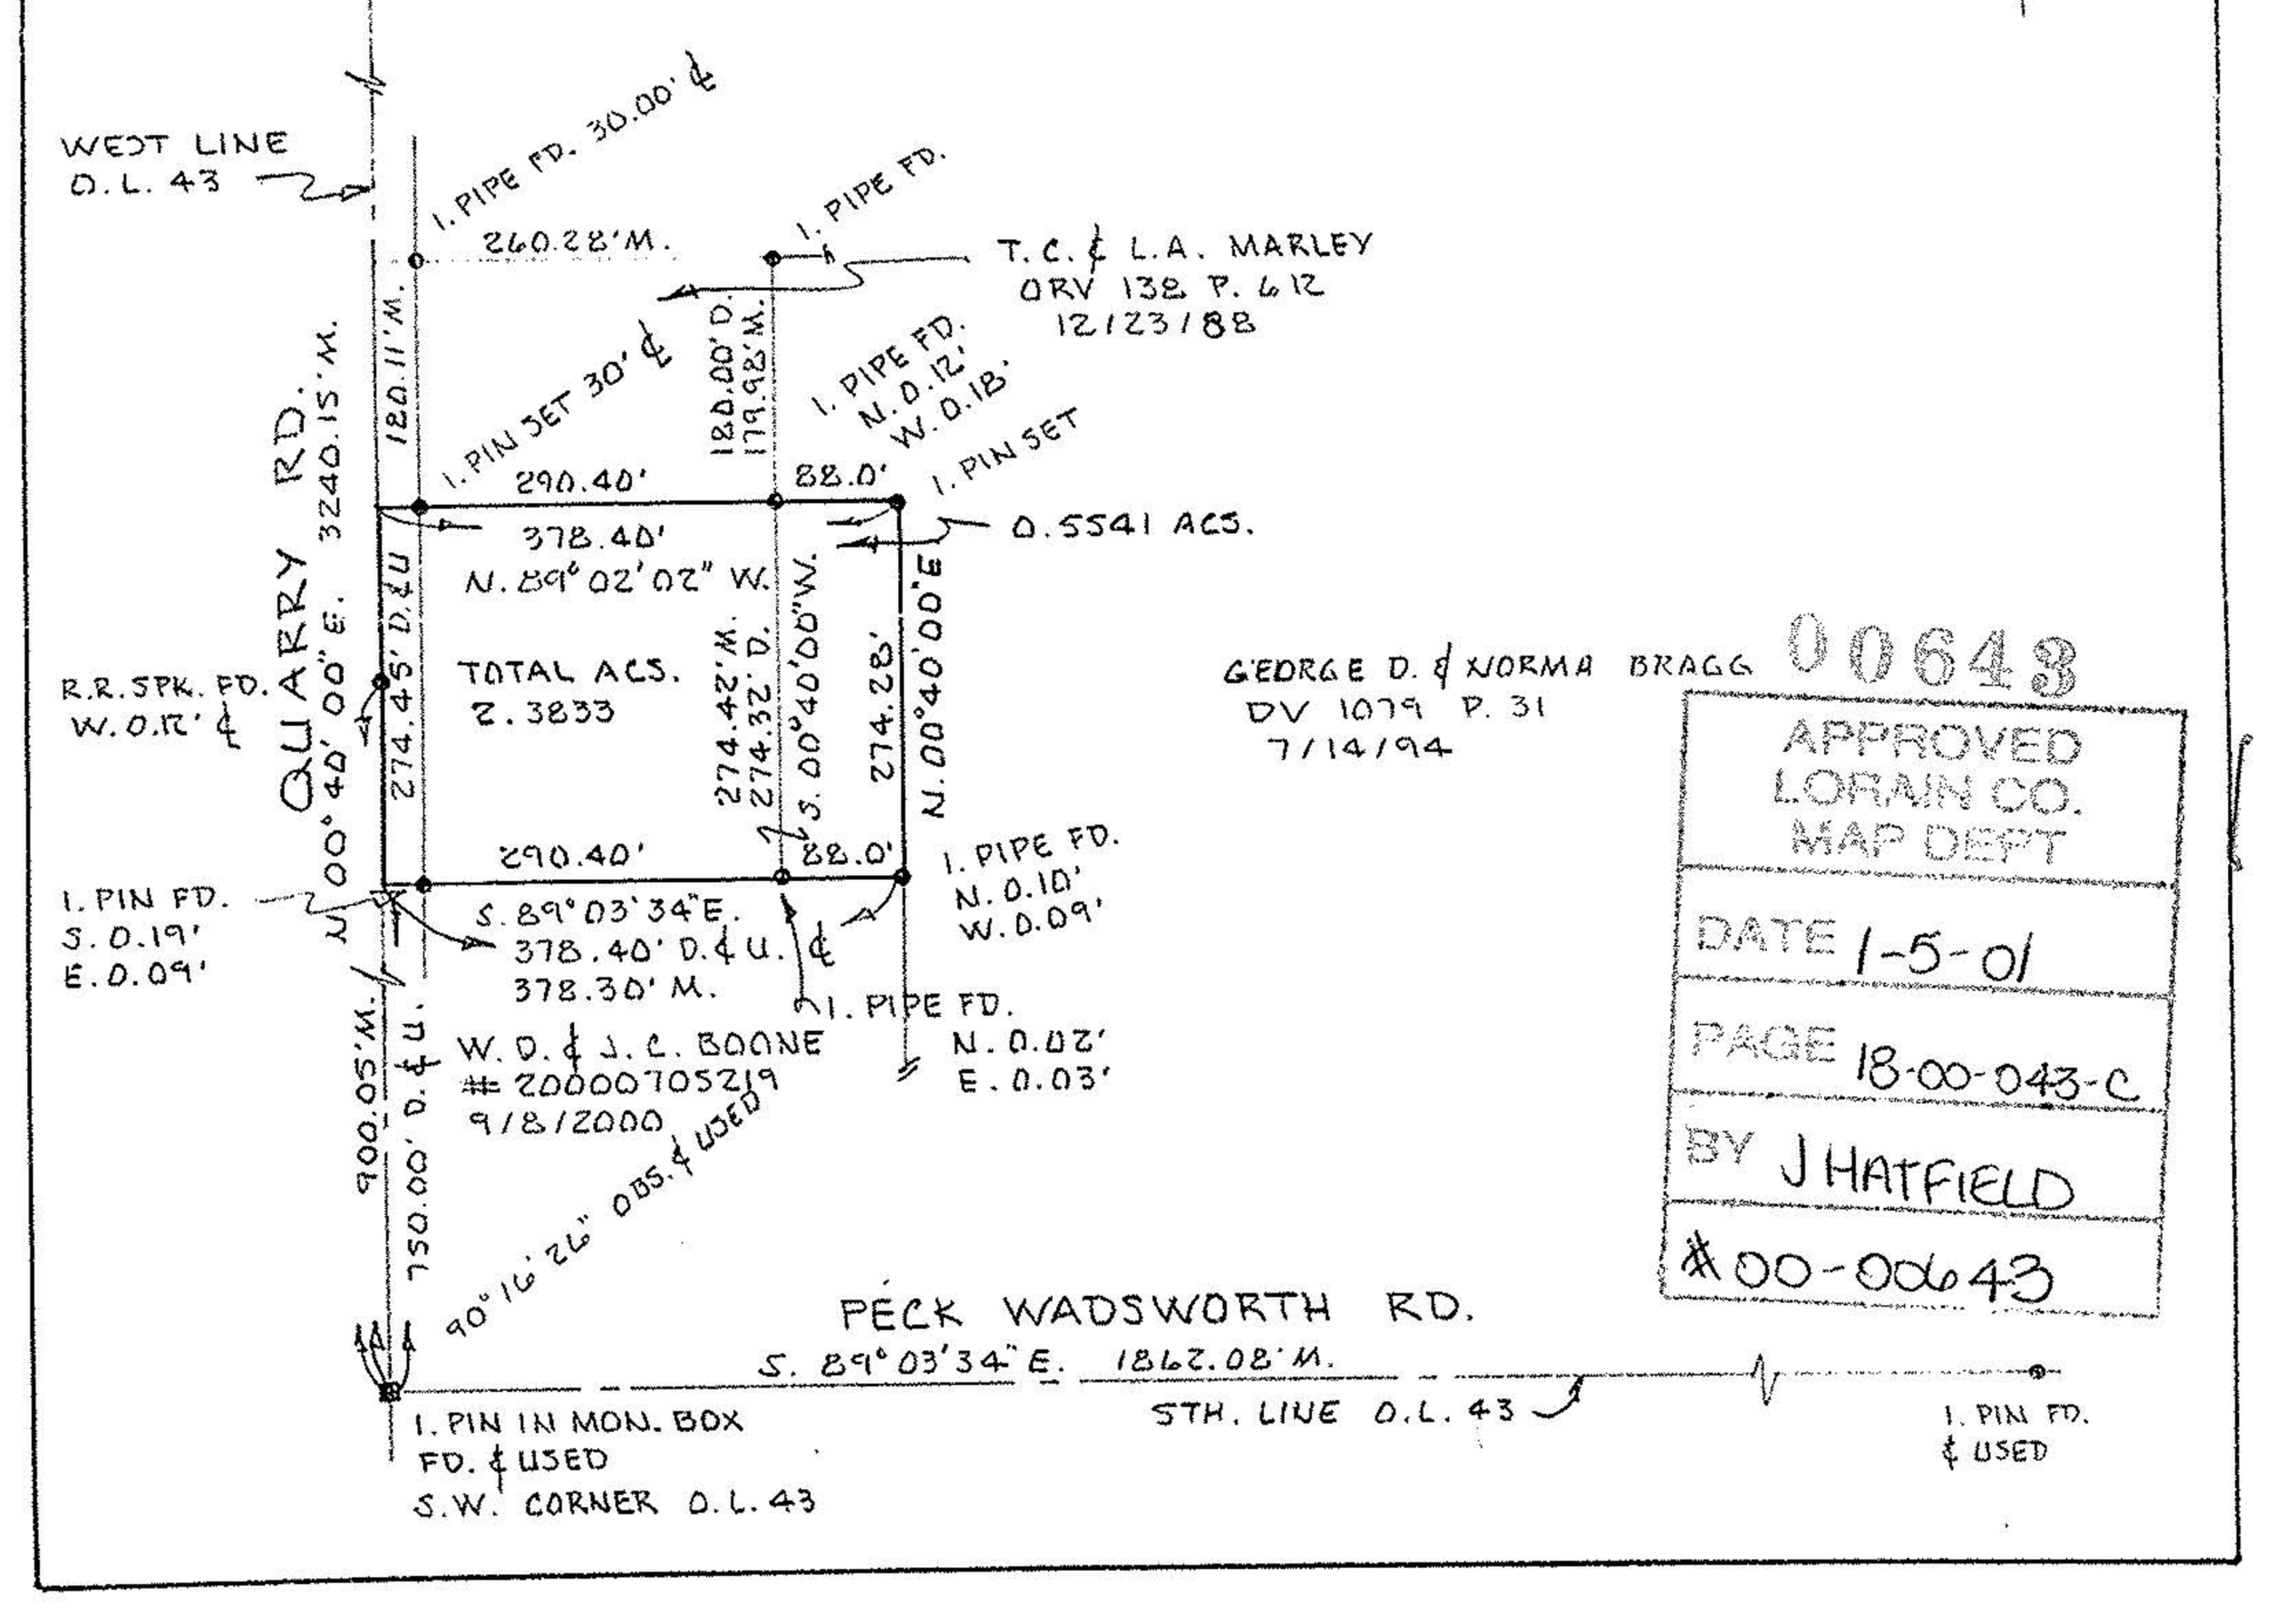


00643

APPROVED
LORAIN CO.
MAP DEPT

DATE 1-5-01

PAGE 18-00-043-C

BY J HATFIELD

# 00-00643