


18-7

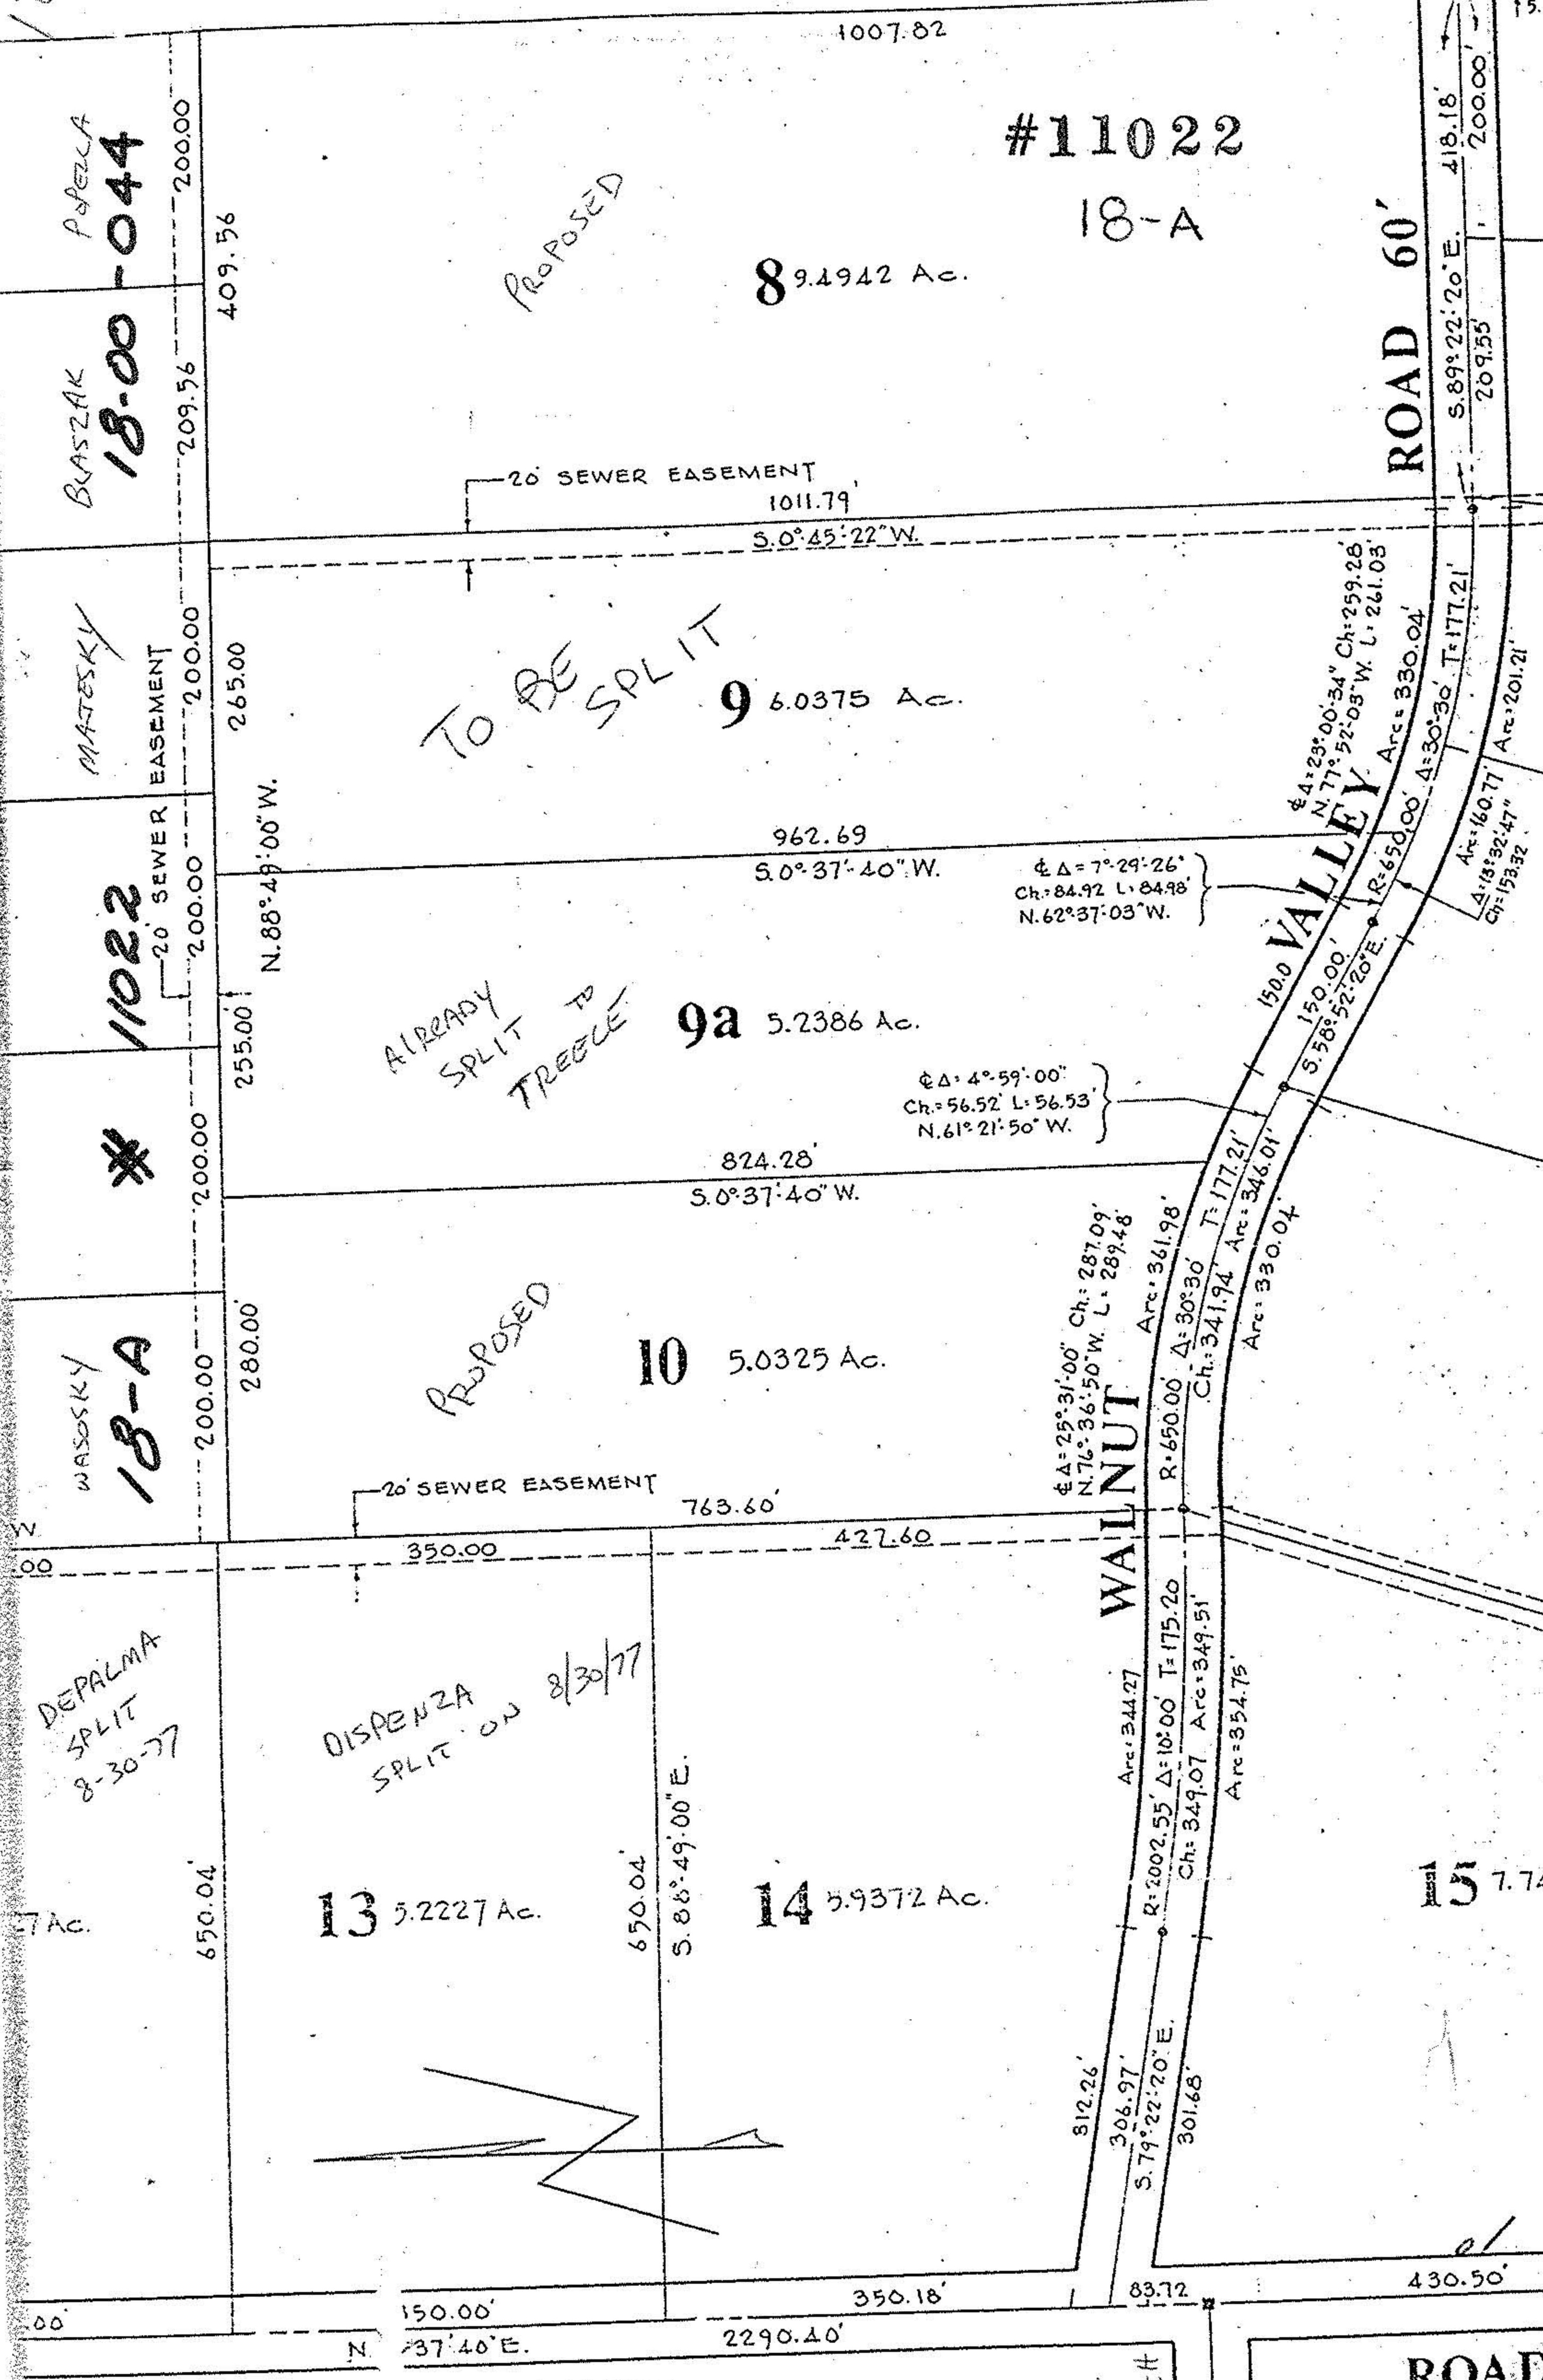

BLASZAK  
18-00-044

#11022  
18-A

8 9.4942 Ac.

TO BE SPLIT  
9 6.0375 Ac.

#11022

ALREADY SPLIT TO TREE  
9a 5.2386 Ac.

#

10 5.0325 Ac.

WASOSKY  
18-A

DEPALMA  
SPLIT  
8-30-77

DISPENZA  
SPLIT ON 8/30/77

13 5.2227 Ac.

14 5.9372 Ac.

15 7.742

QUARRY

ROAD