


#12632

# 18-00-044-000-056  
18-00-044-C = 057

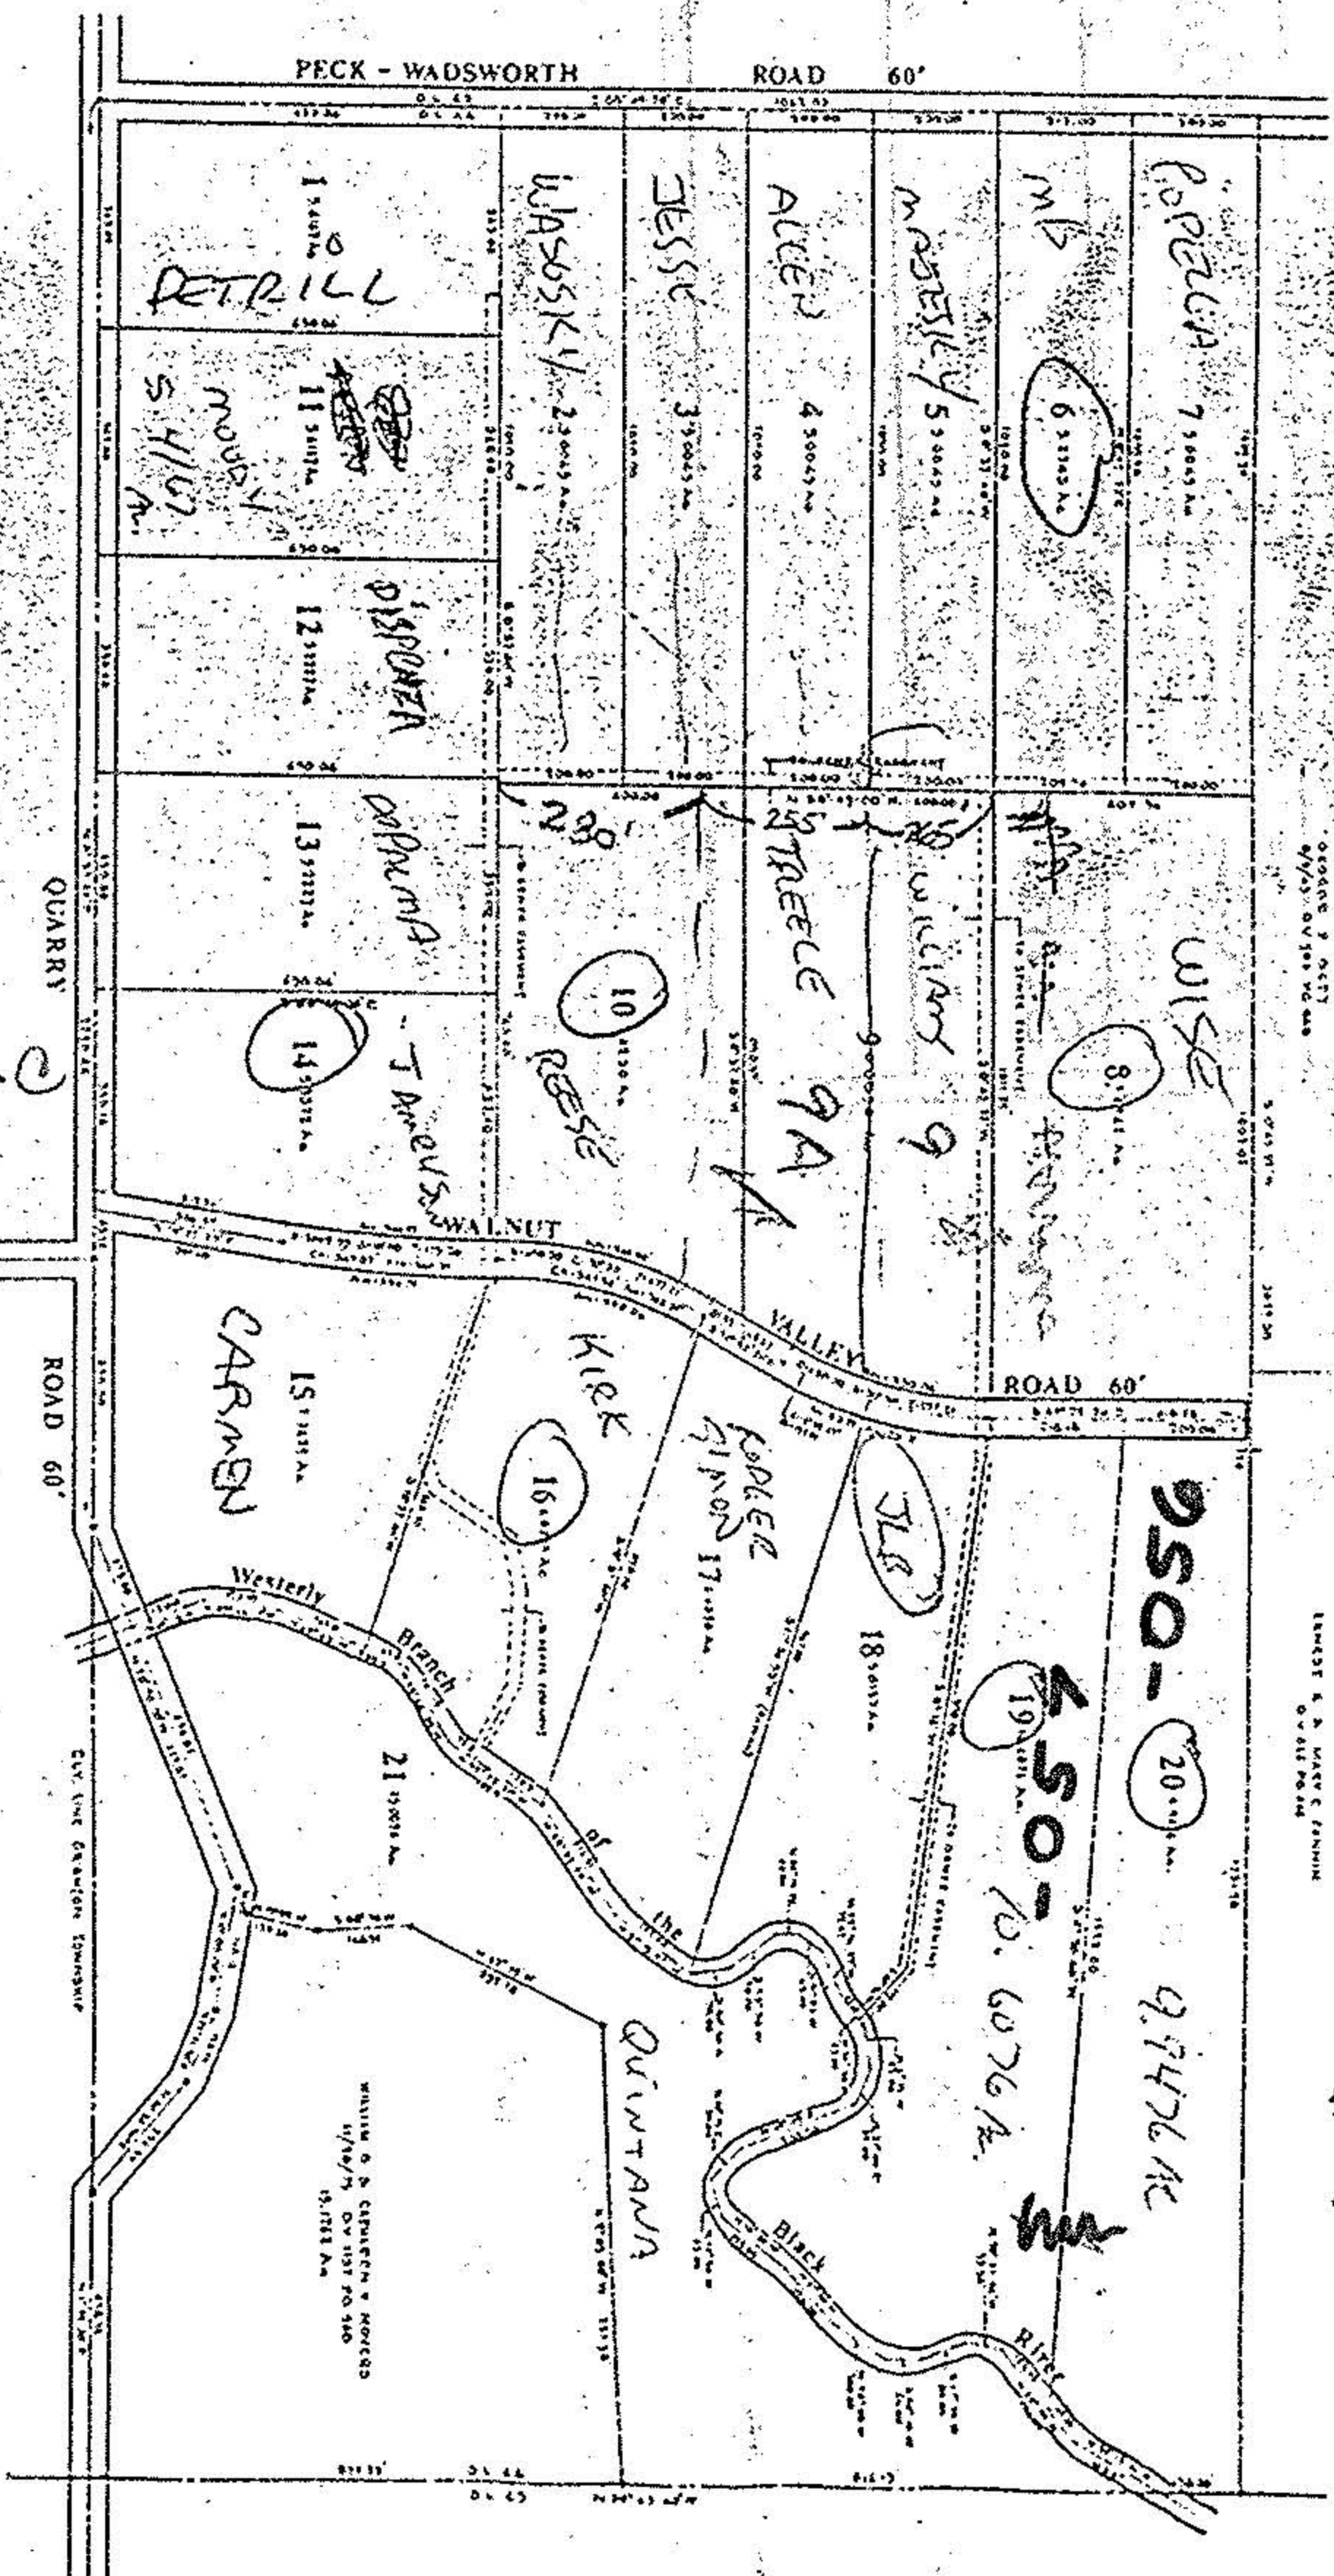

#12632

APPROVED	
LORAIN CO.	
MAP DEPT.	
DATE	4-25-79
PAGE	18-00-044-C
BY	Carolyn F
VOID AFTER	12632

RIVER RANCH  
ACRES

O.L. 44 WELLINGTON TWP.  
LORAIN COUNTY OHIO  
SCALE 1"=50' OCTOBER, 1976



Walter S. P. Mayer & Associates  
Engineers  
Surveyors

18-00-044-C