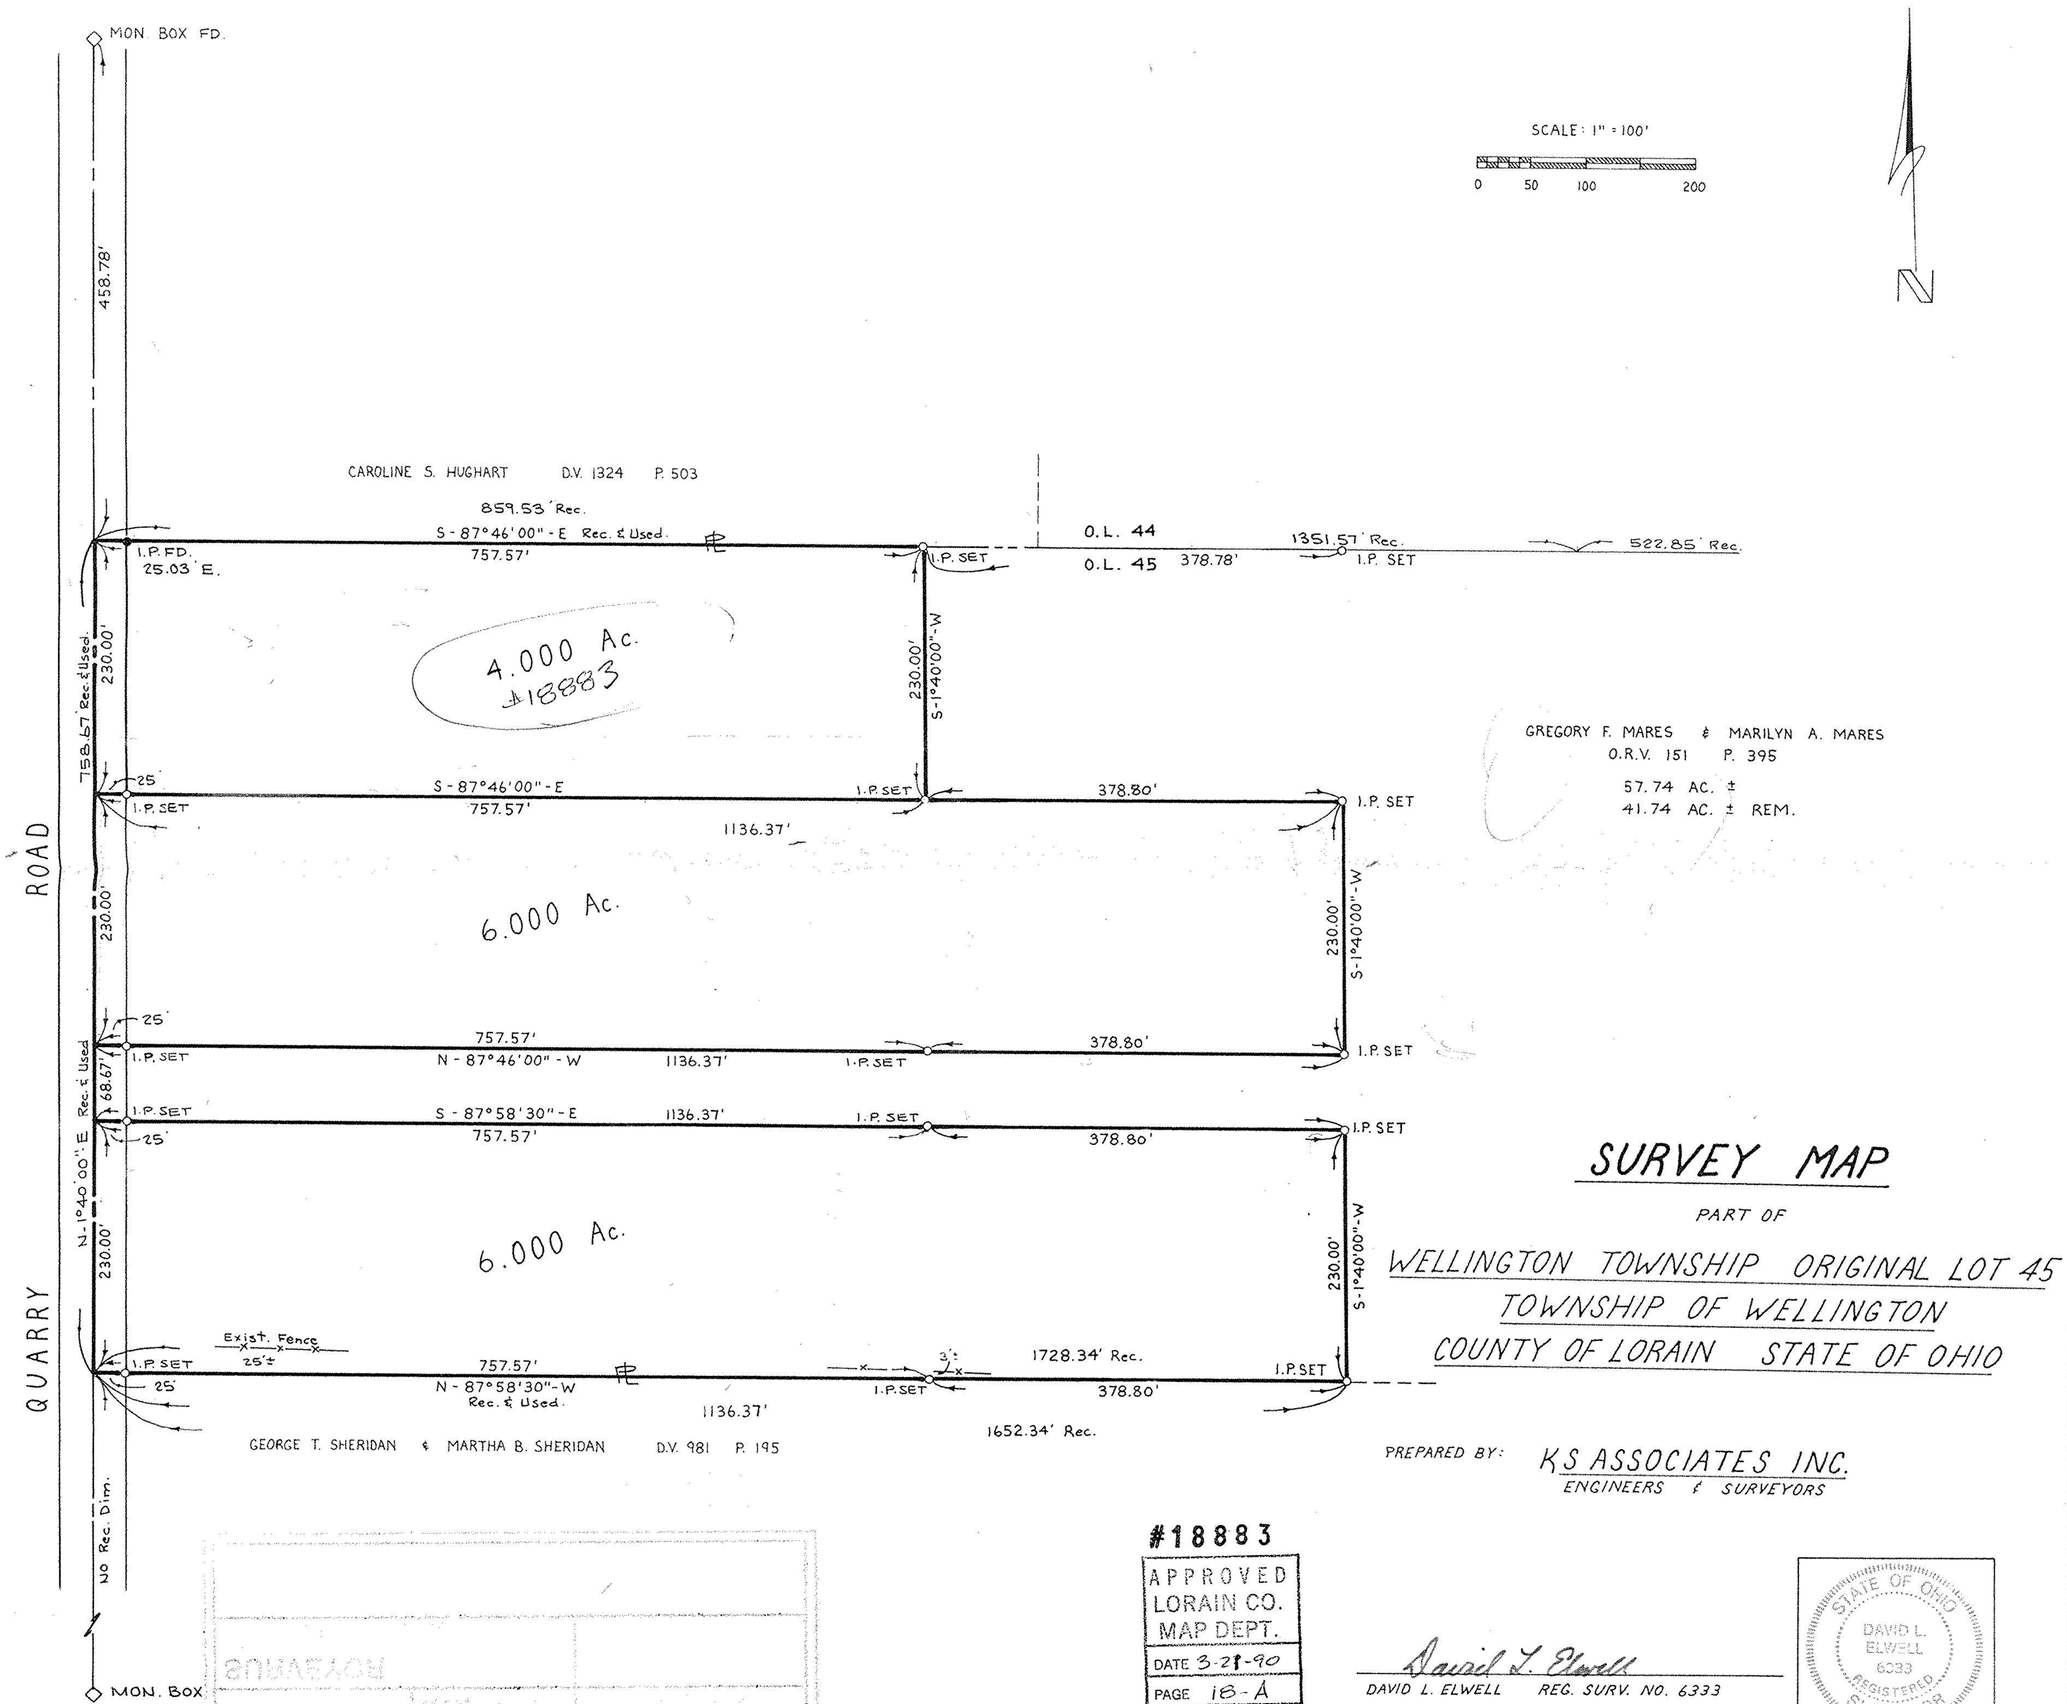

SURVEY MAP

PART OF

WELLINGTON TOWNSHIP ORIGINAL LOT 45
TOWNSHIP OF WELLINGTON
COUNTY OF LORAIN STATE OF OHIO

PREPARED BY: KS ASSOCIATES INC.
ENGINEERS & SURVEYORS

#18883

APPROVED
LORAIN CO.
MAP DEPT.
DATE 3-21-90
PAGE 18-A
BY T. McNair
VOID AFTER 18883

David L. Elwell
DAVID L. ELWELL REG. SURV. NO. 6333
REV. JAN. 31, 1990

STATE OF OHIO
DAVID L. ELWELL
6333
REGISTERED SURVEYOR

89-575