19-03-014-000
19-03-015-00

146
R.S. Sherrill
458-6116
Lagrange

19-G

SURVEY OF PART OF ORIGINAL LOT 15 PENFIELD TWP

COUNTY OF LORAIN STATE OF OHIO

PREPARED FOR
RALPH SHERRILL
LA GRANGE, OHIO

PREPARED BY
J.R. [illegible] AR & ASSOCIATES
[illegible] PENFIELD TOWNSHIP
[illegible] INDEXVILLE, OHIO

19-03-014-000 —
19-03-015-00

19-G

19-G

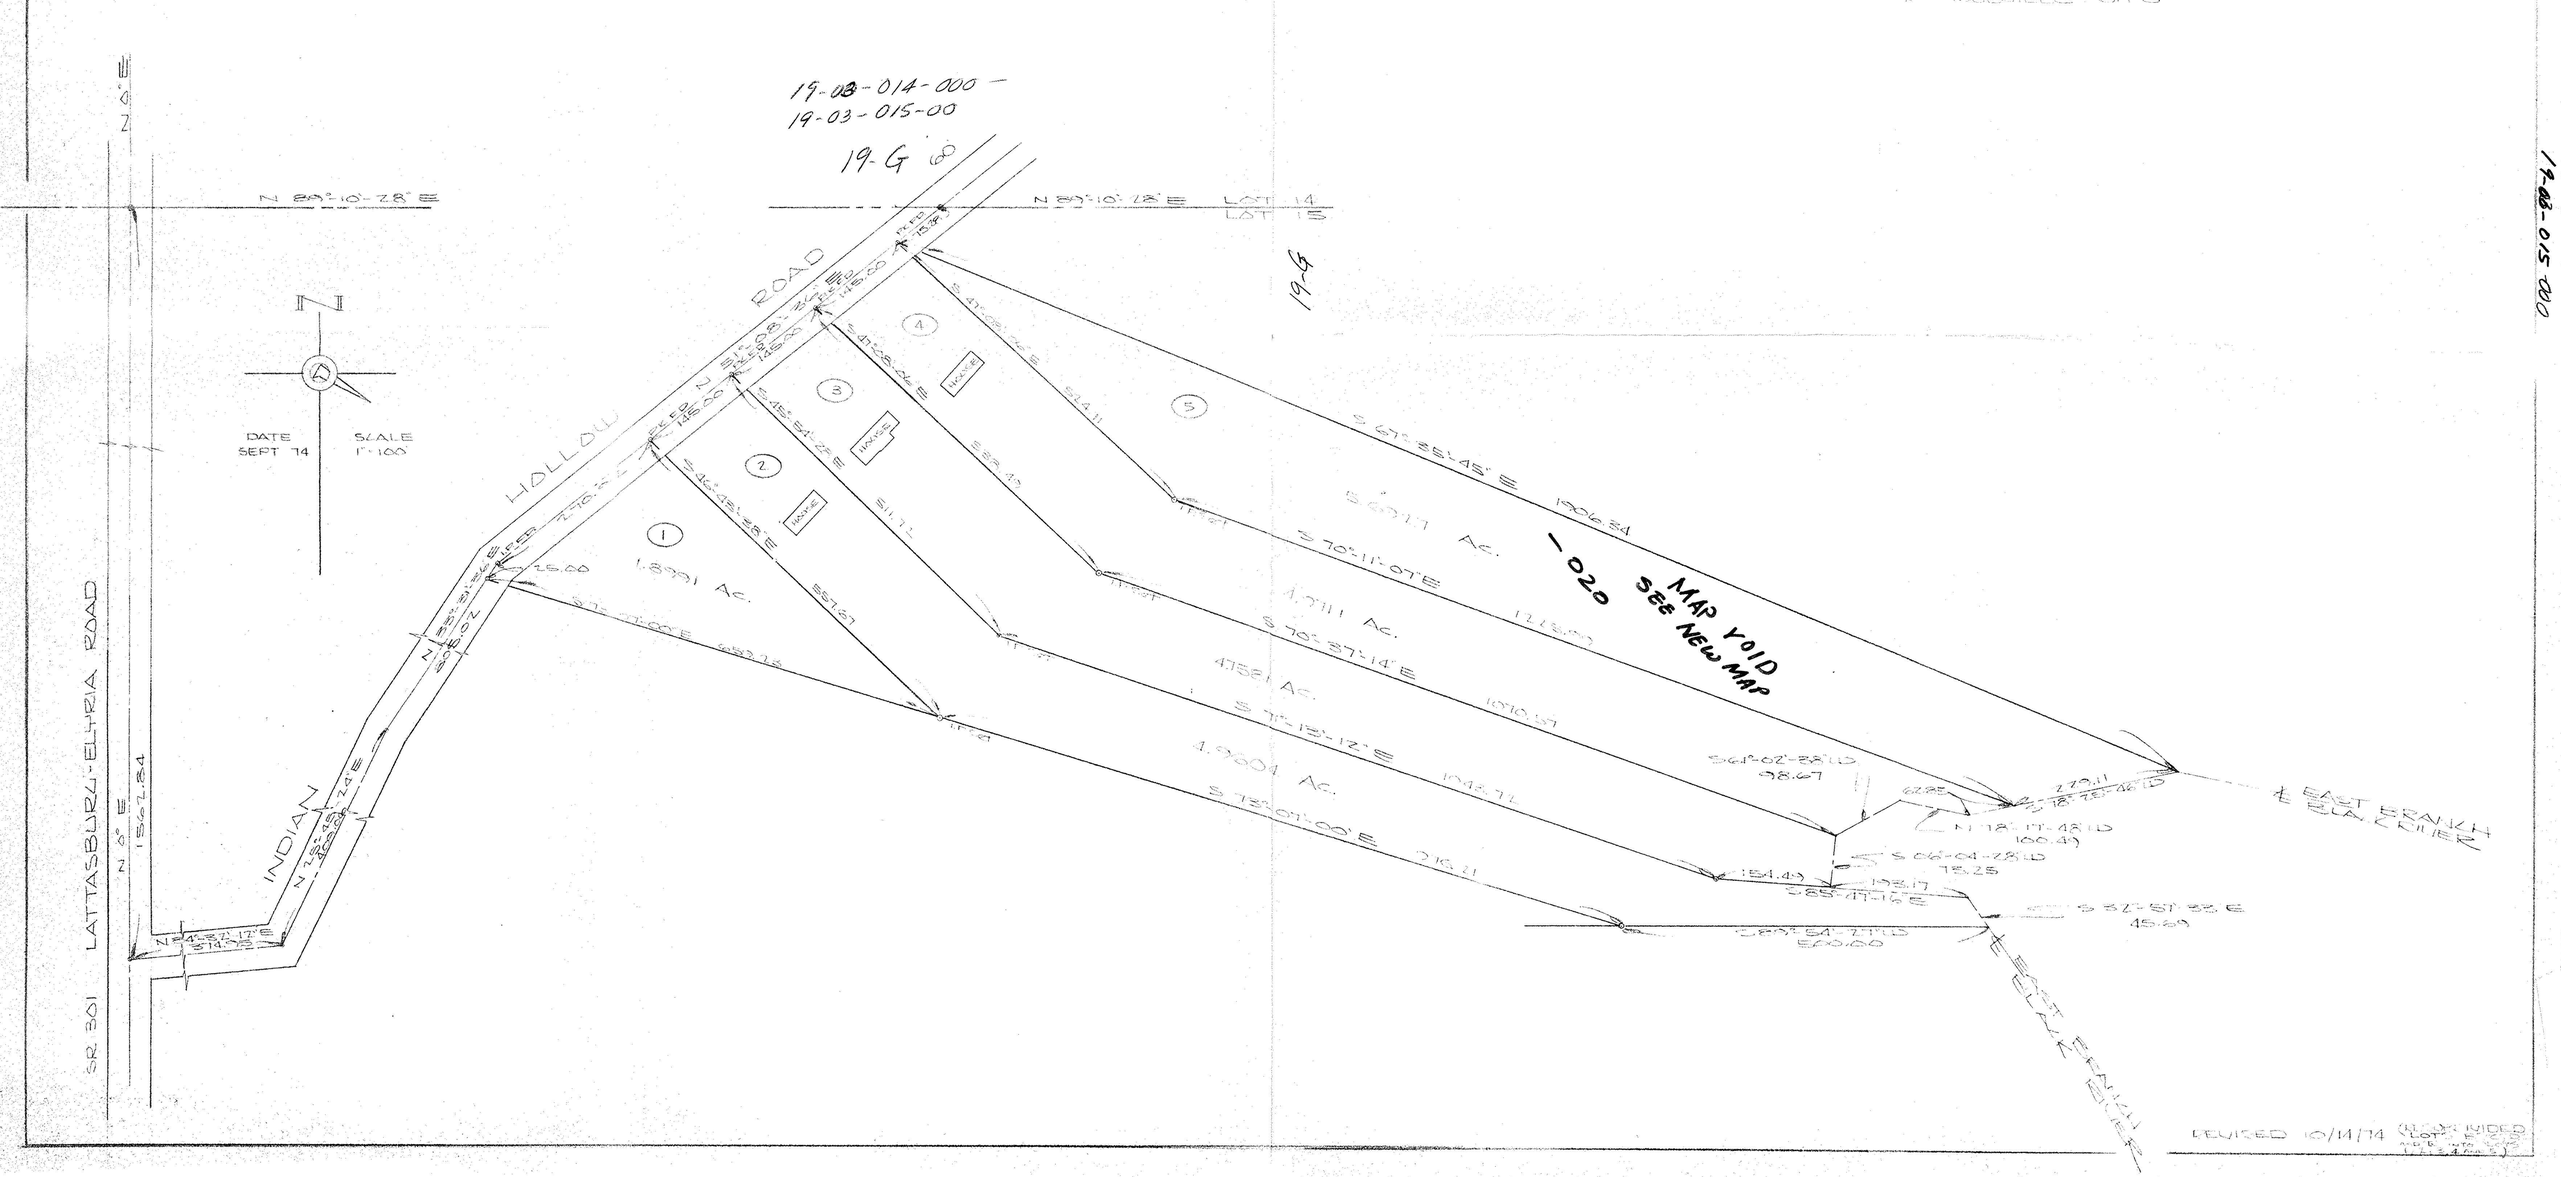

REVISED 10/14/74 (NOTE INDEX LOTS 5 & 6 NOT SHOWN)

19-03-014-000
19-03-015-000