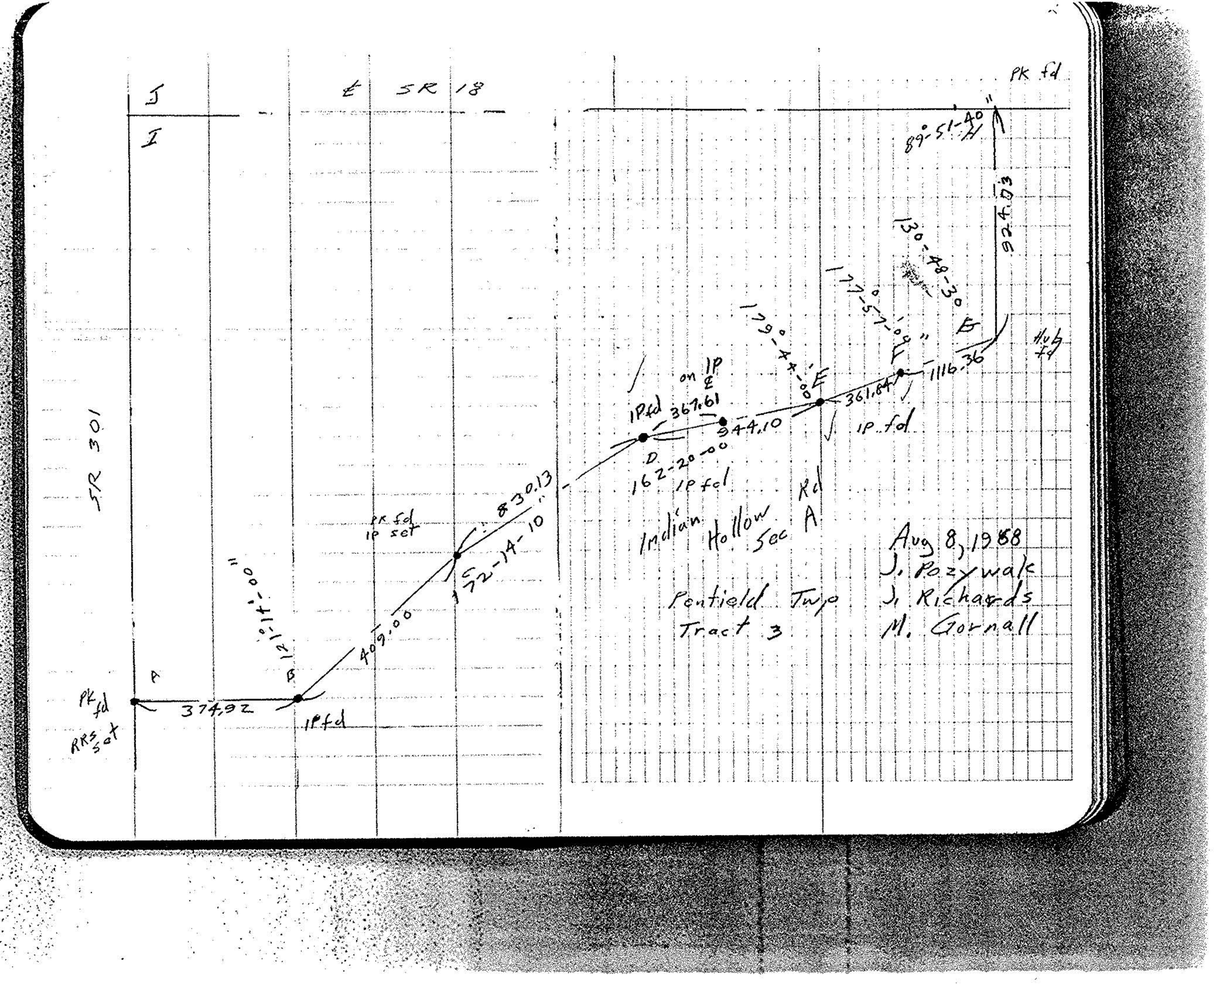

MAP OF SURVEY FOR GORDY HALES
O.C. 15 - TRACT 3 - PENFIELD TWP. - LORAIN CO.
MAY 1991 REV. 5/18 SCALE 1" = 100'
JOHN R. HAMILTON - REG. SURVEYOR #6861

19436

LARRY JACKSON
DEED VOL. 1380 P. 451
12.73 AC. DUP.
7.809 AC. REM.

19-03-015-000

NORTH
SCALE 1" = 100'

N1°26'E
HERMAN DULL
DEED VOL. 1345, P. 113

661.40 S89°10'E
407.60'
253.8'
146.60'
IP SET
IP FD.

PARCEL #3A
0.728 AC.
025

PARCEL #3
1.348 AC.
022

125.00'
N0°50'E
125.00'
253.8'
250.54'
93.35'
160.45'
N89°10'W
IP SET

℄ INDIAN HOLLOW RD. (R/W WIDTH NOT ESTABLISHED)
120.0'
108.94'
IP FD.

PARCEL #2A
0.268 AC.
030

PARCEL #2
1.329 AC.
029

N0°50'E
125.00'
125.00'
N0°50'E
113.08'
N37°20'W
120.0'
125.00'
N52°40'E
367.57'

443.60'
350.25'
S89°10'E
93.35
52.35'
N37°20'W

PARCEL #1
1.248 AC.
023

125.00'
370.00'
N89°10'W
133.63'
REBAR FD.
REBAR SET
24.00'
1.55'
N35°03'E

JOHN + EDNA YOHO D.V. 521, P. 450

STATE OF OHIO
JOHN R. HAMILTON
6861
REGISTERED PROFESSIONAL SURVEYOR

℄ INFORMATION PER COUNTY ENGINEER'S FIELD BOOK VOL. 258 P. 2