


19-H
19-03-051-000

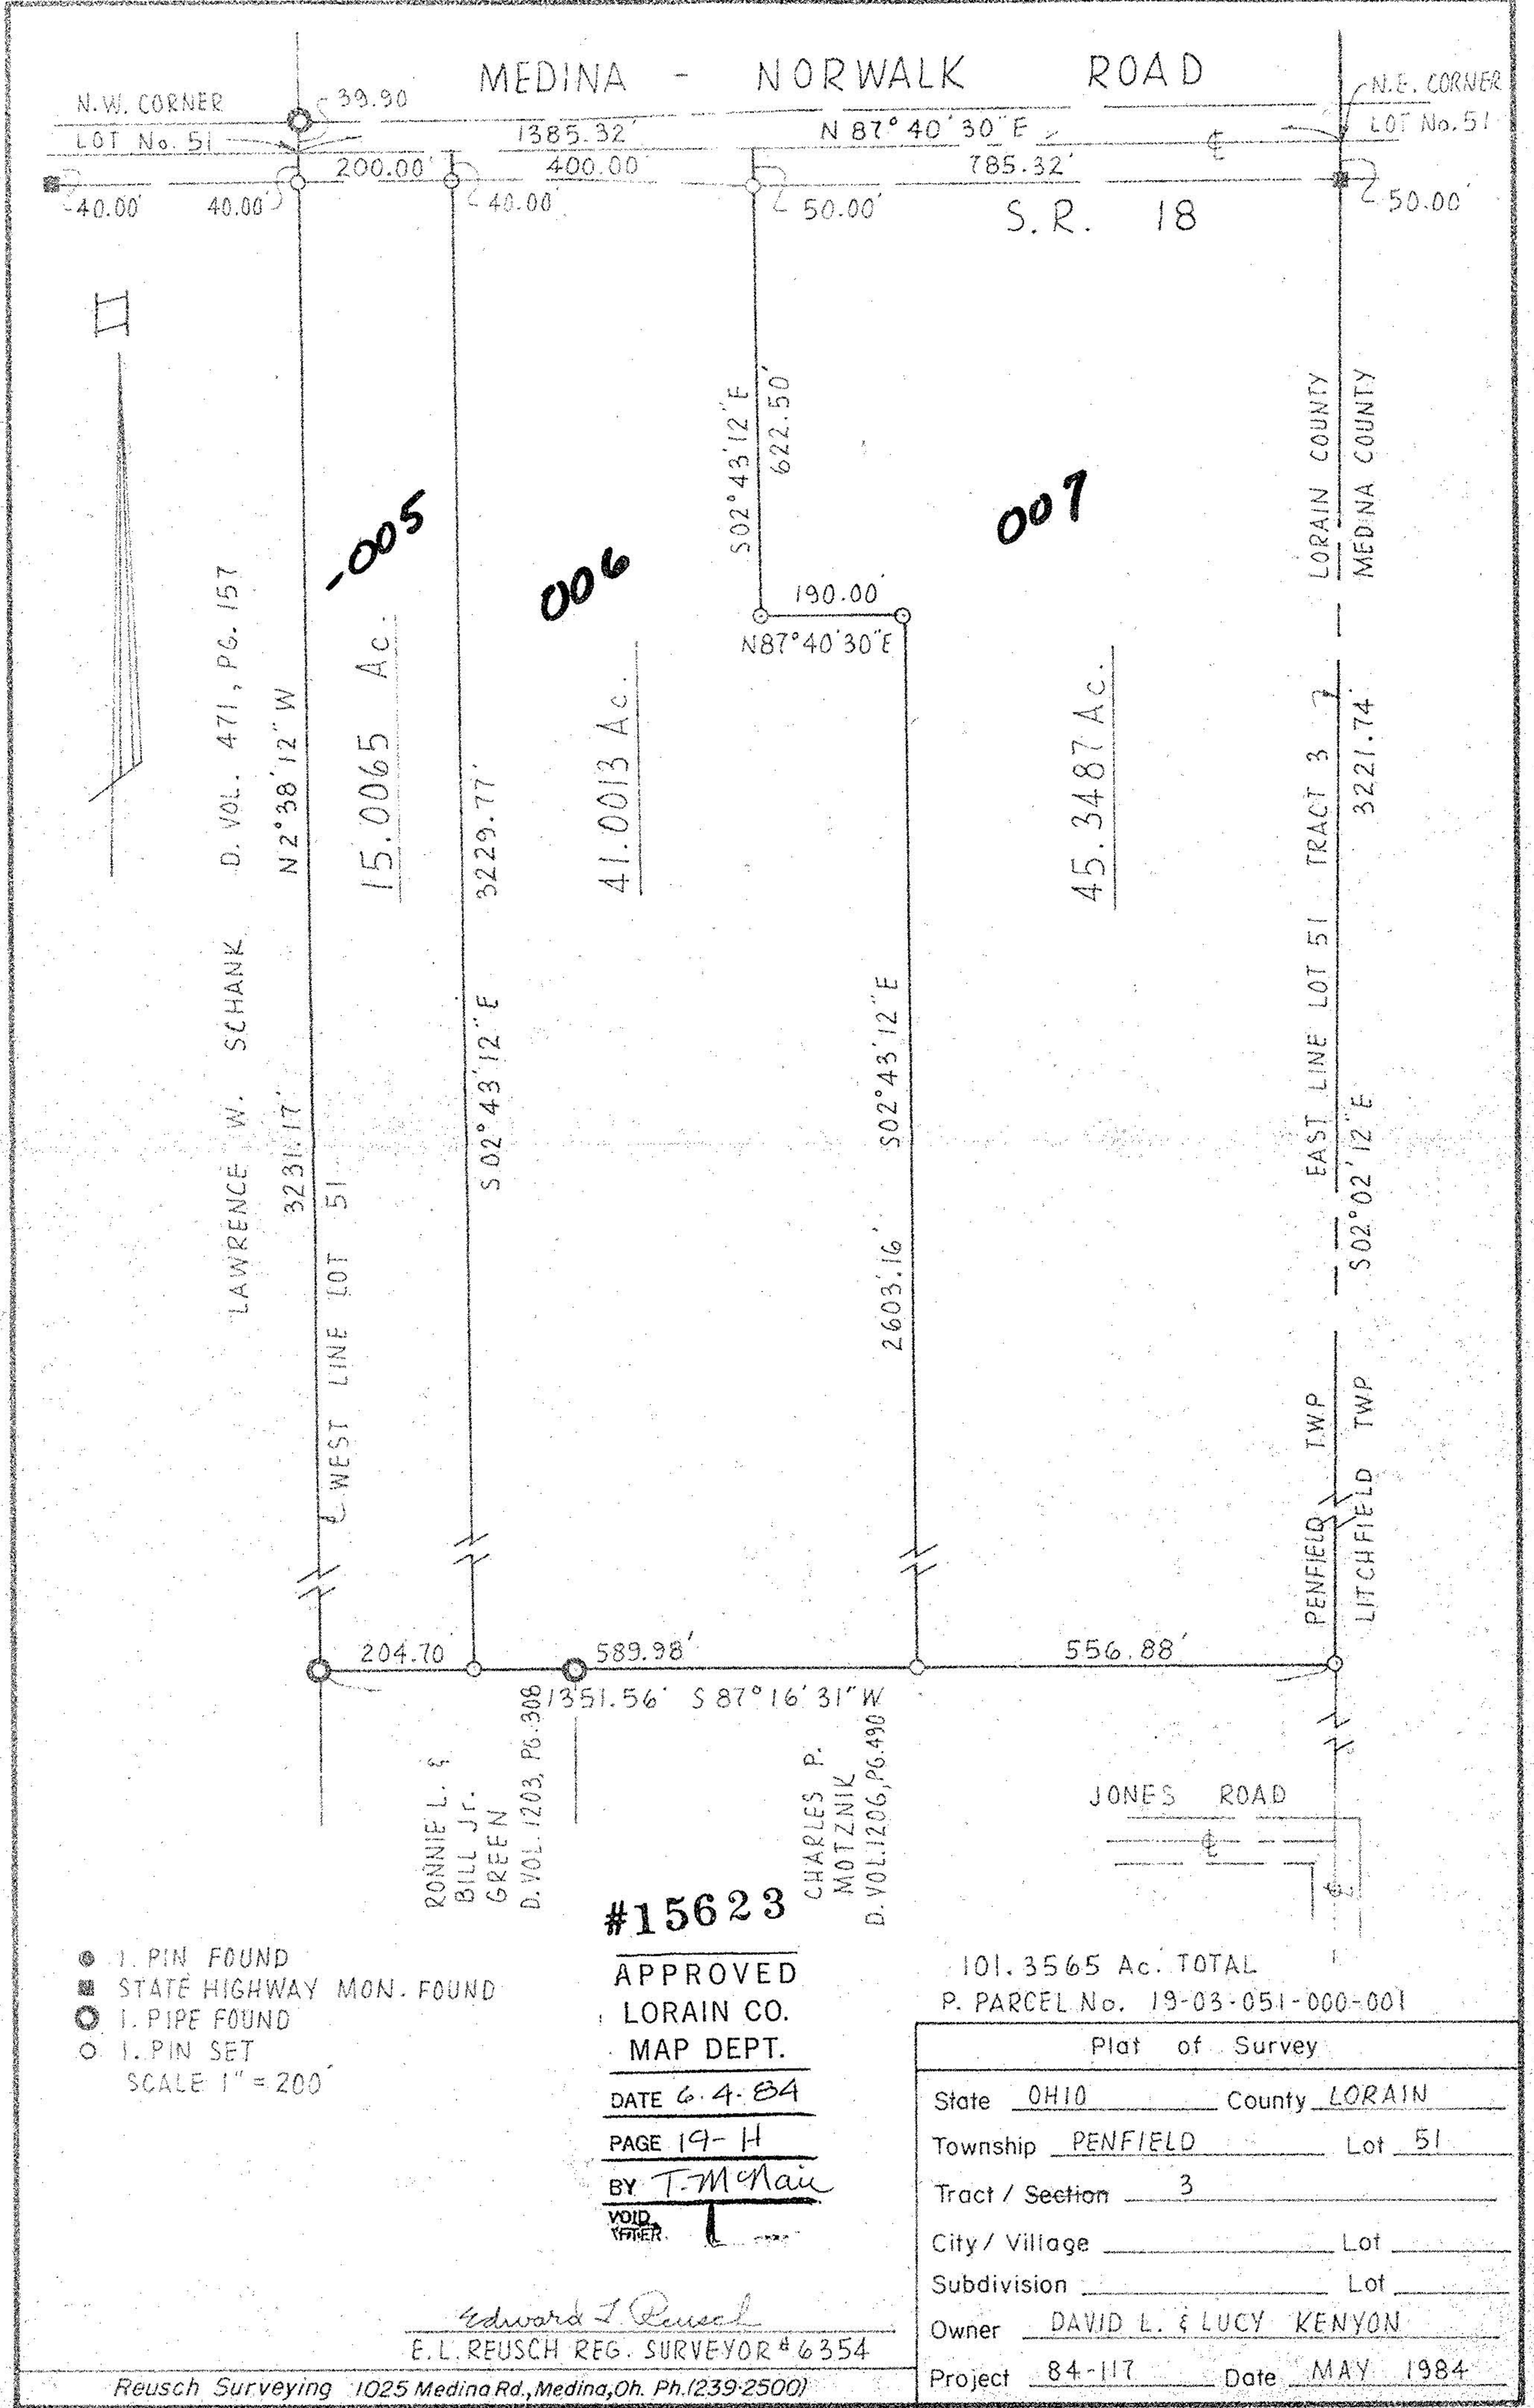

- 1. PIN FOUND
 - STATE HIGHWAY MON. FOUND
 - 1. PIPE FOUND
 - 1. PIN SET
- SCALE 1" = 200'

#15623

APPROVED
LORAIN CO.
MAP DEPT.

DATE 6-4-84

PAGE 19-H

BY T. McNair

VOID AFTER

Edward J. Reusch
E.L. REUSCH REG. SURVEYOR # 6354

101.3565 Ac. TOTAL
P. PARCEL No. 19-03-051-000-001

Plat of Survey	
State	OHIO County LORAIN
Township	PENFIELD Lot 51
Tract / Section	3
City / Village	Lot
Subdivision	Lot
Owner	DAVID L. & LUCY KENYON
Project	84-117 Date MAY 1984