MAP OF SURVEY AND LOT SPLIT

BY AND FOR

DONALD A. JACKSON AND KELLY J. KAUFMAN

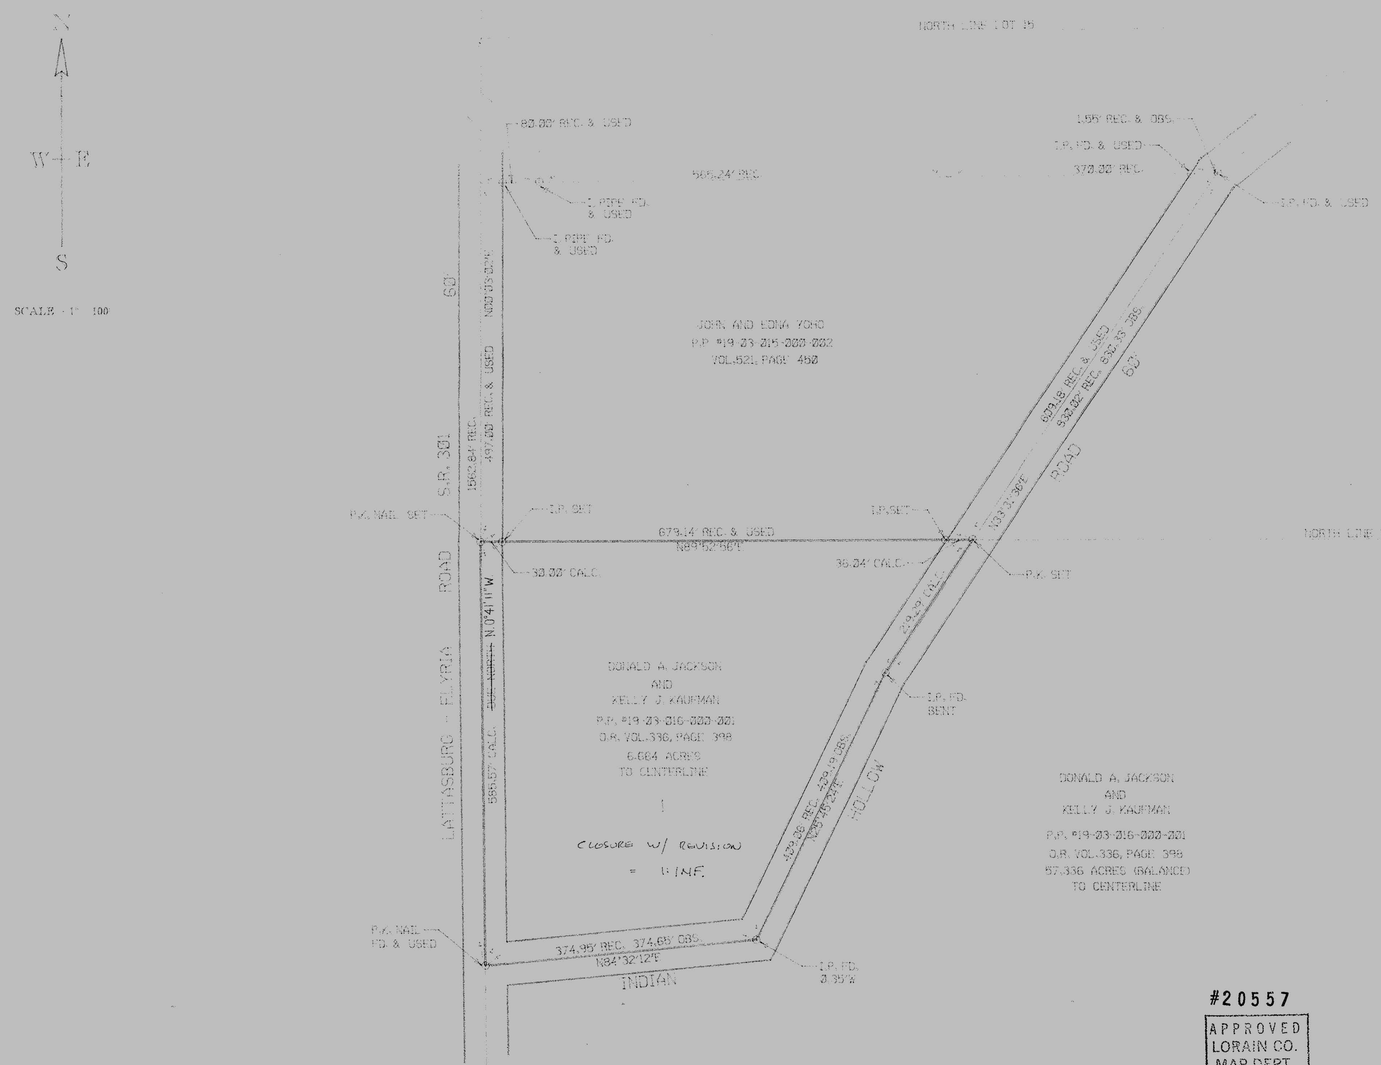

SURVEYOR'S STATEMENT

[illegible]

Thomas M. Snezek 9-10-93

THOMAS M. SNEZEK, P.S. [illegible]

STATE OF OHIO
THOMAS M. SNEZEK
S-7051
SURVEYOR

#20557

APPROVED LORAIN CO. MAP DEPT.
DATE 10-19-93
PAGE 19-G
BY T. McNair
VOID AFTER 20557

9317