LOT SPLIT MAP FOR
BILL & SANDEE REGAL

SITUATED IN THE TOWNSHIP OF PENFIELD, COUNTY OF LORAIN, STATE OF OHIO, AND KNOWN AS BEING PART OF ORIGINAL PENFIELD TOWNSHIP LOT No. 3, SECTION No. 4.
DEED REFERENCE - VOL. 597, PG. 416

APPROVALS:

BY: _____ DATE: _____
TOWNSHIP OF PENFIELD

DISTANCES ARE GIVEN IN FEET AND DECIMAL PARTS THEREOF. COURSES ARE GIVEN TO AN ASSUMED MERIDIAN AND ARE USED TO INDICATE ANGLES ONLY. ALL OF WHICH I CERTIFY TO BE CORRECT.

RICHARD M. KOLE
P.S. 6258

STATE OF OHIO * RICHARD M. KOLE 6258 * REGISTERED PROFESSIONAL SURVEYOR

NORTH.

SCALE: 1" = 100'
MARCH, 1992

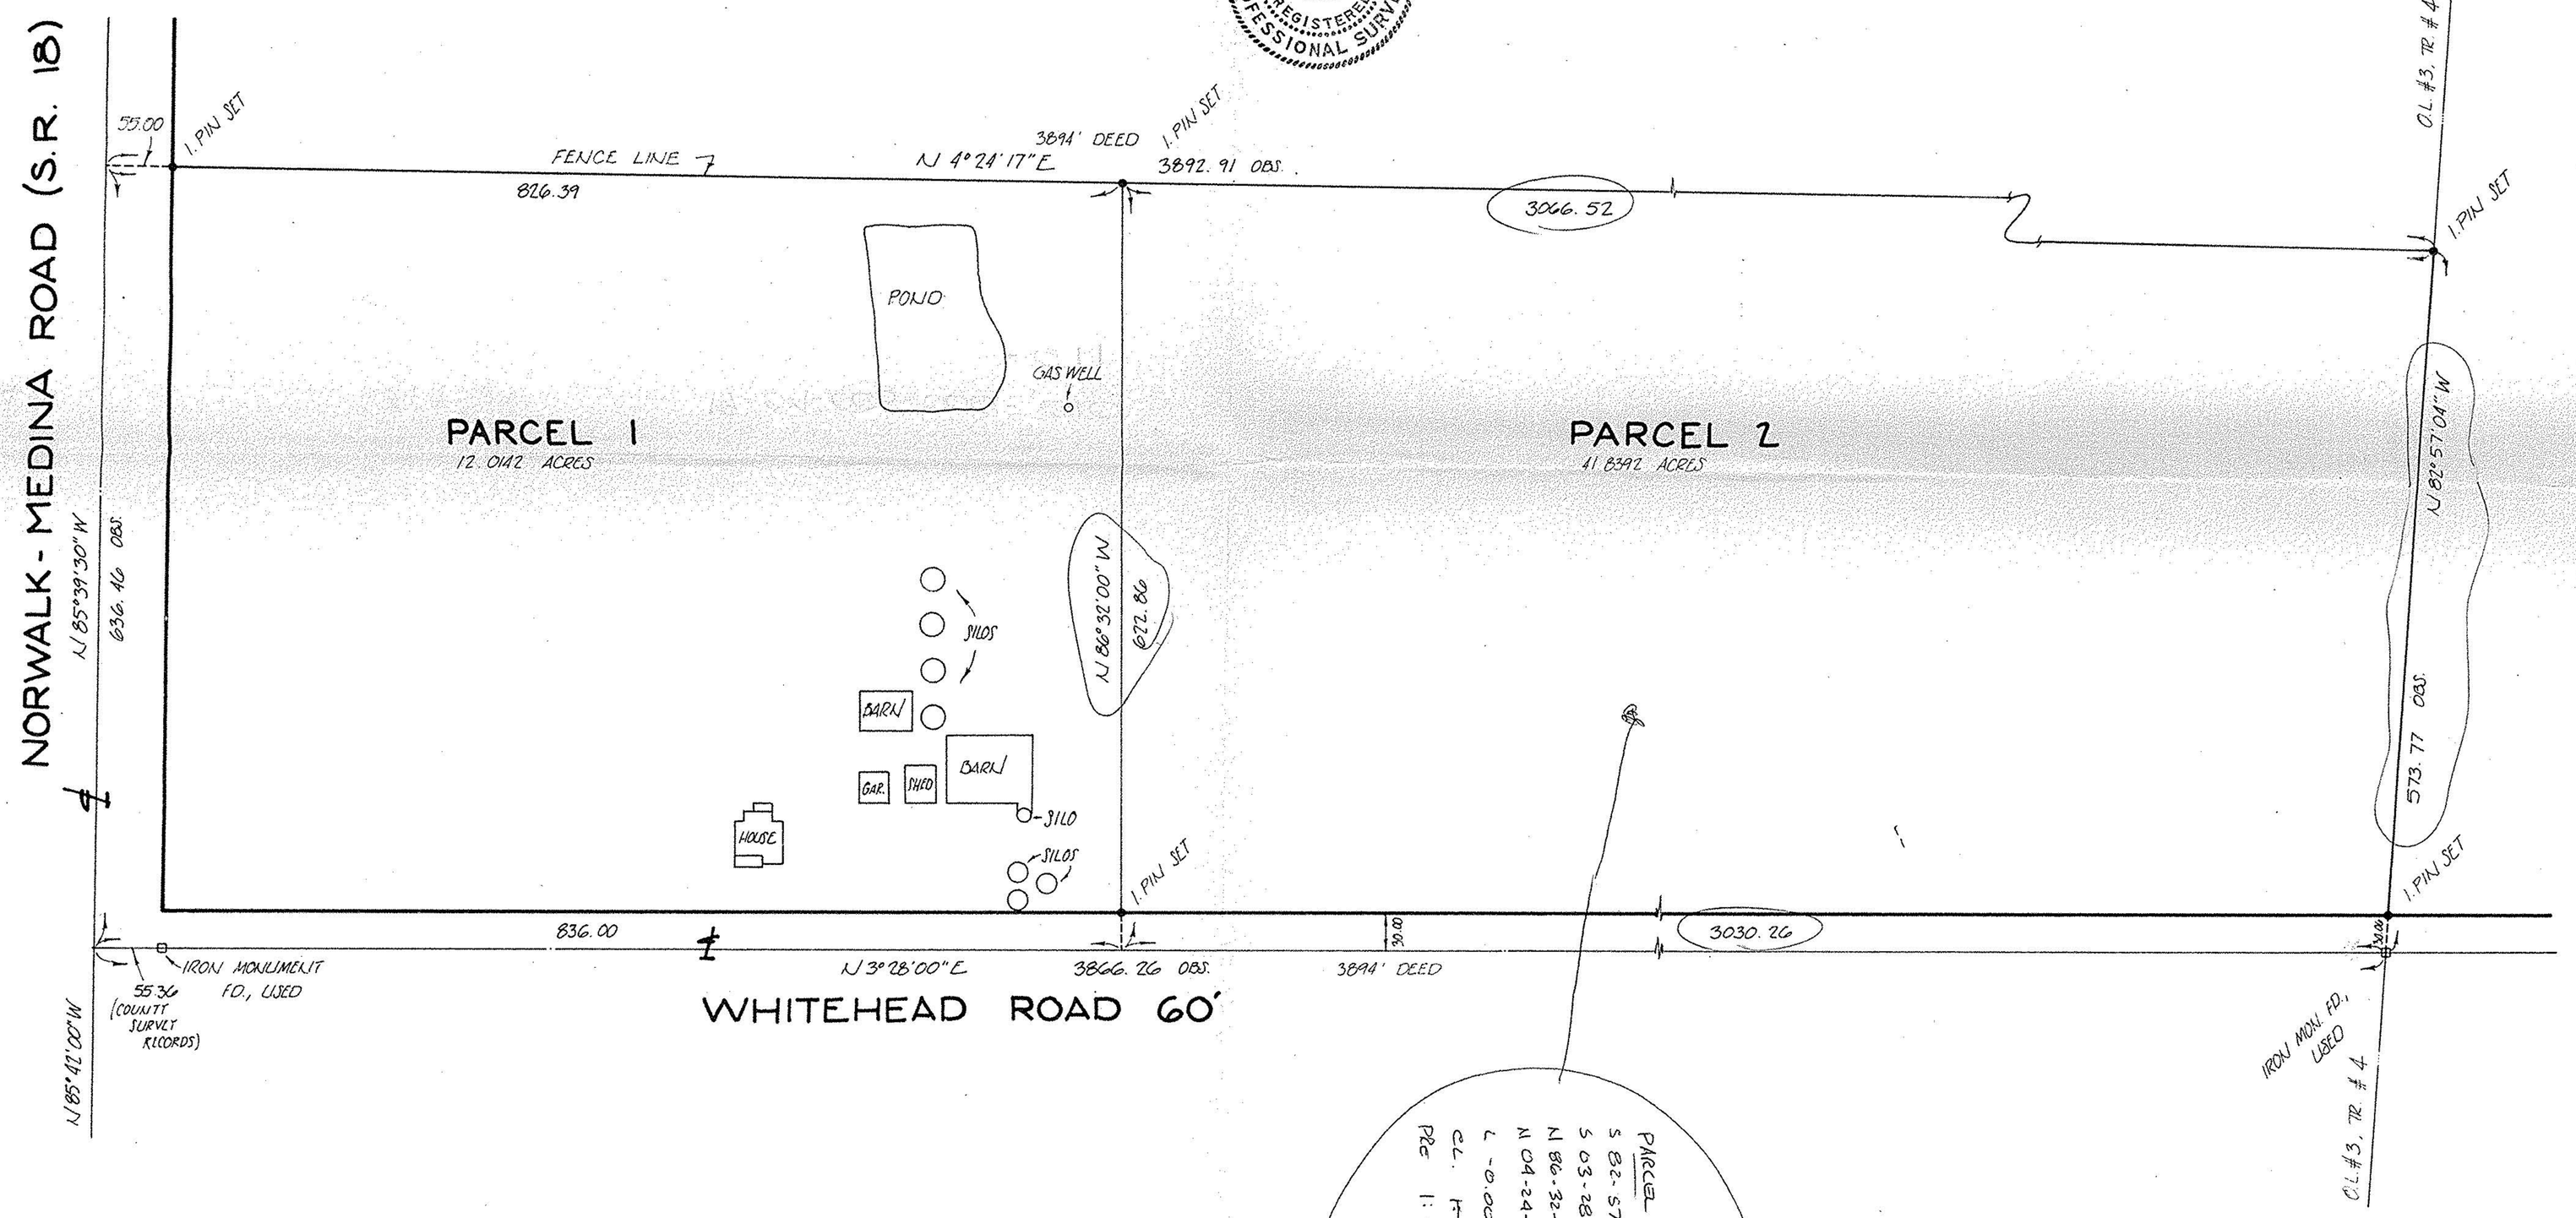

#19834
APPROVED
LORAIN CO.
MAP DEPT.
DATE 3-27-92
PAGE 19-A
BY T. McMahon
VOID AFTER
19834

R.M. KOLE & ASSOC., INC.
PROFESSIONAL LAND SURVEYORS
9701 BROOKPARK ROAD · SUITE 251
CLEVELAND, OHIO 44129
PHONE (216) 741-3232

97.7.35