


MAP OF SURVEY AND LOT SPLIT


PREPARED FOR

LOIS JEAN DAVIS


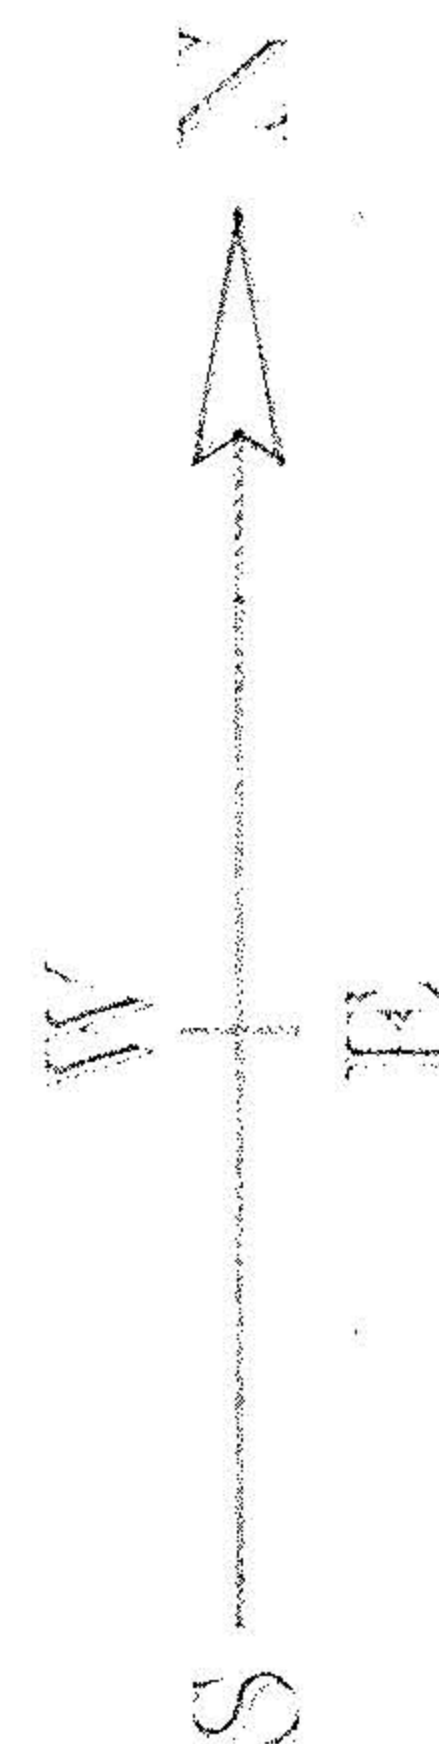

SCALE 1" = 100'

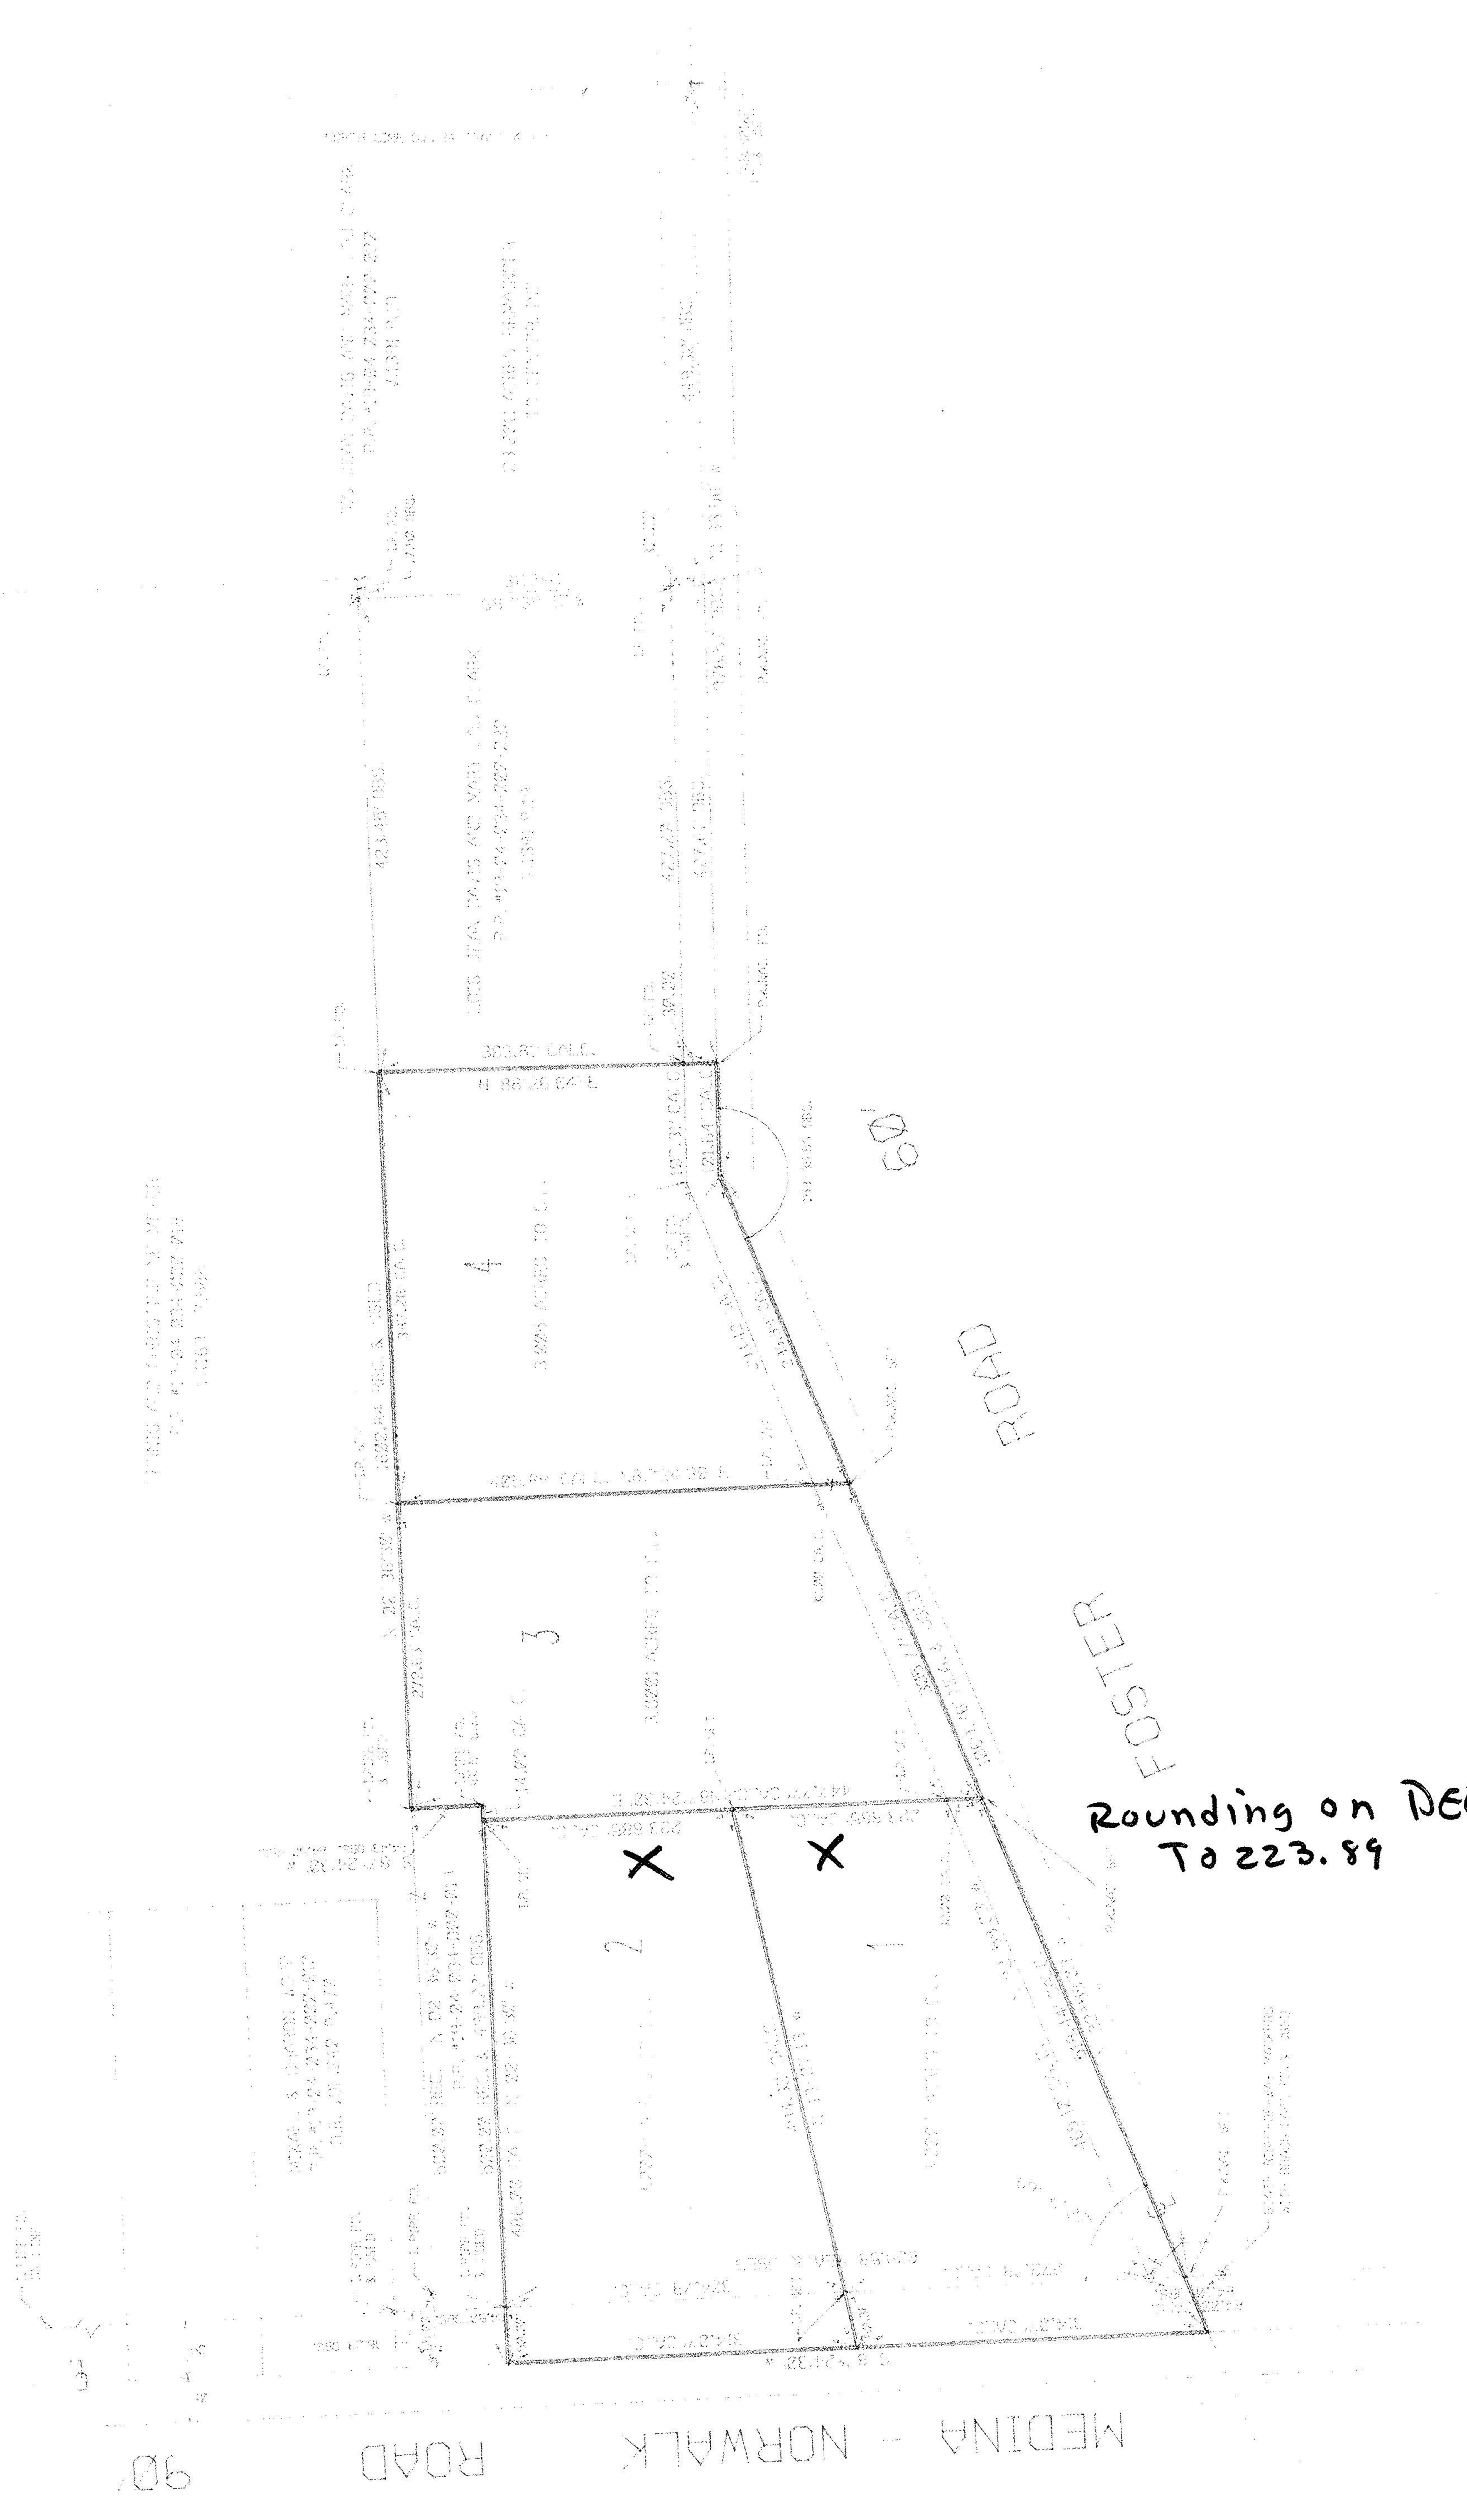


SURVEYORS STATEMENT



Thomas R. Snyder

A-3-93

 

13-04-034-000

20413
APPROVED
LORAIN CO.
MAP DEPT.
DATE 7-1-93
PAGE 19-C
BY CAROLYN
FRANCK
VOID AFTER 20413