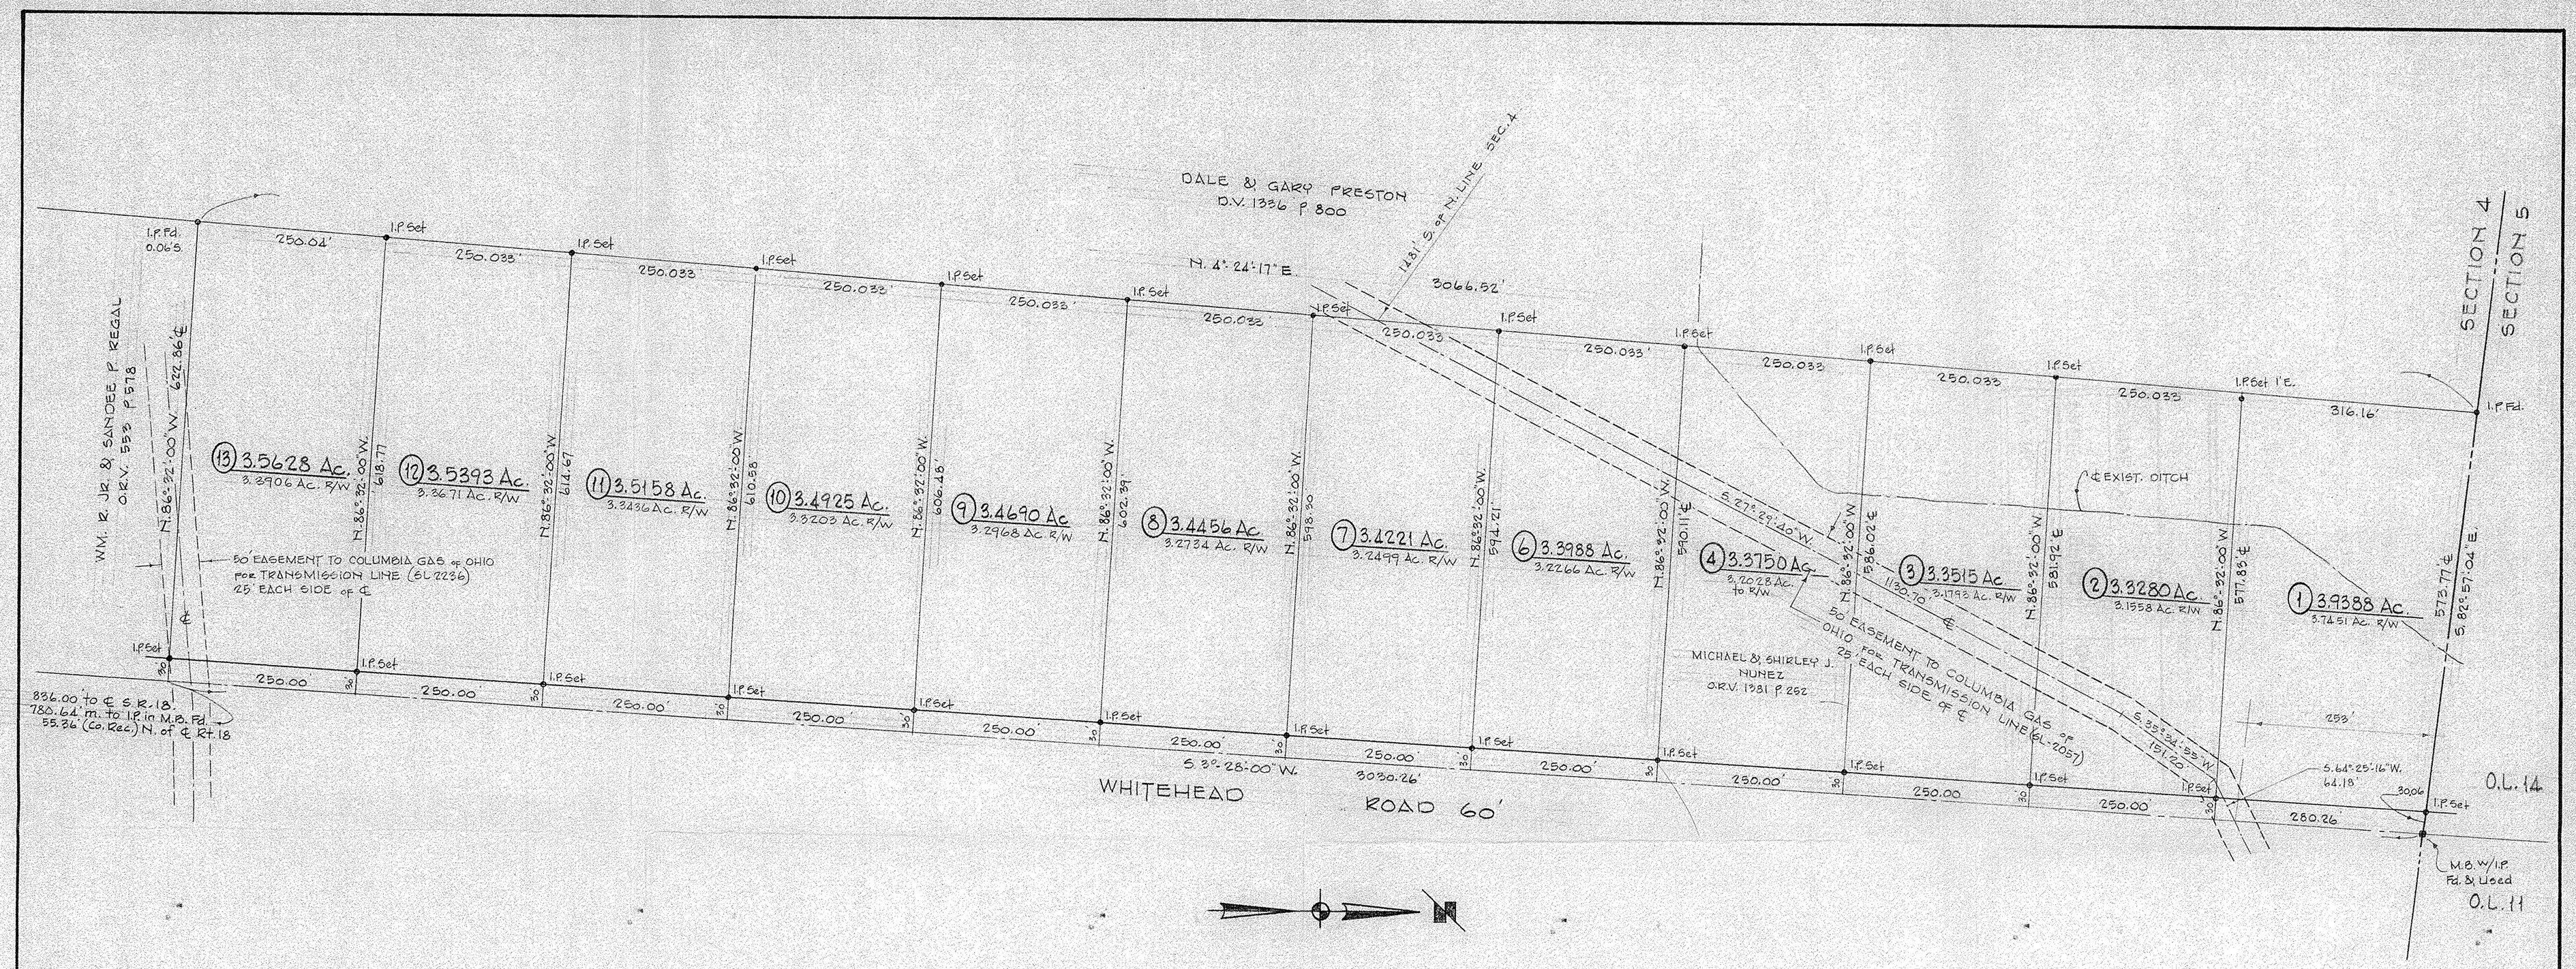

ZONING – RESIDENTIAL
MIN. LOT SIZE – 250' FRT. x 3 AS (MIN.) FROM R/W LINE

SURVEY FOR

DAVID DEVELOPMENT COMPANY

PART OF O.L. 3 IN SECTION 4 OF THE TOWNSHIP OF PENFIELD
COUNTY OF LORAIN STATE OF OHIO
SCALE 1" = 100' JULY, 1996
LAUNDON • SIMON • CAHL & ASSOC. INC.
PROFESSIONAL LAND SURVEYORS
JOB No. 96-2881 F.B. 239 P. 23

#22223
APPROVED LORAIN CO. MAP DEPT
DATE 7/3/97
PAGE 19-A
BY R. BELL
#22223

STATE OF OHIO
RODGER G. SIMON
5101
REGISTERED SURVEYOR

REV. 9-12-96 Delete Pcl. 5 Add Pcl. 6 thru 13 inclusive R.G.S.
REV. 8-8-96 Add Existing Ditch