KLEINOEDER · SCHN and ASSOCIATES

ENGINEERS — SURVEYORS — CONSULTANTS in LAND PLANNING

ELYRIA · NORWALK · MEDINA OHIO

SURVEY

Sublot(s) _____

Subd'n _____

Township PENFIELD Tract 4

Orig. Lot(s) 10 & 11 Sec. _____

County of LORAIN State of Ohio

Corporation _____

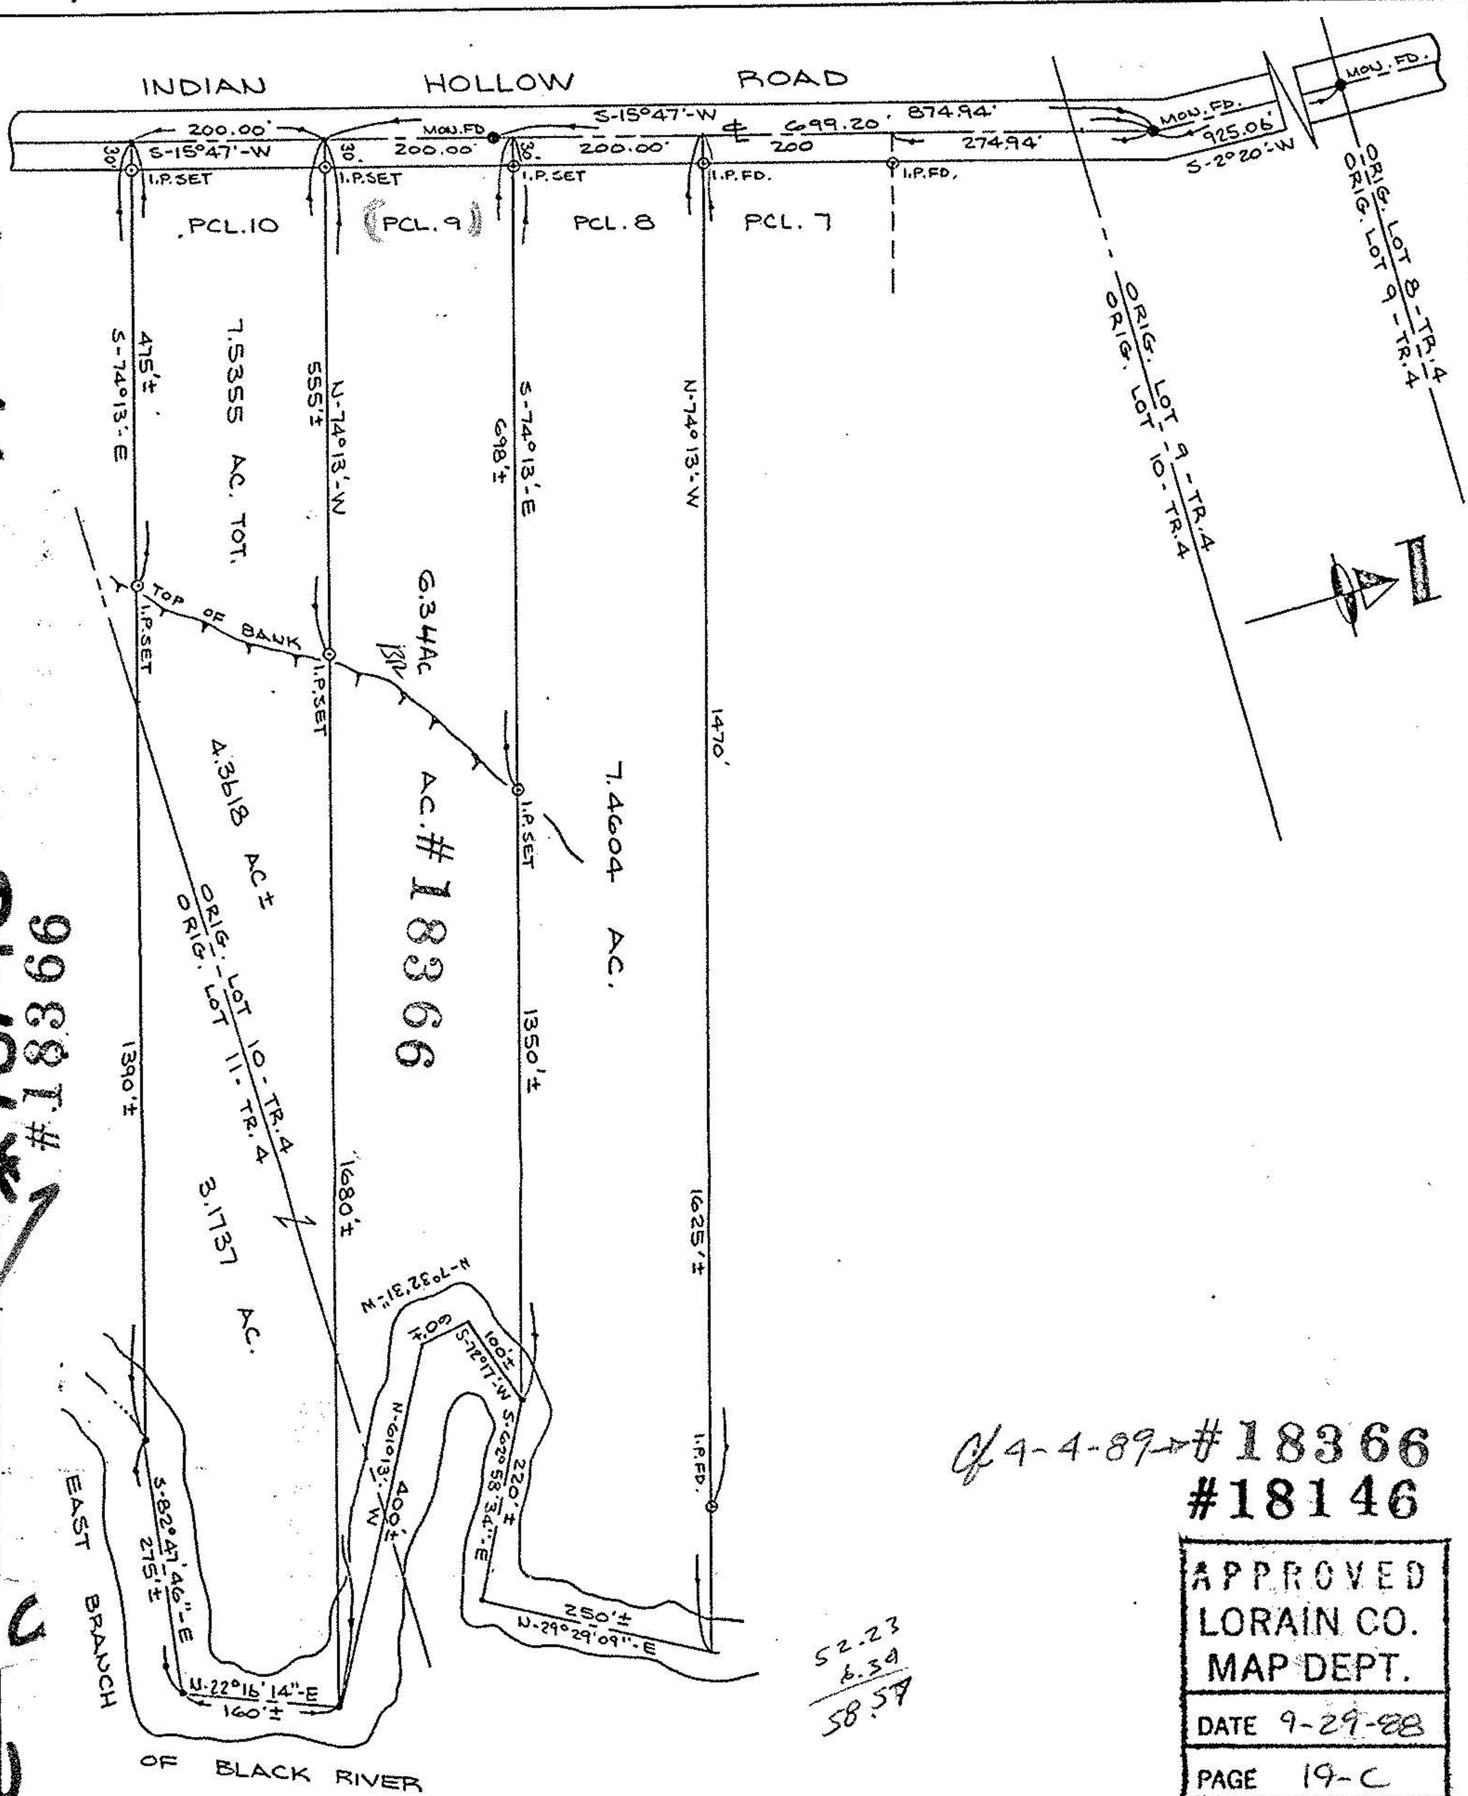

#18366

5-2.23
6.34
58.57

9-4-89 → #18366

#18146

APPROVED LORAIN CO. MAP DEPT.	
DATE 9-29-88	
PAGE 19-C	
BY T. Malain	
VOID AFTER	18146

Prepared for: EUGENE KLINK

Scale: 1" = 200'	Date: 1-19-75	Dr. by: DE.	Job No 72346