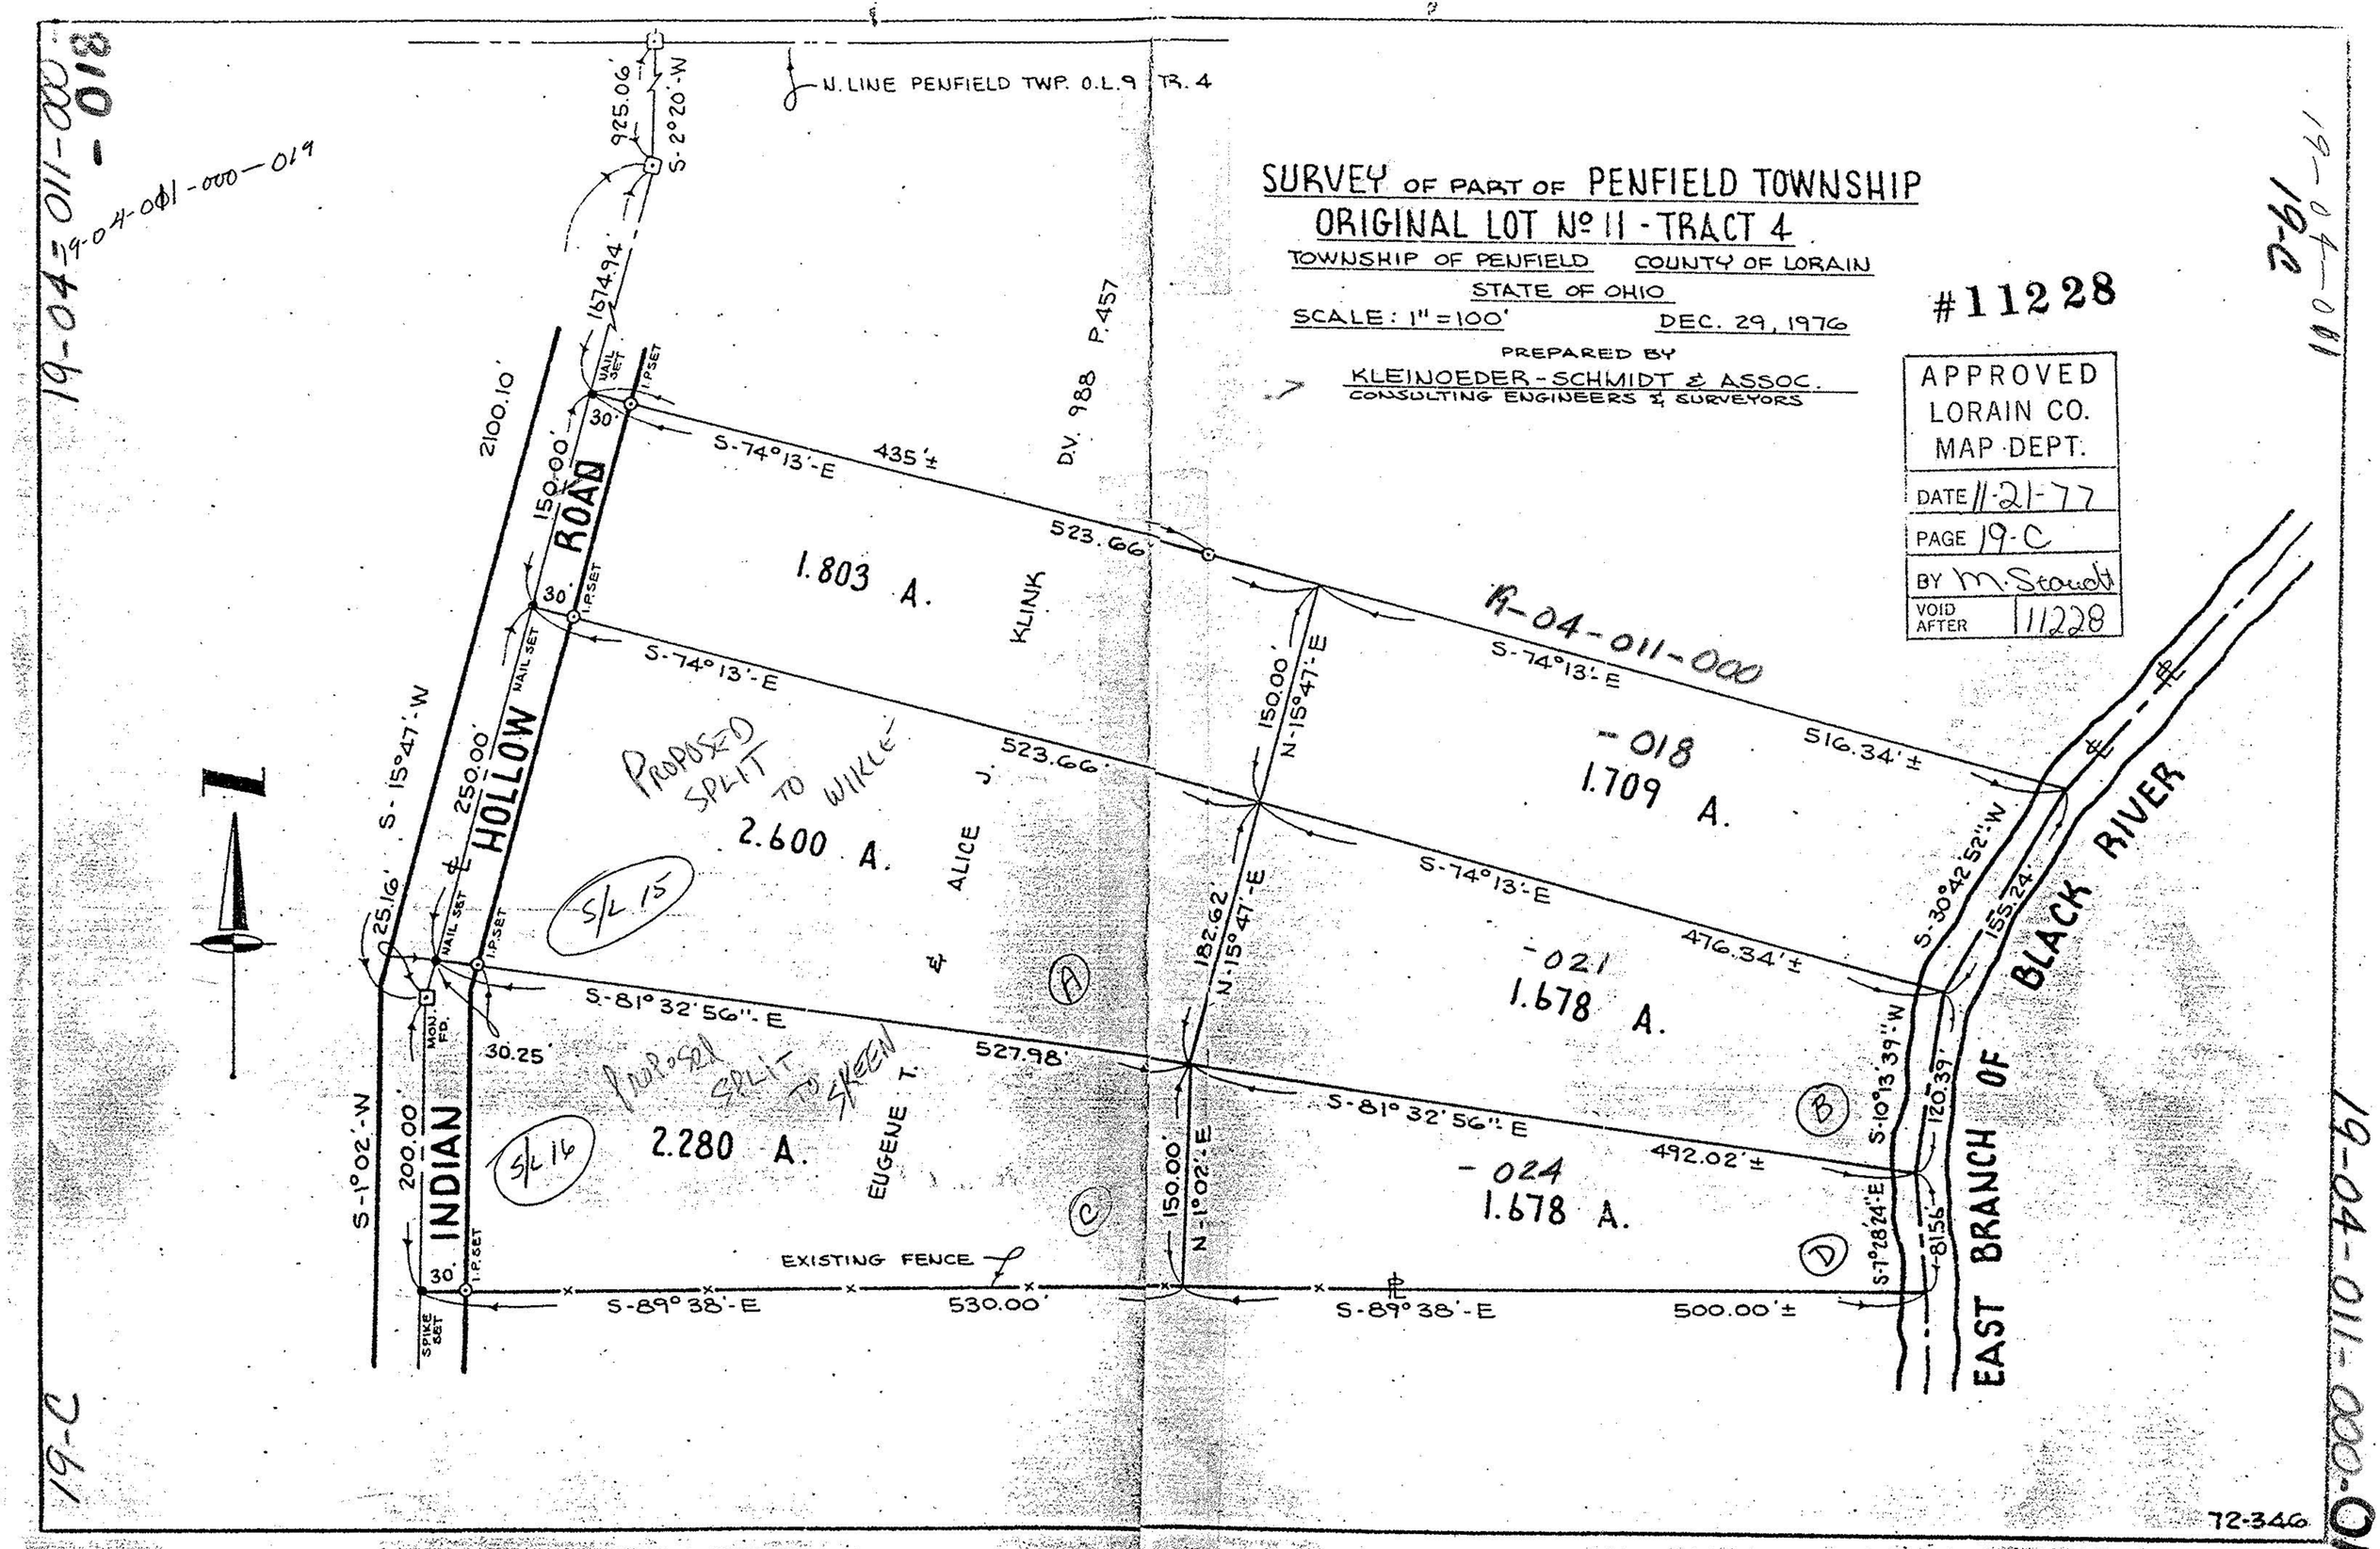

SURVEY OF PART OF PENFIELD TOWNSHIP
ORIGINAL LOT Nº 11 - TRACT 4
TOWNSHIP OF PENFIELD COUNTY OF LORAIN
STATE OF OHIO
SCALE: 1" = 100'
DEC. 29, 1976
PREPARED BY
KLEINOEDER - SCHMIDT & ASSOC.
CONSULTING ENGINEERS & SURVEYORS
#11228
APPROVED
LORAIN CO.
MAP DEPT.
DATE 11-21-77
PAGE 19-C
BY M. Staudt
VOID AFTER 11228
N. LINE PENFIELD TWP. O.L.9 TR. 4
925.06'
S-2°20'-W
1674.94'
2100.10'
150.00'
ROAD
HOLLOW
INDIAN
S-15°47'-W
250.00'
25.16'
30.25'
200.00'
S-1°02'-W
NAIL SET
I.P.SET
MON. FD.
SPIKE SET
30'
S-74°13'-E
435'±
523.66'
1.803 A.
KLINK
D.V. 988 P.457
S-74°13'-E
523.66'
PROPOSED SPLIT TO WIKLE
2.600 A.
S/L 15
ALICE J.
S-81°32'56"-E
527.98'
PROPOSED SPLIT TO SKEEN
2.280 A.
S/L 16
EUGENE T.
EXISTING FENCE
S-89°38'-E
530.00'
150.00'
N-15°47'-E
182.62'
N-15°47'-E
150.00'
N-1°02'-E
R-04-011-000
-018
1.709 A.
516.34'±
S-74°13'-E
476.34'±
-021
1.678 A.
S-81°32'56"-E
492.02'±
-024
1.678 A.
S-89°38'-E
500.00'±
S-30°42'52"-W
155.24'
S-10°13'39"-W
120.39'
S-7°28'24"-E
81.56'
EAST BRANCH OF BLACK RIVER
A
B
C
D
72-346
19-04-011-000-018
19-04-011-000-019
19-C