

MAP OF SURVEY, LOT SPLIT AND ASSEMBLY


PREPARED FOR

ROGER D. AND CYNTHIA J. SMITH

SITUATED IN THE TOWNSHIP OF PENFIELD, COUNTY OF LORAIN, STATE OF OHIO AND BEING KNOWN AS PART OF ORIGINAL PENFIELD TOWNSHIP TRACT 5, LOT 6

NORTH LINE
ORIGINAL LOT 6
TRACT 5

LAWRENCE F. LUTHER
P.P.#19-05-006-000-023
INTR#97050962

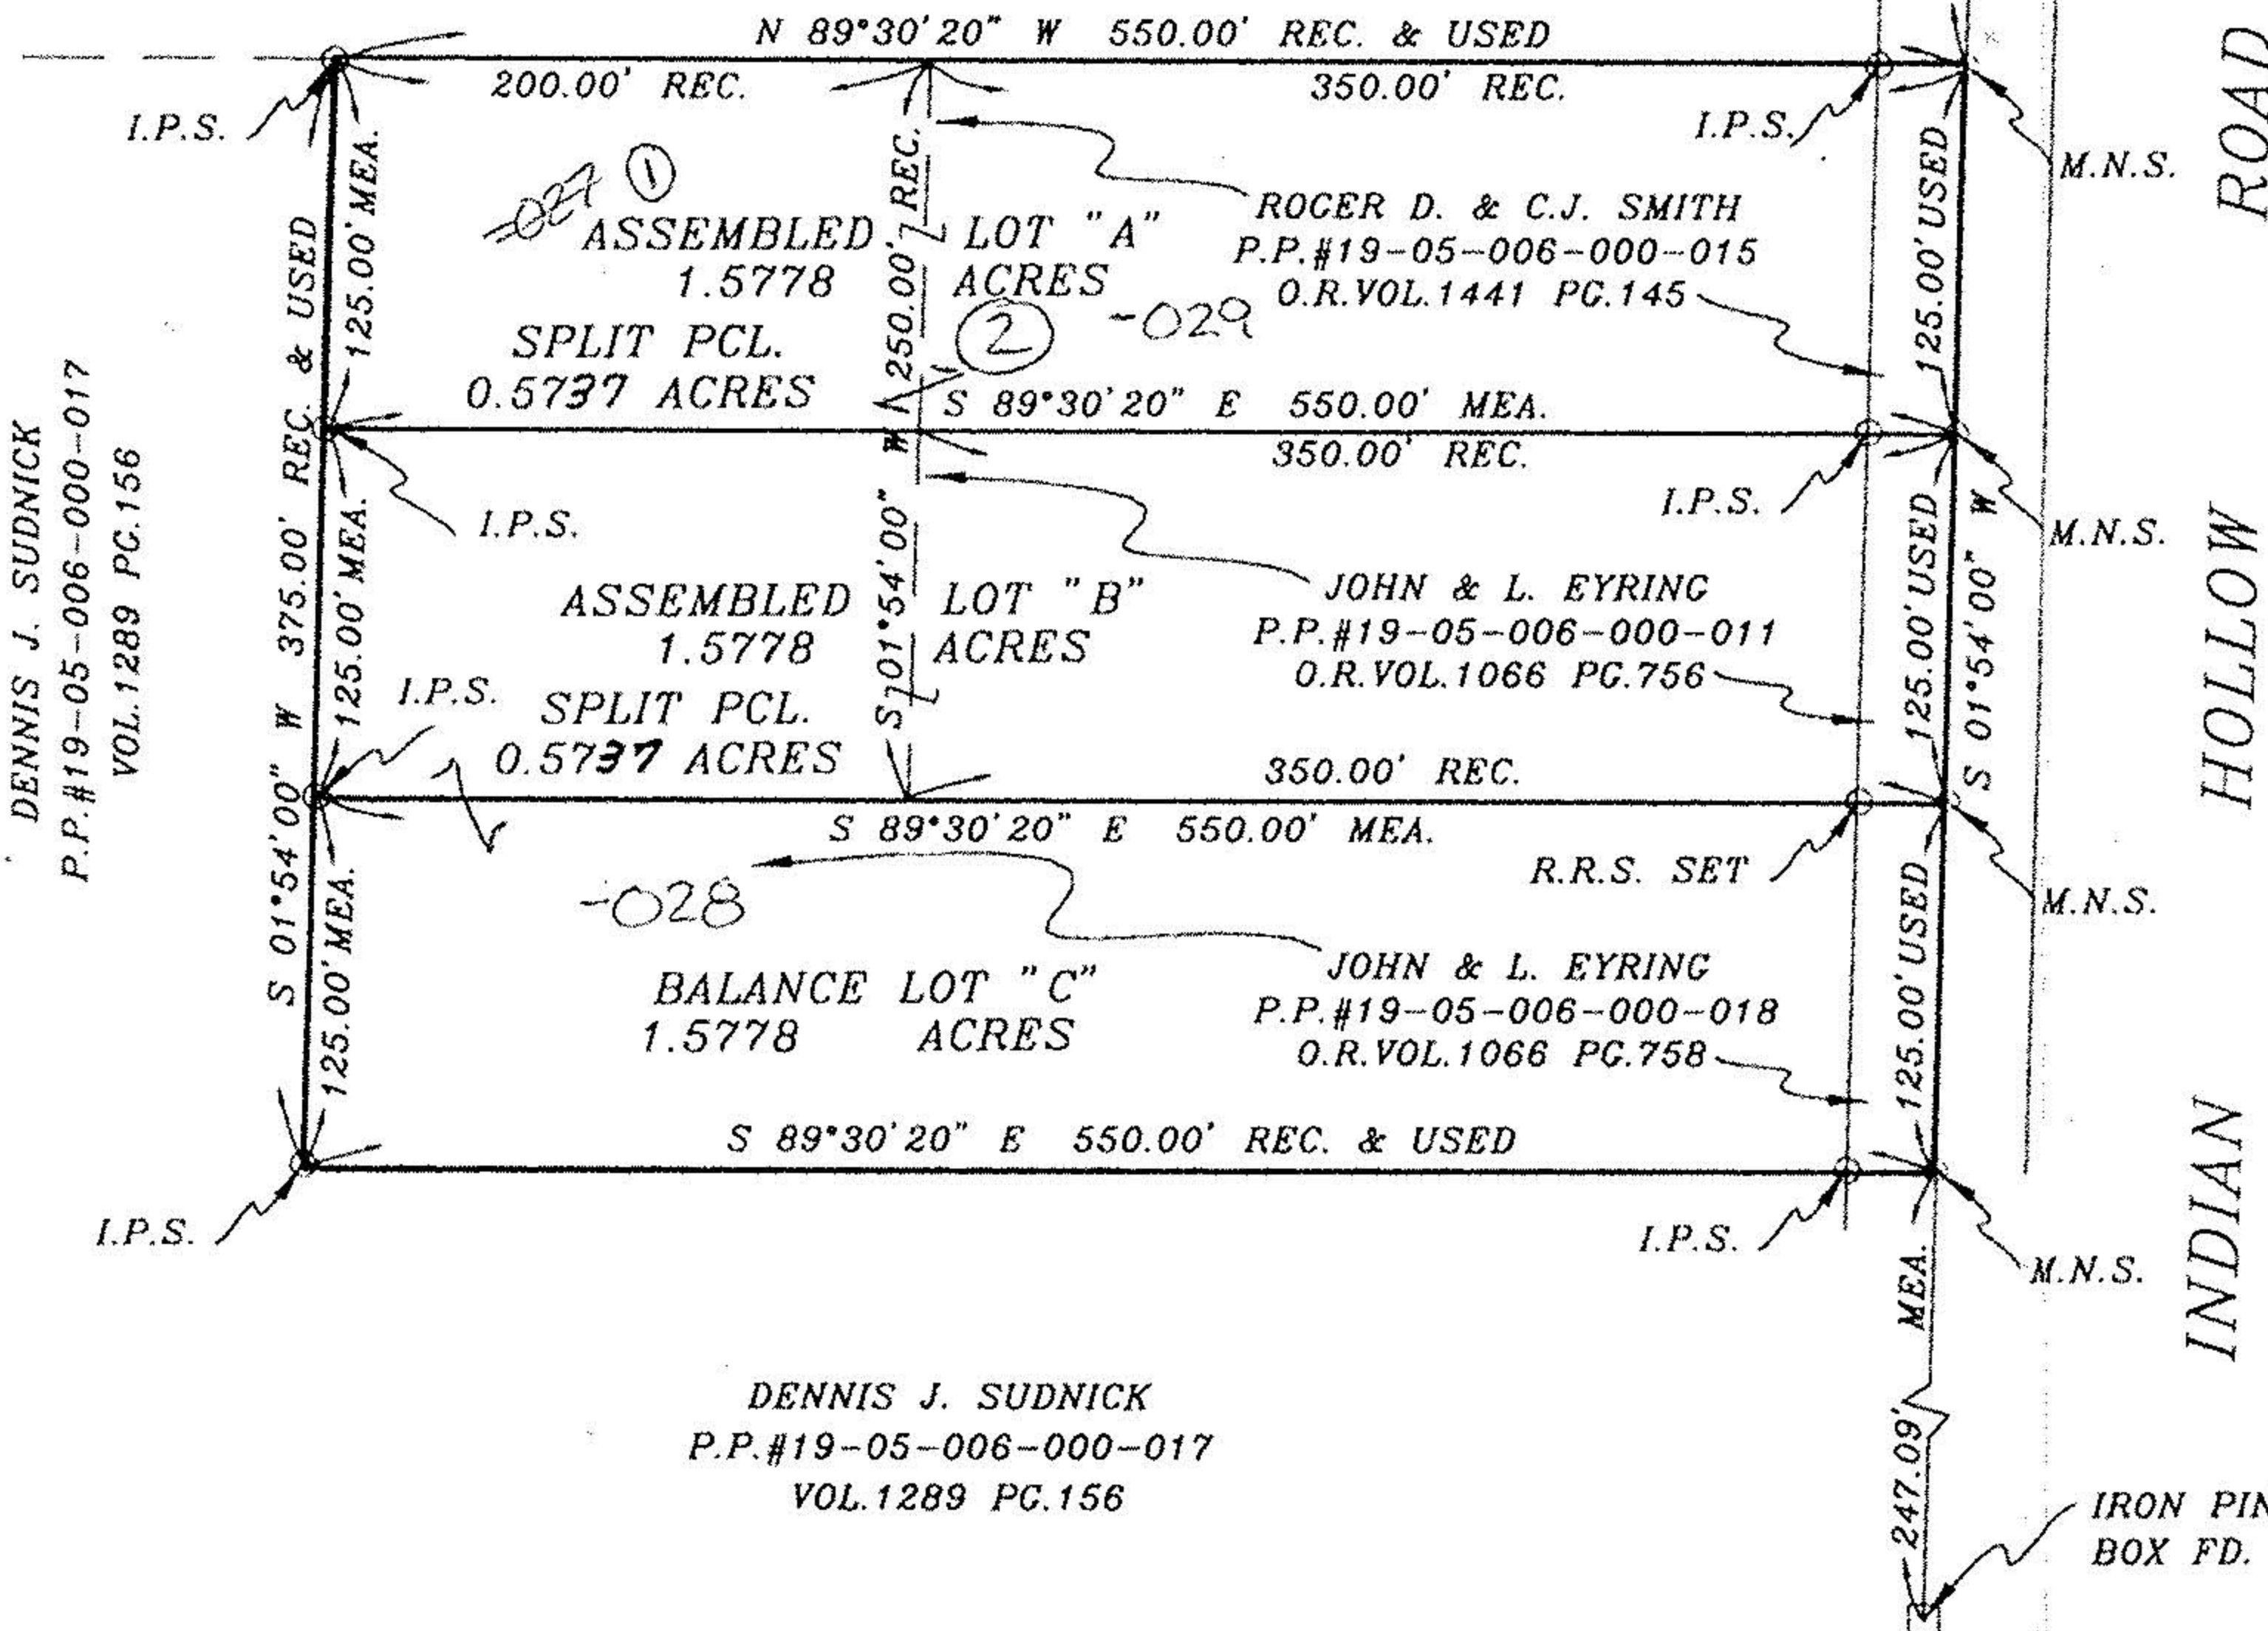

DENNIS J. SUDNICK
P.P.#19-05-006-000-017
VOL.1289 PG.156

DENNIS J. SUDNICK
P.P.#19-05-006-000-017
VOL.1289 PG.156

IRON PIN IN MON.
BOX FD. & USED

IRON PIN IN MON.
BOX FD. & USED



SCALE: 1" = 100'


#00556

APPROVED
LORAIN CO.
MAP DEPT.
DATE 8/30/00
PAGE 19-C
BY T. SPILLMAN
00556

SURVEYOR'S STATEMENT

DISTANCES ARE EXPRESSED IN FEET AND DECIMAL PARTS THEREOF. BEARINGS ARE TO AN ASSUMED MERIDIAN AND ARE USED TO INDICATE ANGLES ONLY. PERMANENT MONUMENTS WERE FOUND OR SET AS INDICATED HEREON. —o— I.P.S. INDICATES A 5/8" IRON PIN WITH IDENTIFICATION CAP SET. —o— M.N.S. INDICATES A MAGNETIC NAIL SET. ALL OF WHICH I DECLARE TO BE CORRECT TO THE BEST OF MY ABILITIES AND BELIEFS.

THOMAS M. SNEZEK, R.L.S. No. 7051
DATE 7-17-00

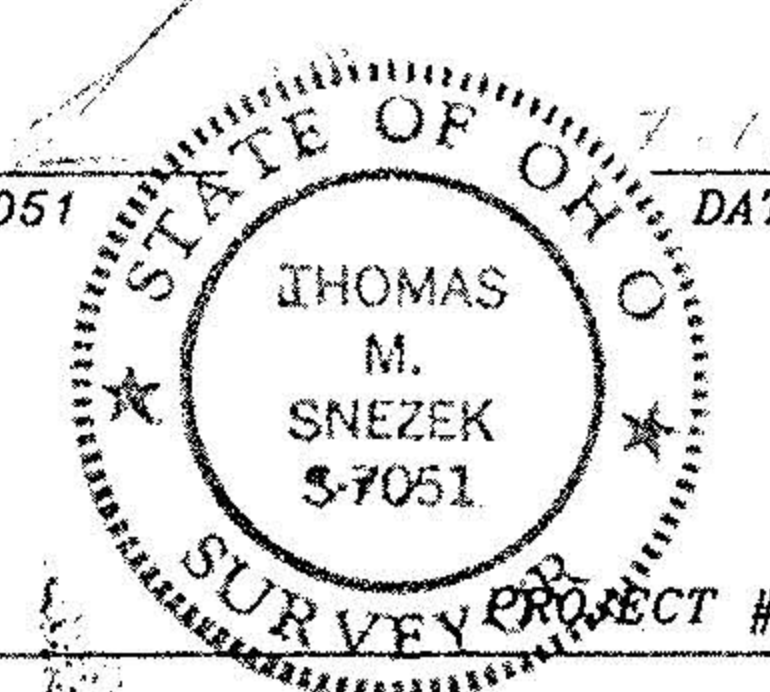

PROJECT #0007 7/16/00