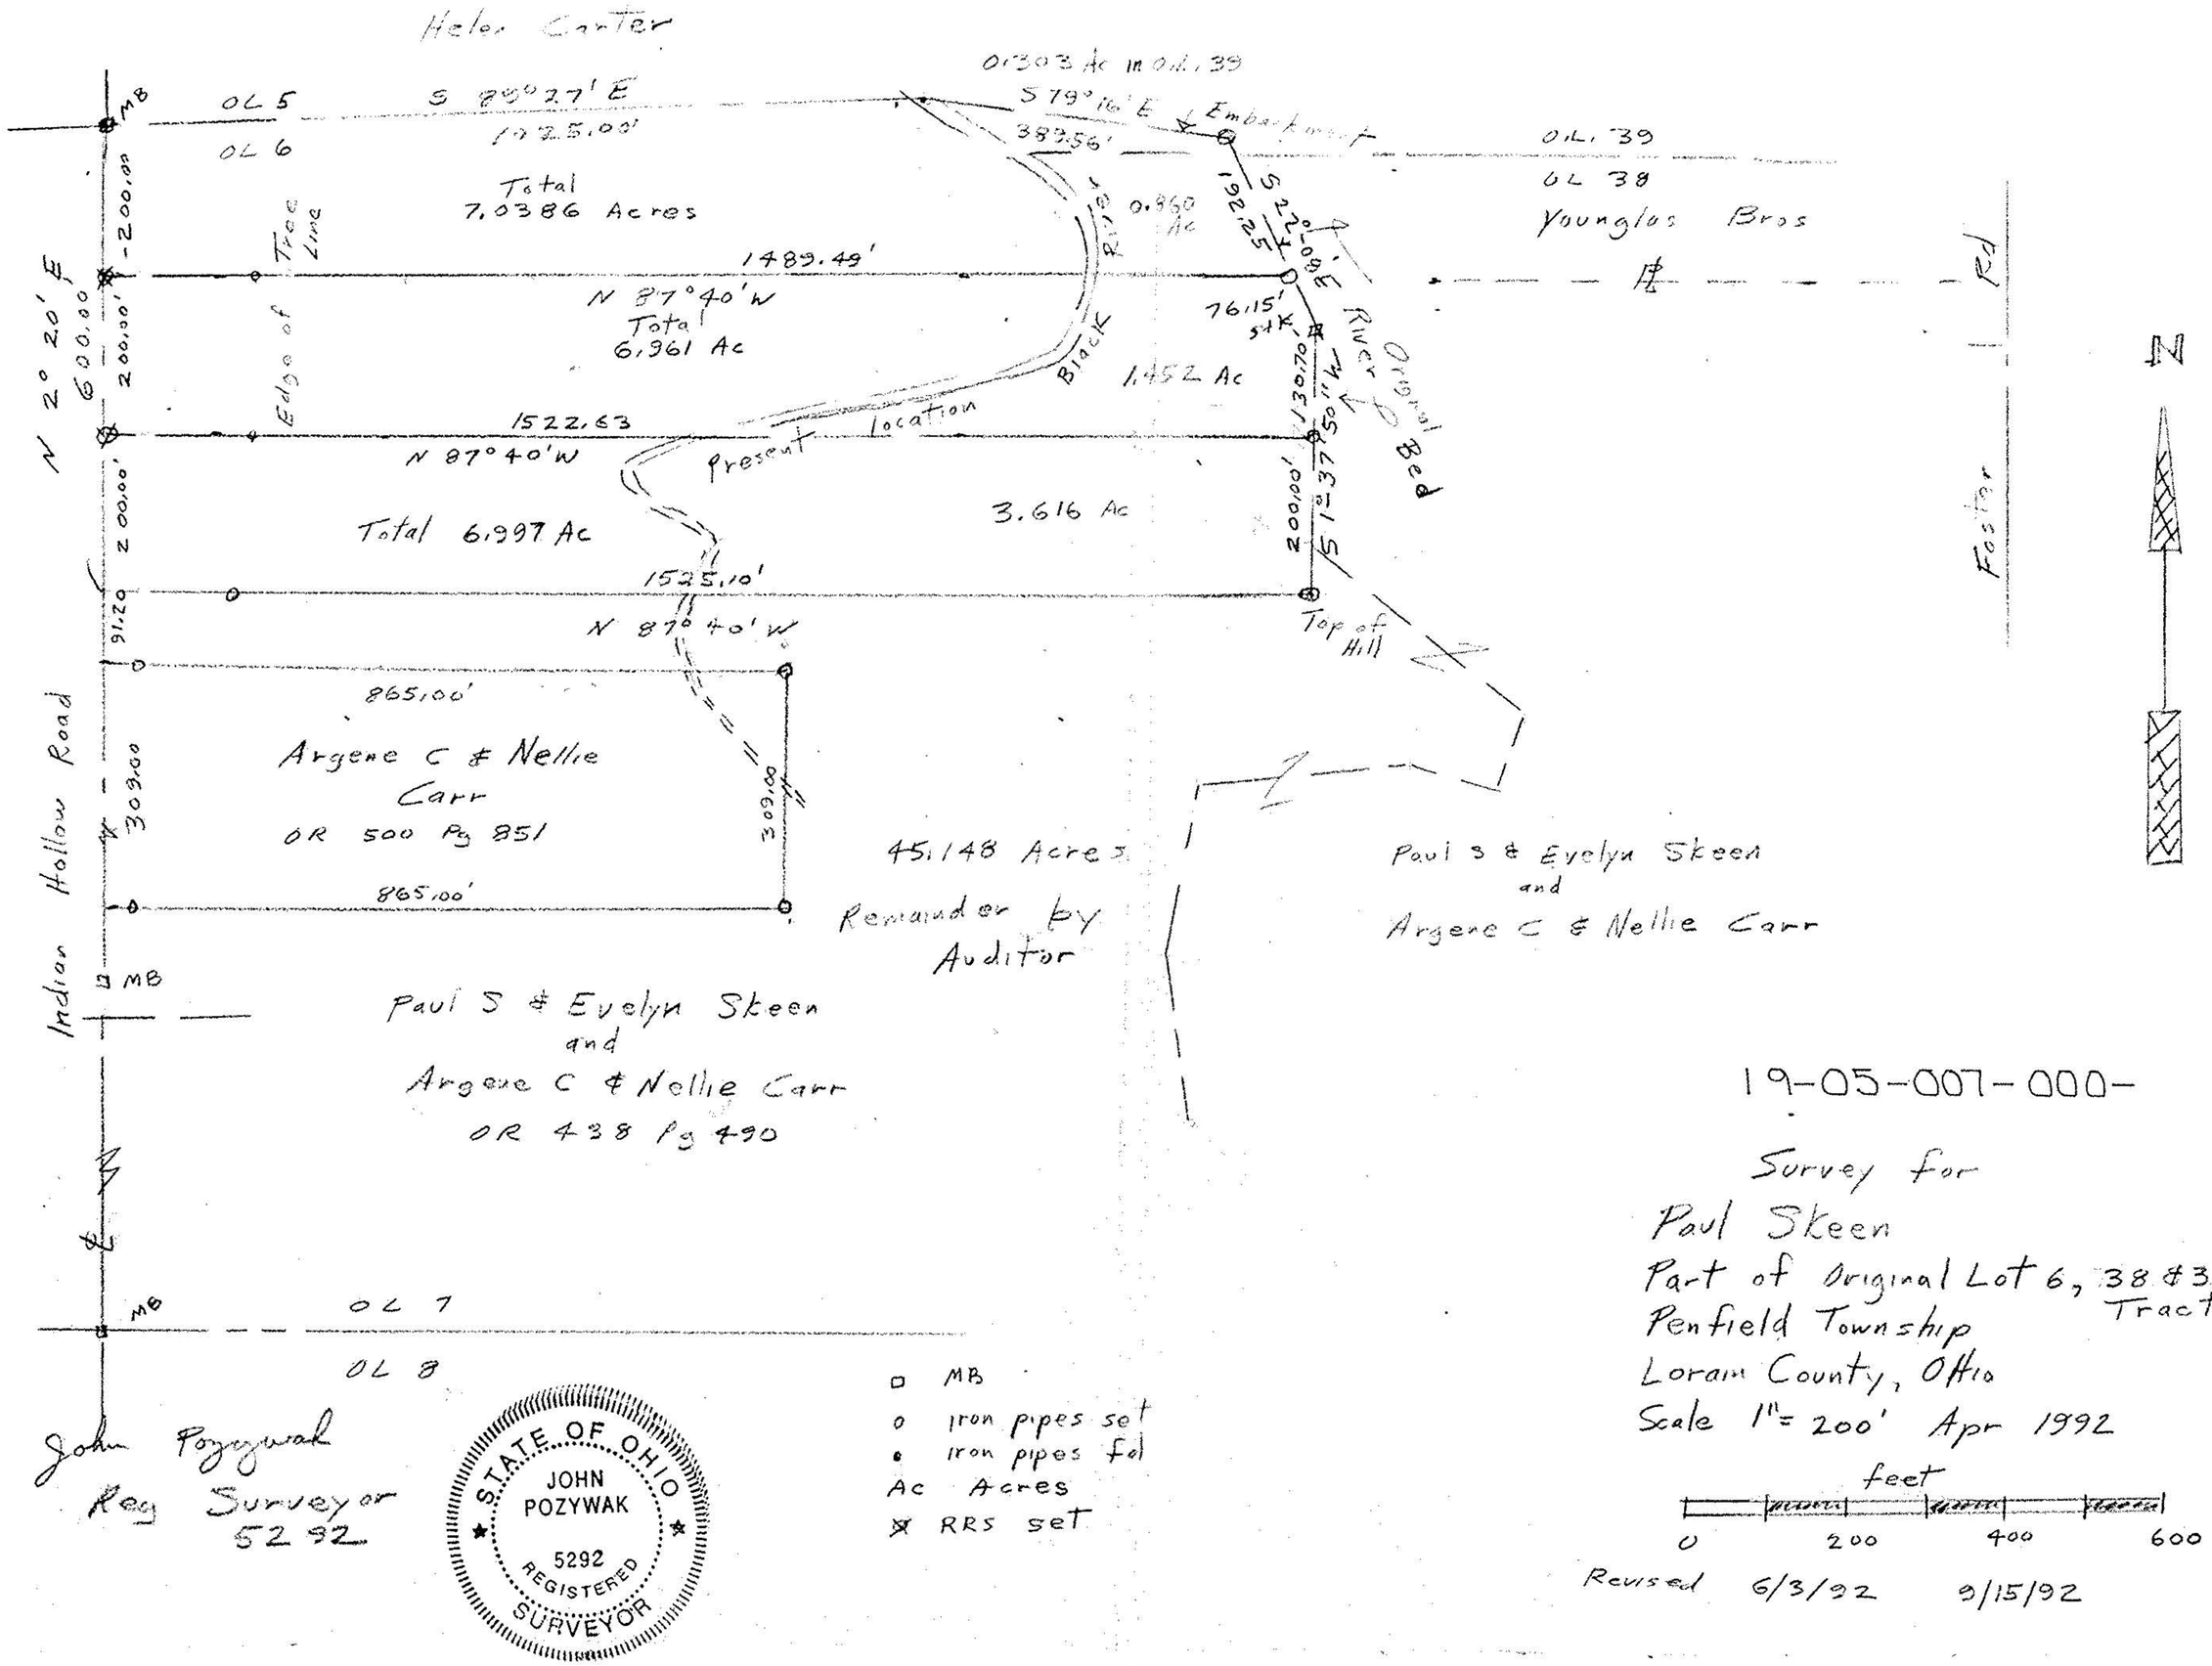

19951

APPROVED
LORAIN CO.
MAP DEPT.
DATE 9-15-92
PAGE 19-C
BY CAROLYN FRANCIS
VOID AFTER # 19951

19-05-007-000-

Survey for
Paul Skeen
Part of Original Lot 6, 38 & 39
Tract 5
Penfield Township
Lorain County, Ohio
Scale 1" = 200' Apr 1992

feet
0 200 400 600

Revised 6/3/92 9/15/92