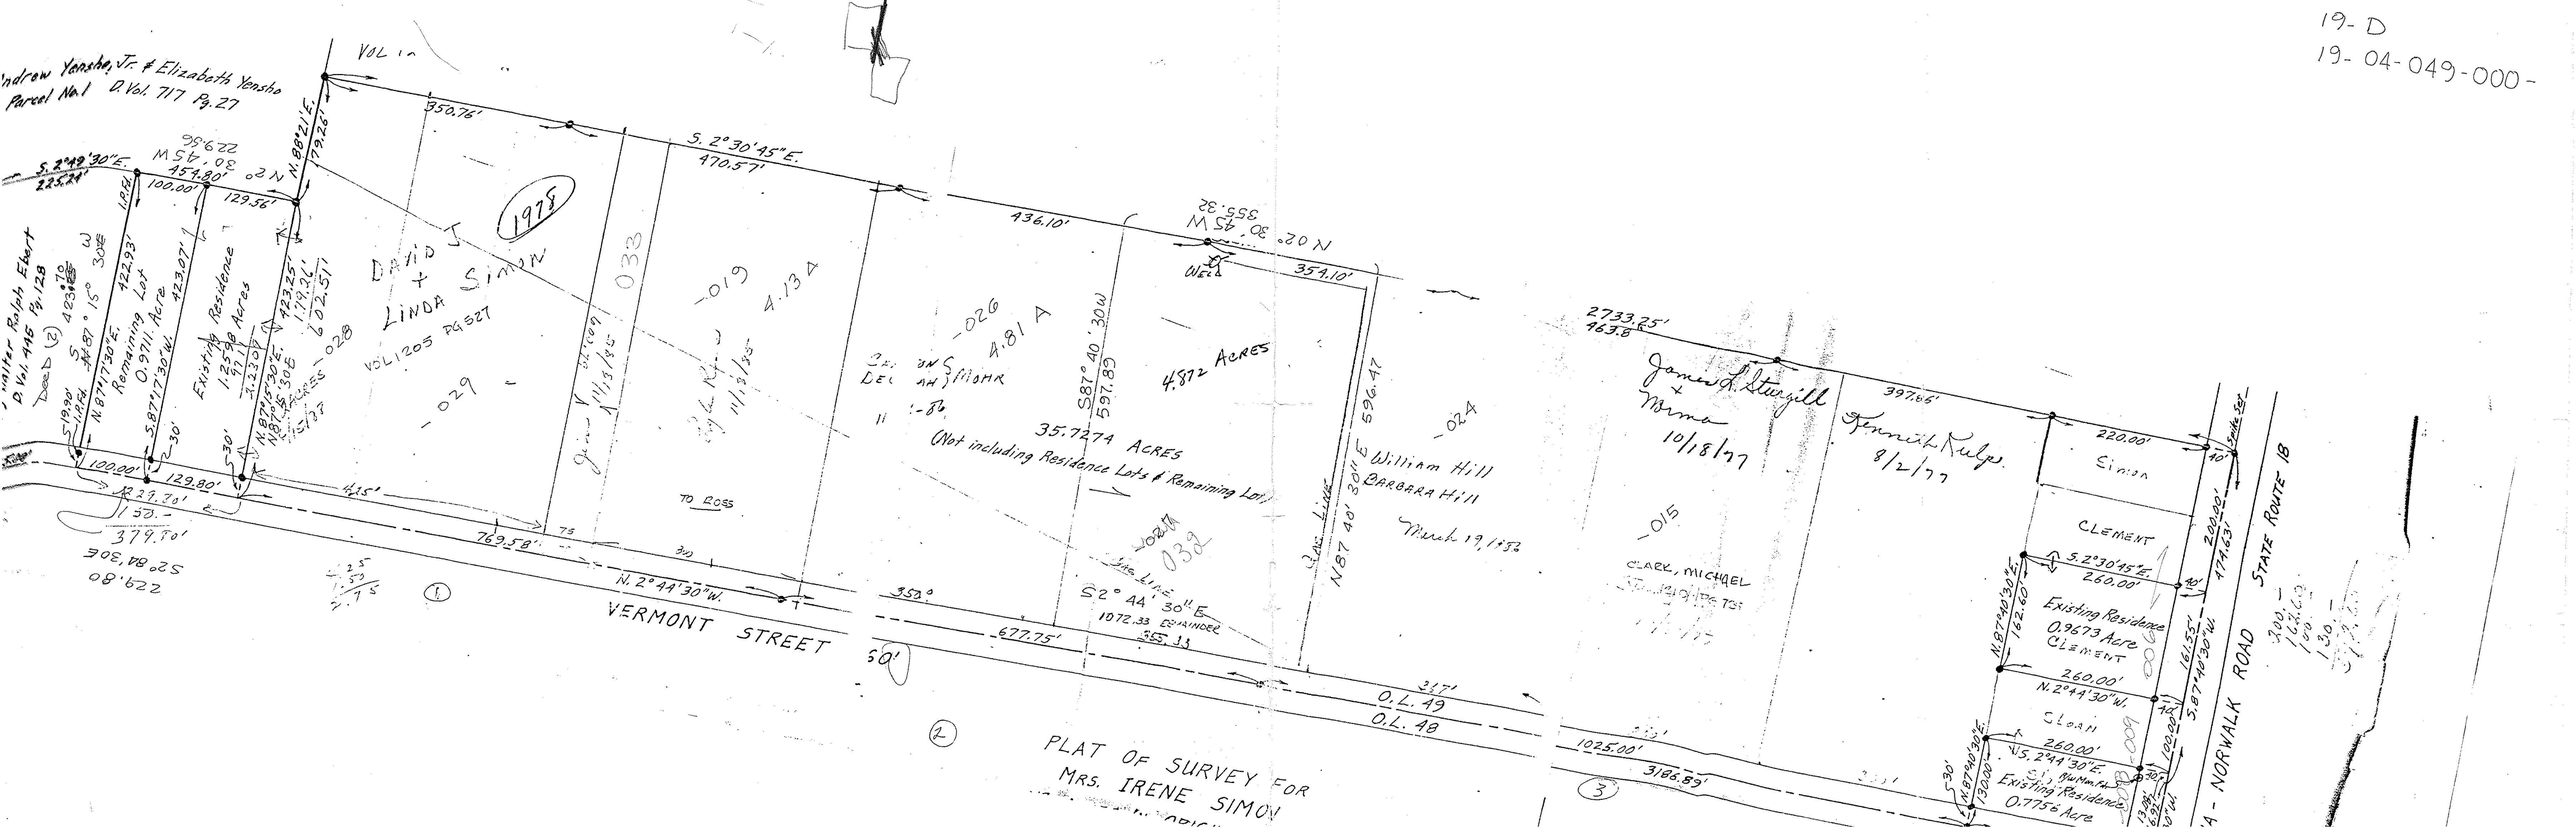19-D
19-04-049-000-