


CHART HAINUKOSH

Orig. Lot 61	City of	Date MAY, '93 Scale 1"=100'
Orig. Sec 1	Village of	Dwn. by R.G.S. Chkd. by R.C.
Tract	County of LORAIN	Job No. 93-2341 F.B. 229/44
Township of PENFIELD	State of OHIO	Printed

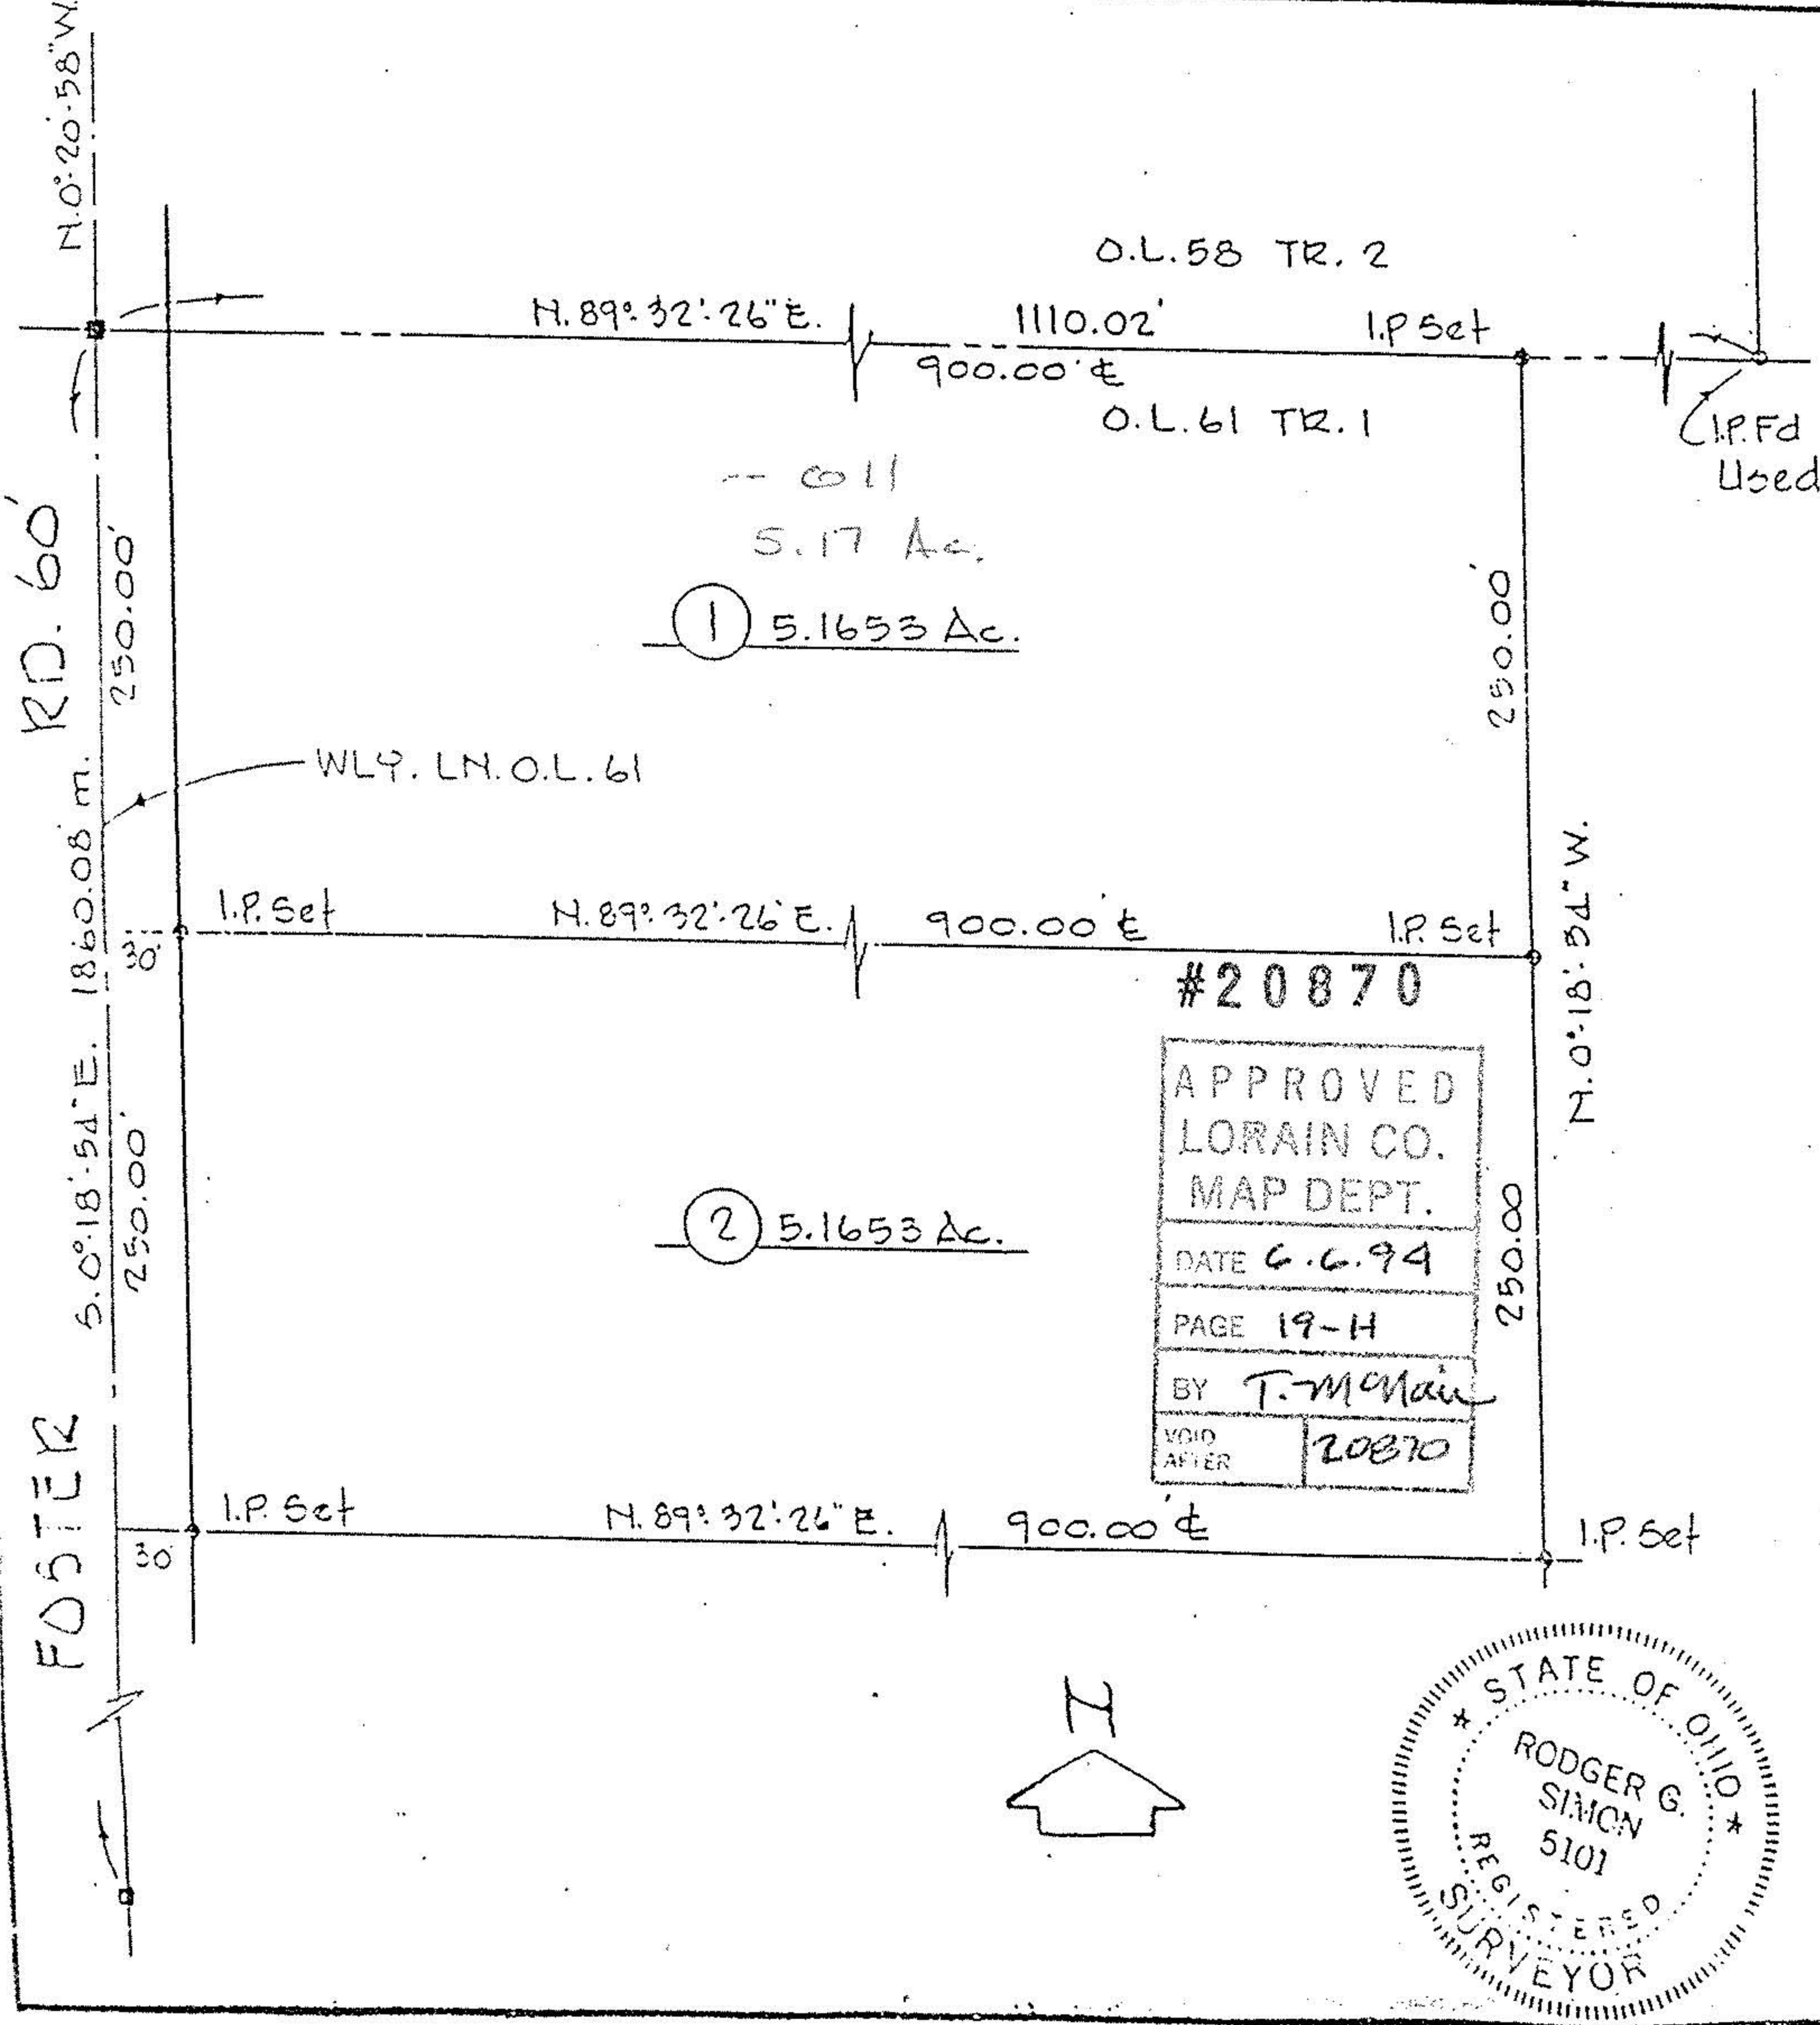

① 5.1653 Ac.

② 5.1653 Ac.

#20870
 APPROVED
 LORAIN CO.
 MAP DEPT.
 DATE 6.6.94
 PAGE 19-H
 BY T. McMan
 VOID AFTER 20870

