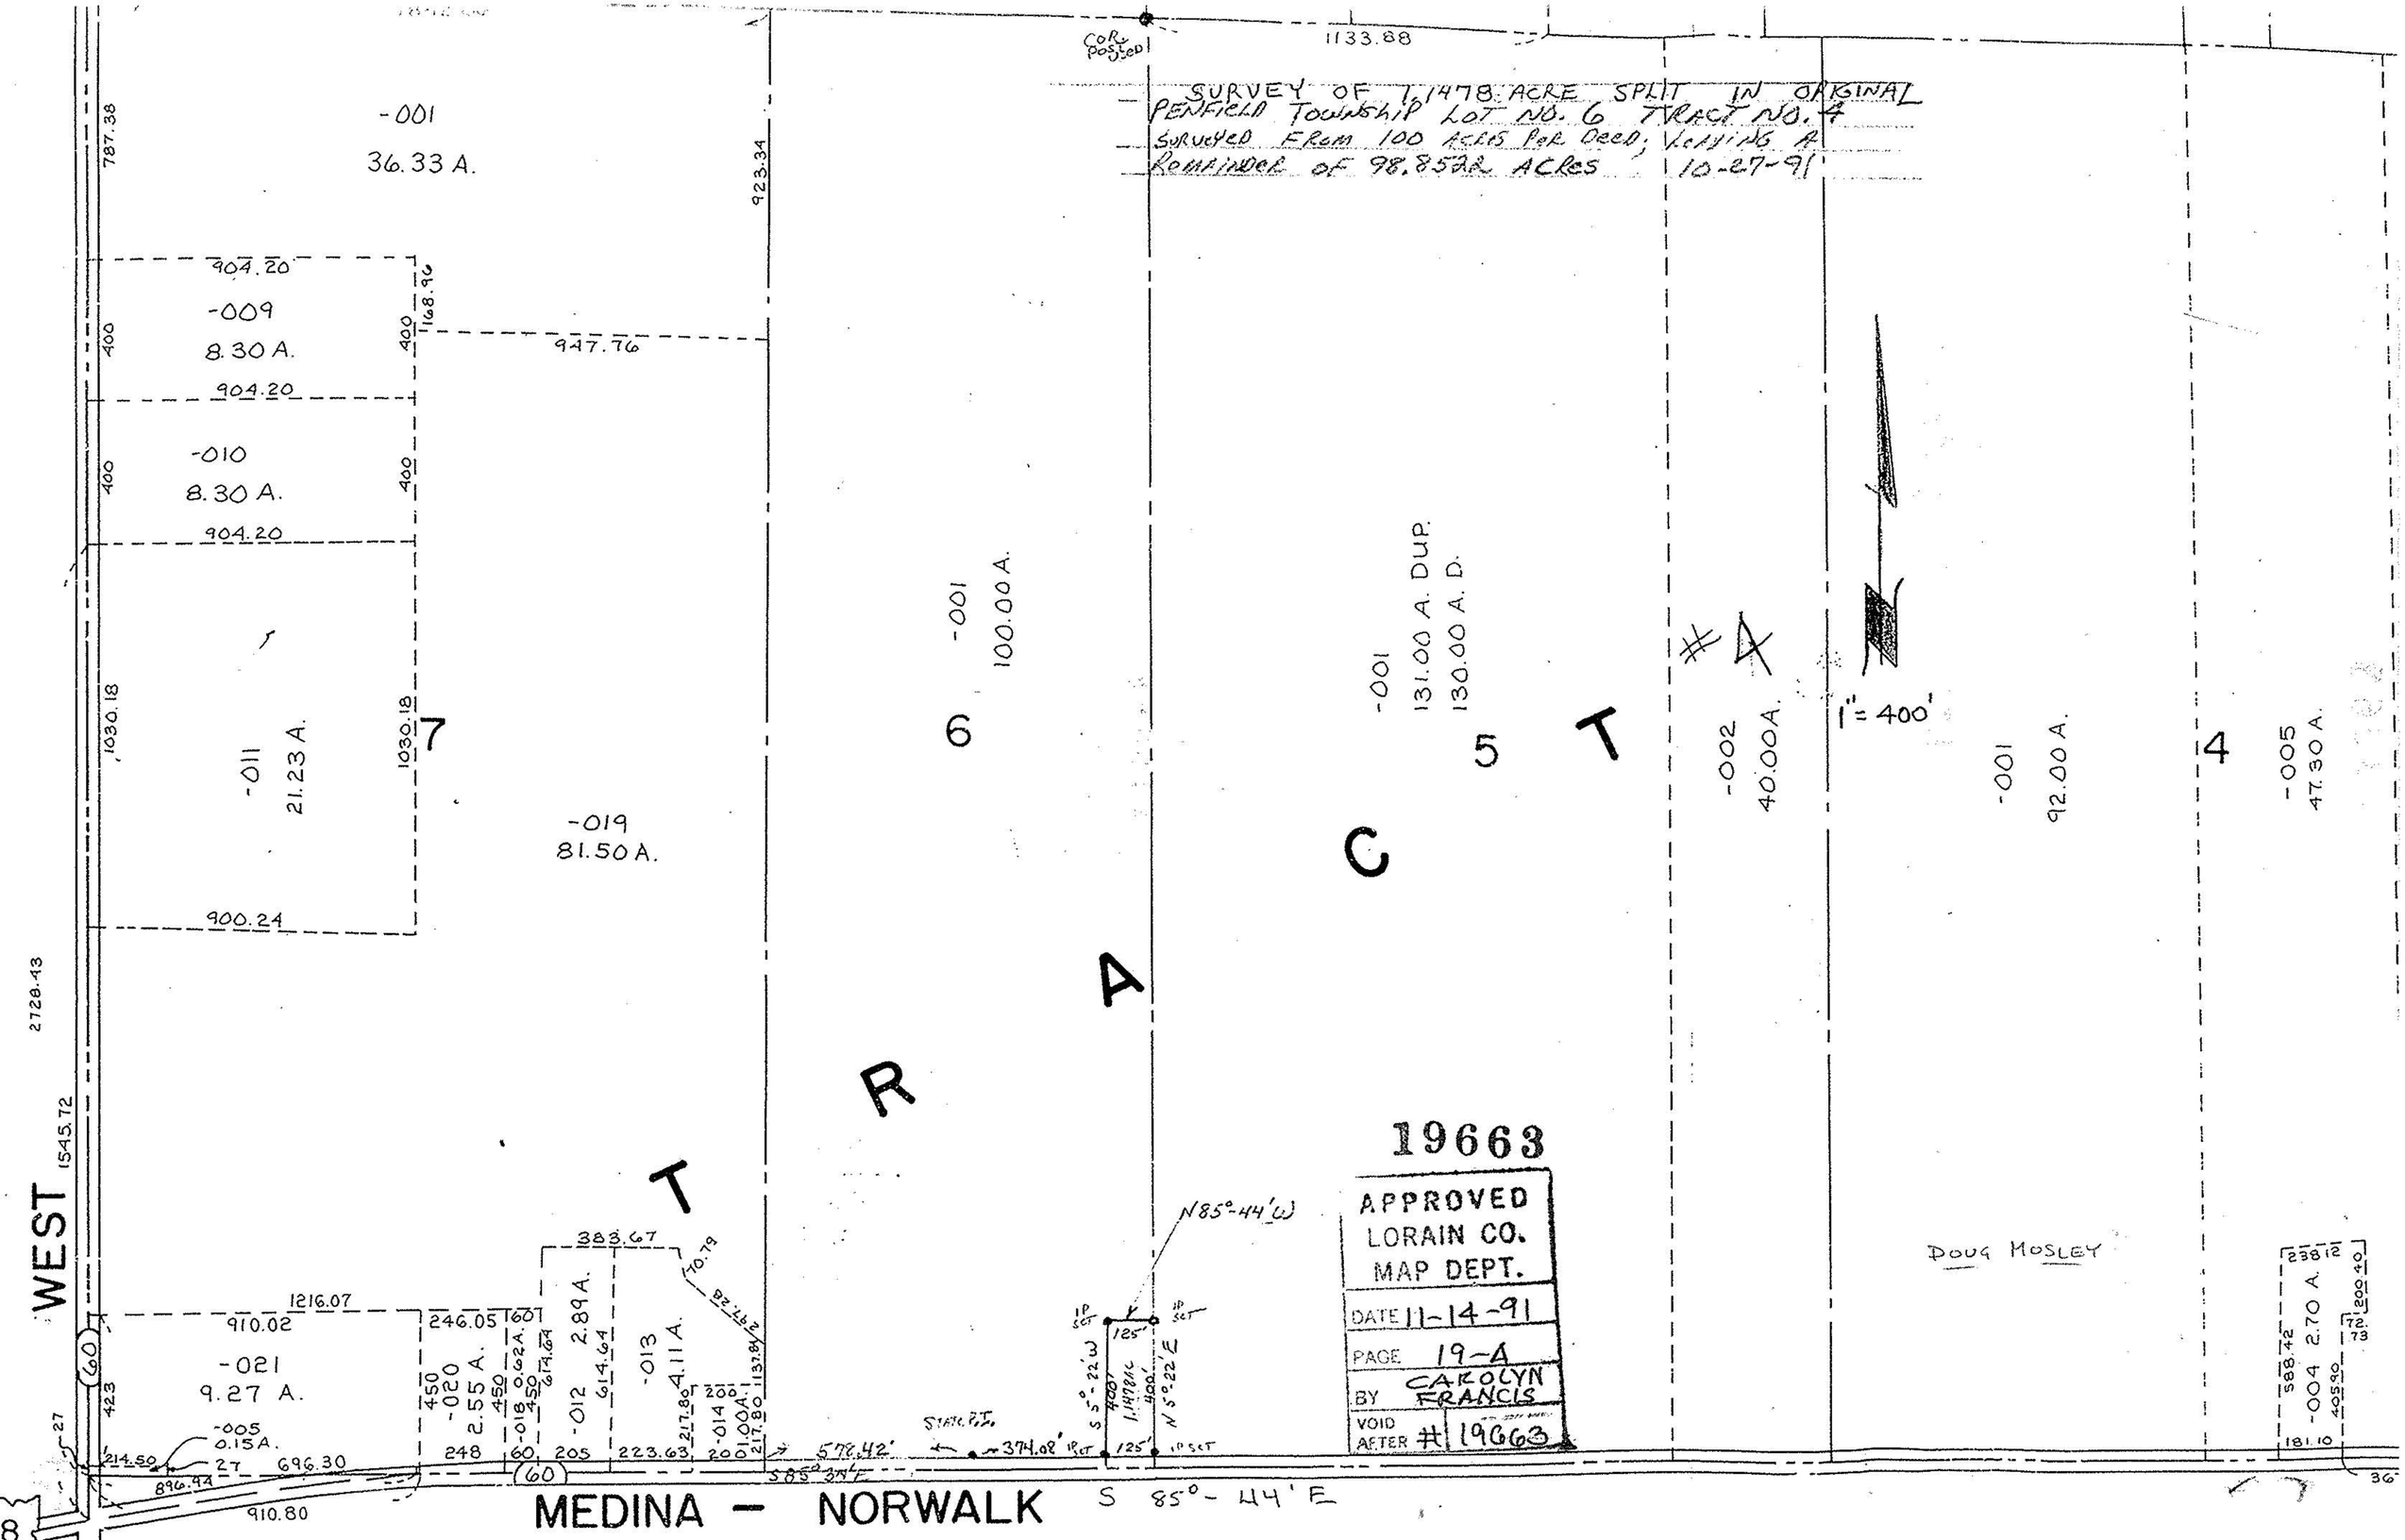

SURVEY OF 1.1478 ACRE SPLIT IN ORIGINAL PENFIELD TOWNSHIP LOT NO. 6 TRACT NO. 4
SURVEYED FROM 100 ACRES PER DEED; LEAVING A REMAINDER OF 98.8522 ACRES 10-27-91
COR. POSTED
1133.88
787.38
-001
36.33 A.
923.34
904.20
-009
8.30 A.
904.20
-010
8.30 A.
904.20
168.96
947.76
400
1030.18
-011
21.23 A.
900.24
7
-019
81.50 A.
6
-001
100.00 A.
-001
131.00 A. DUP.
130.00 A. D.
5
T R A C T
#4
-002
40.00 A.
1" = 400'
-001
92.00 A.
4
-005
47.30 A.
2728.43
1545.72
WEST
1216.07
910.02
-021
9.27 A.
423
-005
0.15 A.
214.50
27
696.30
896.94
910.80
246.05
450
-020
2.55 A.
248
60
205
-018
0.62 A.
-012
2.89 A.
614.64
383.67
-013
4.11 A.
223.63
-014
1.00 A.
217.80
70.79
1137.84
578.42'
S85°34'E
374.08'
N85°-44'W
S 5°-22'W
N 5°-22'E
125'
1.1478 AC
400'
1P SET
DOUG MOSLEY
238.12
588.42
-004
2.70 A.
405.90
200.40
72.73
181.10
36
MEDINA - NORWALK
S 85°- 44' E
19663
APPROVED
LORAIN CO.
MAP DEPT.
DATE 11-14-91
PAGE 19-A
BY CAROLYN FRANCIS
VOID AFTER # 19663