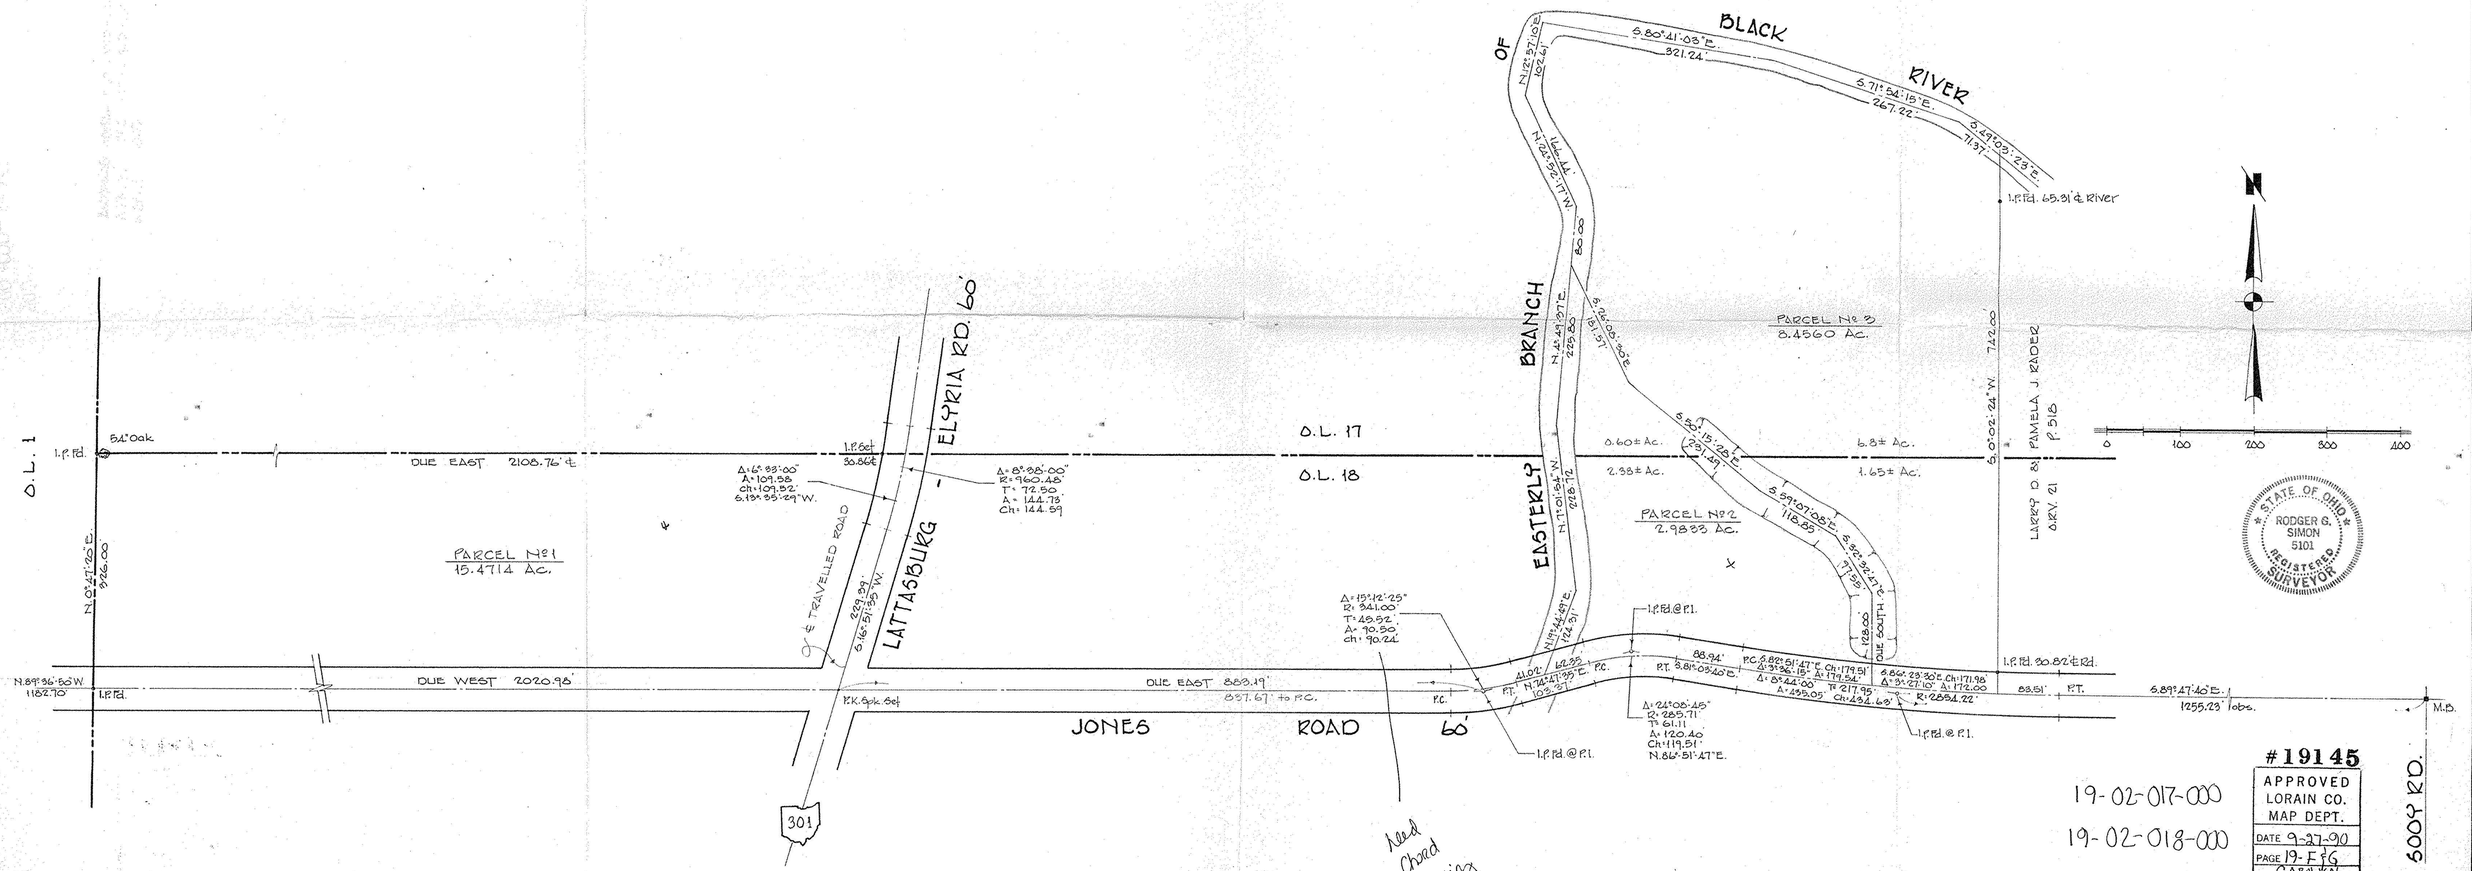


19-02-017-000

19-02-018-000

**#19145**

APPROVED
LORAIN CO.
MAP DEPT.
DATE 9-27-90
PAGE 19-F&G
BY CAROLYN FRANCIS
VOID AFTER #19145

SURVEY FOR

ESTATE of MURICE F. ZIMMERMAN

PART of O.L.'s 17 & 18 in SEC. 2 of PENFIELD TOWNSHIP
COUNTY of LORAIN STATE of OHIO

SCALE 1"=100' JULY, 1990

LAUNDON • SIMON • CAHL & ASSOC.
ENGINEERS SURVEYORS
106 MIDDLE AVE. ELYRIA, O. 44035

90-1947

252