


19-H #19200 19-02-058-000-025

● = Iron Pin set unless designated as railroad spike.
 ○ = Iron Pin found. JONES ROAD 60' R/W

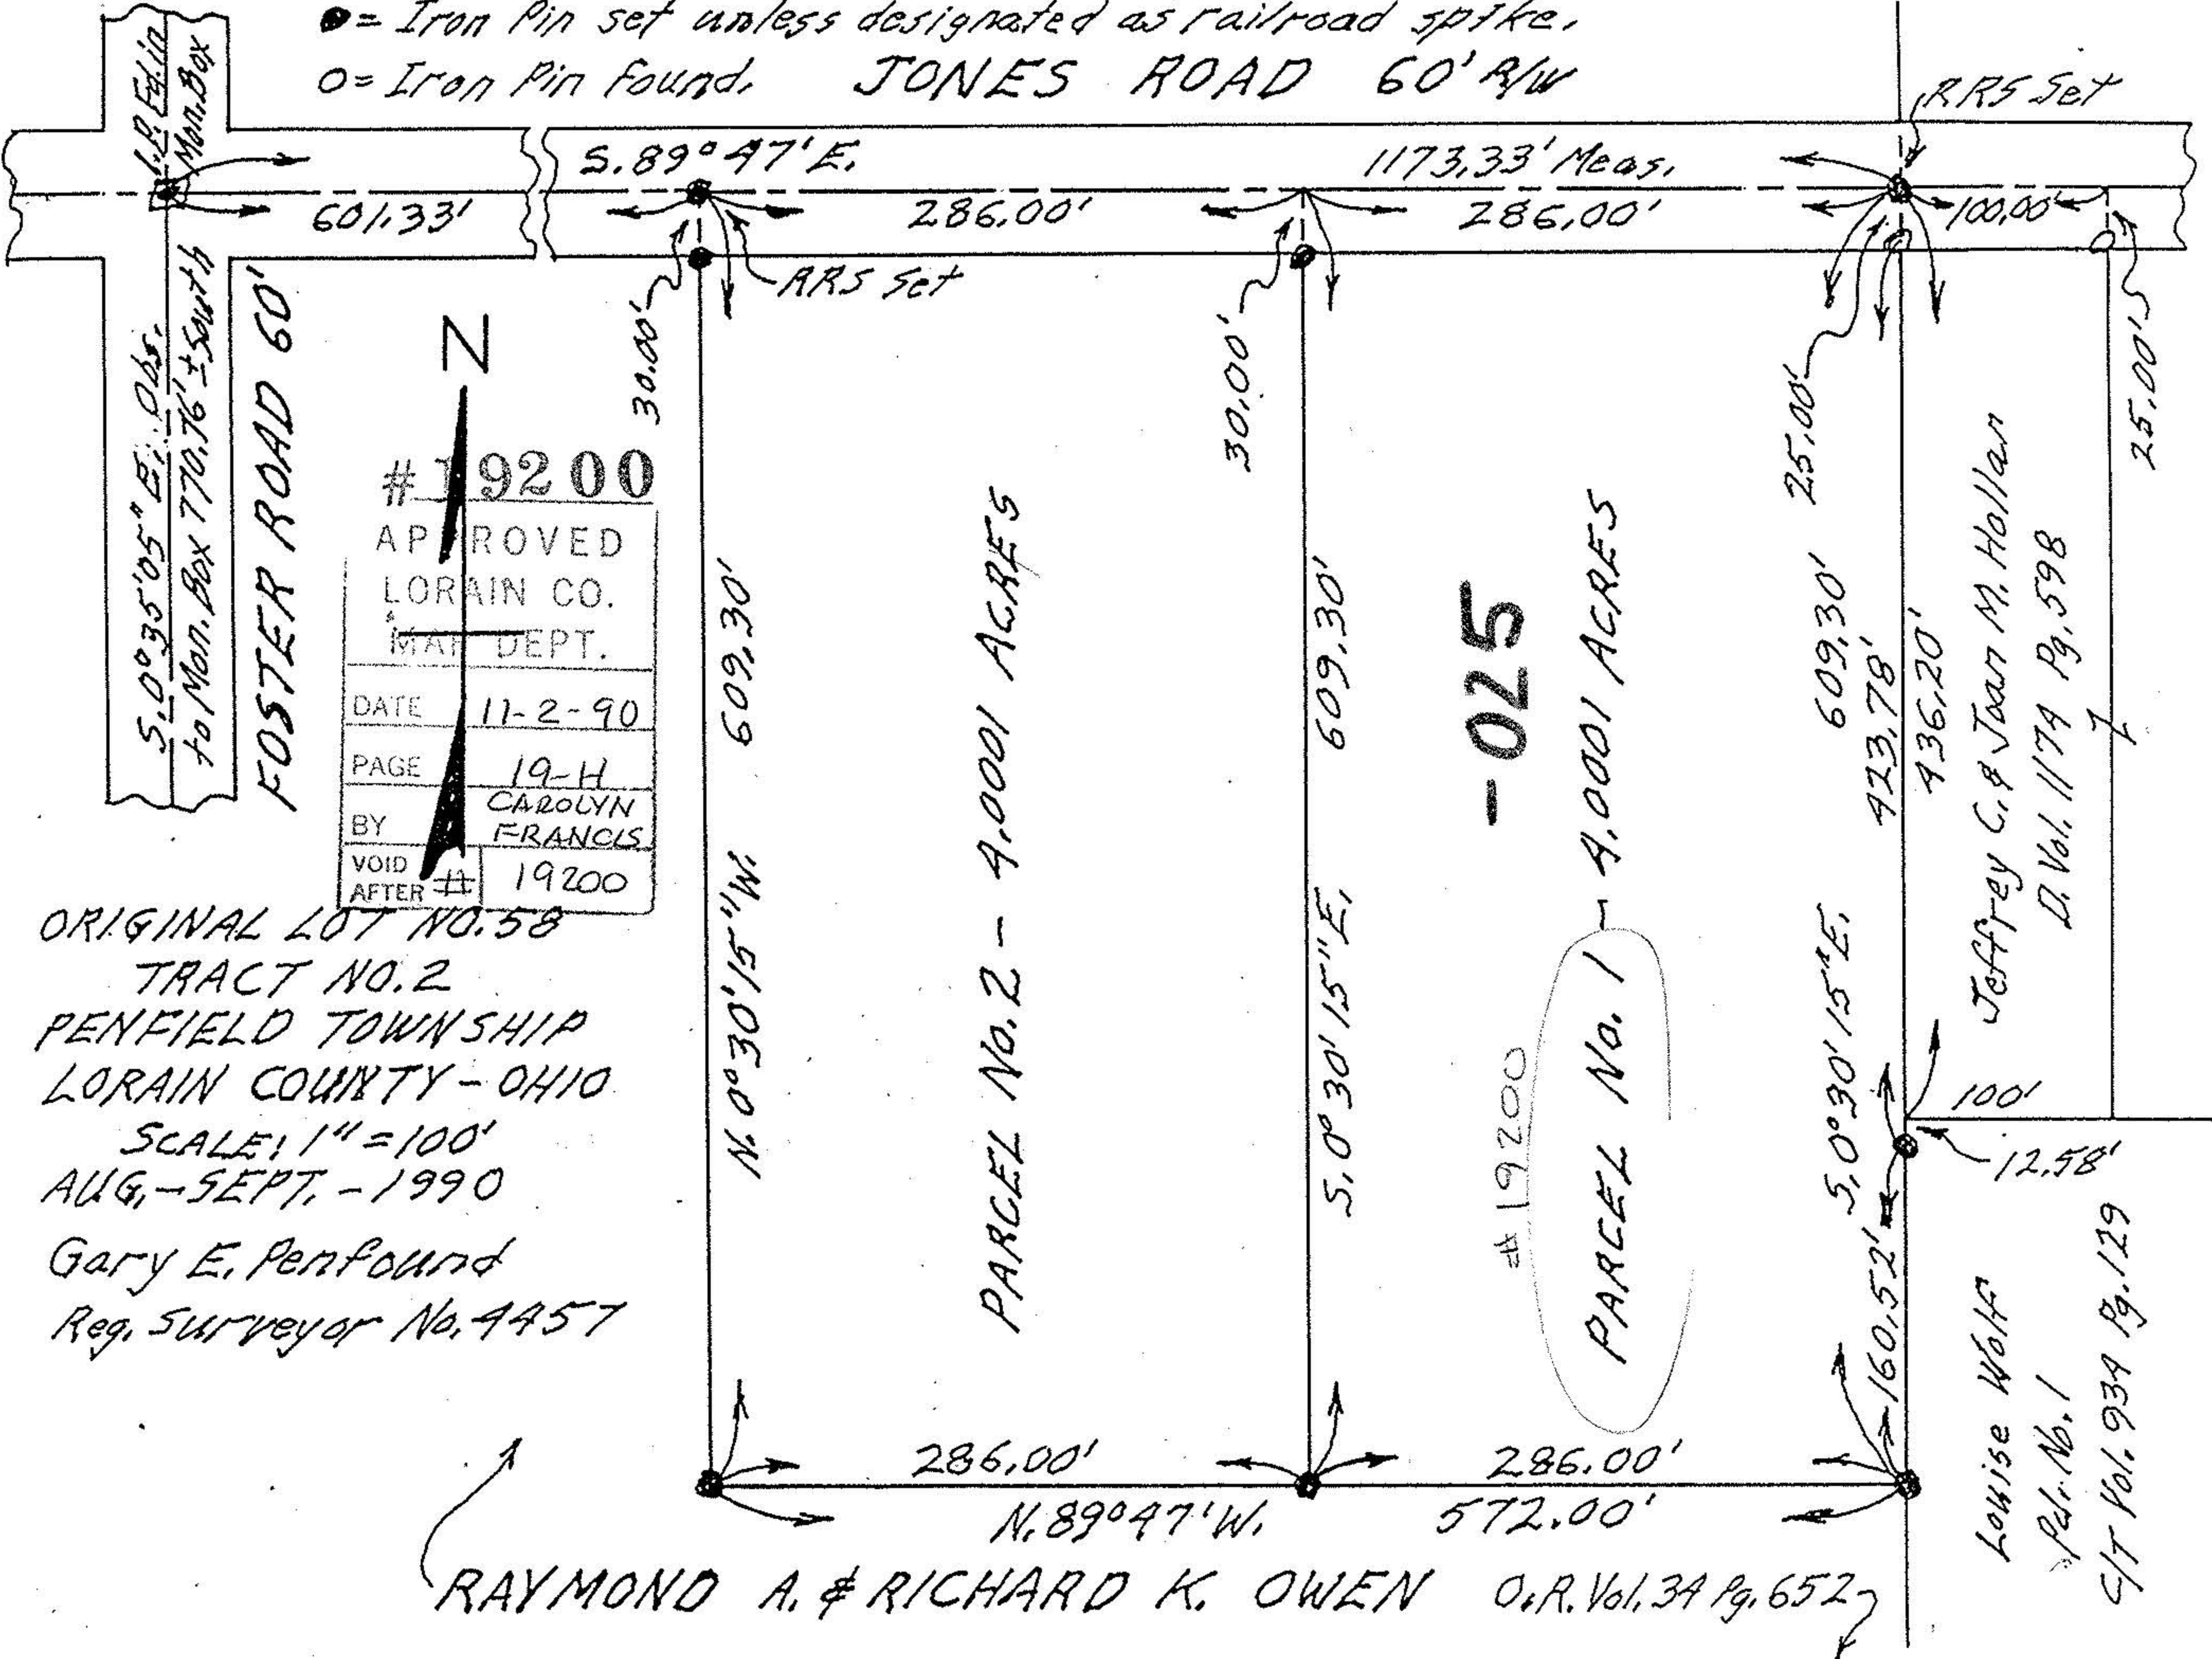

RAYMOND A. & RICHARD K. OWEN O.R. Vol. 34 Pg. 652

Jeffrey C. & Joan M. Hollan
 D. Vol. 1174 Pg. 598

Louise Wolf
 Pdr. No. 1
 C/T Vol. 934 Pg. 129