Survey of Parcel Splits for Jerry Swaggerty
Part of Original Lot 30 Tract 2.
Penfield Township Lorain County Ohio
Scale 1" = 100' Oct 1992

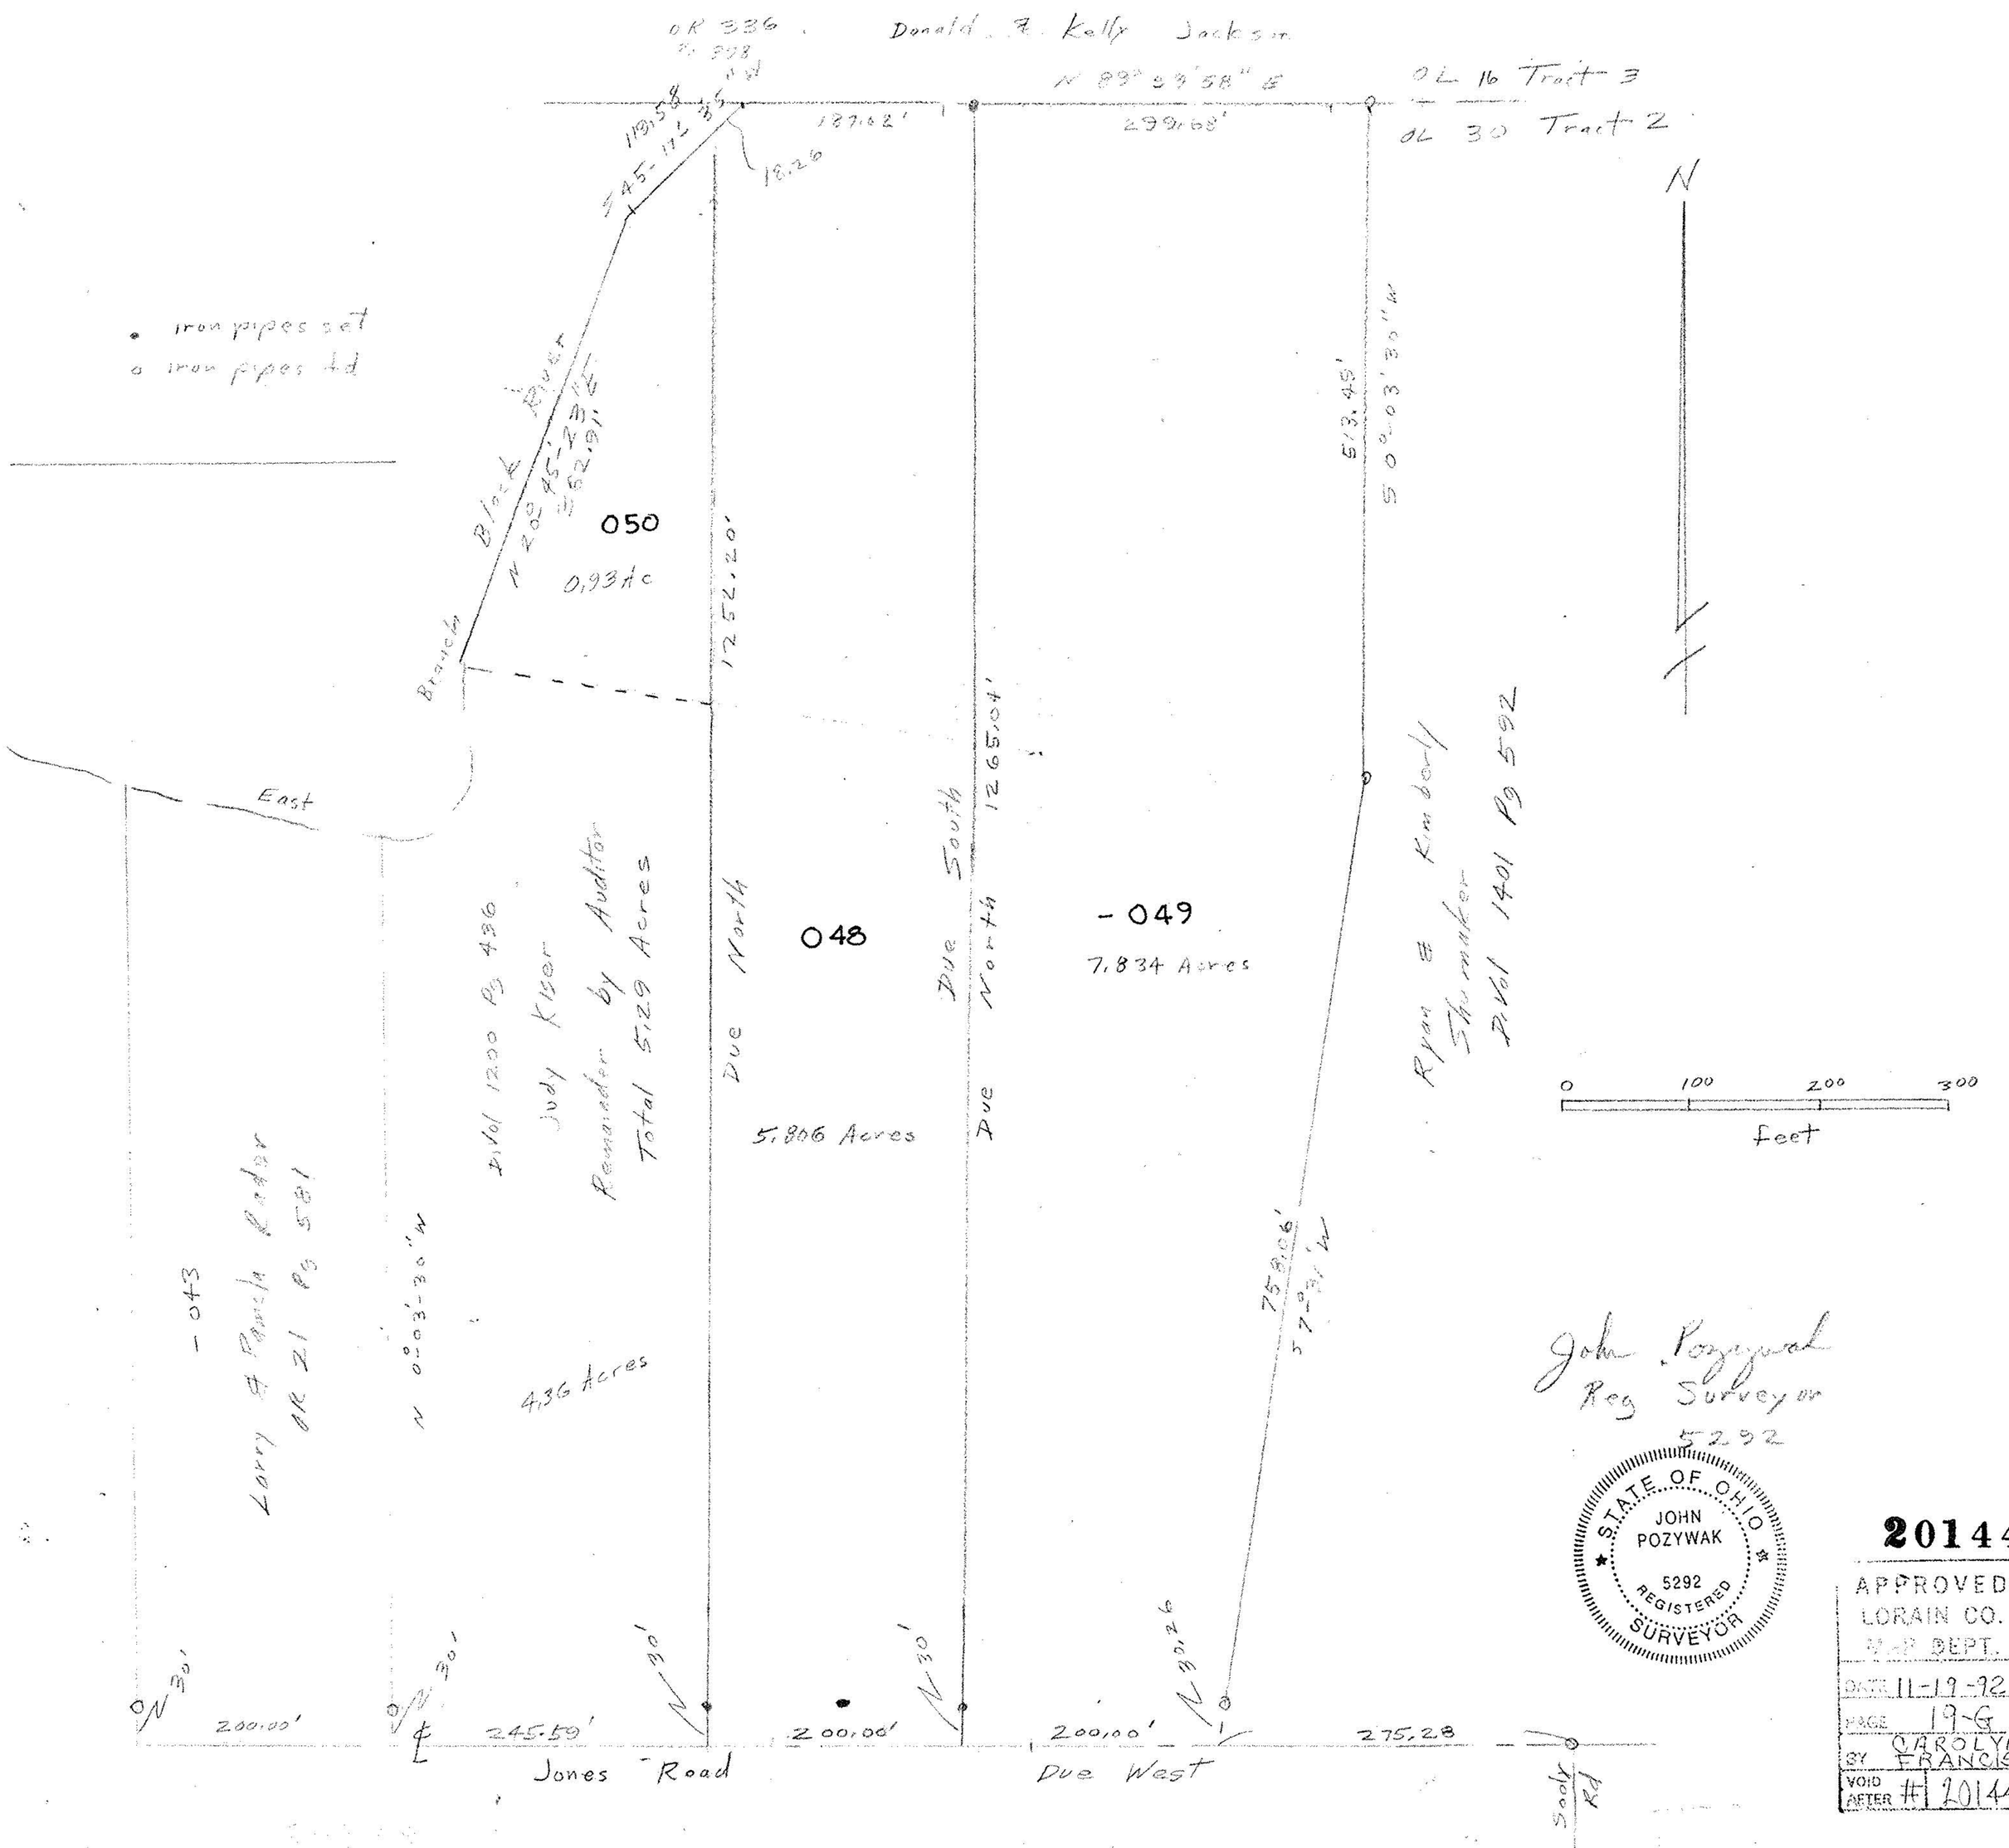

John Pozywak
Reg Surveyor
5292

STATE OF OHIO
JOHN POZYWAK
5292
REGISTERED SURVEYOR

20144

APPROVED
LORAIN CO.
P & Z DEPT.
DATE 11-19-92
PAGE 19-G
BY CAROLYN FRANCIS
VOID AFTER # 20144