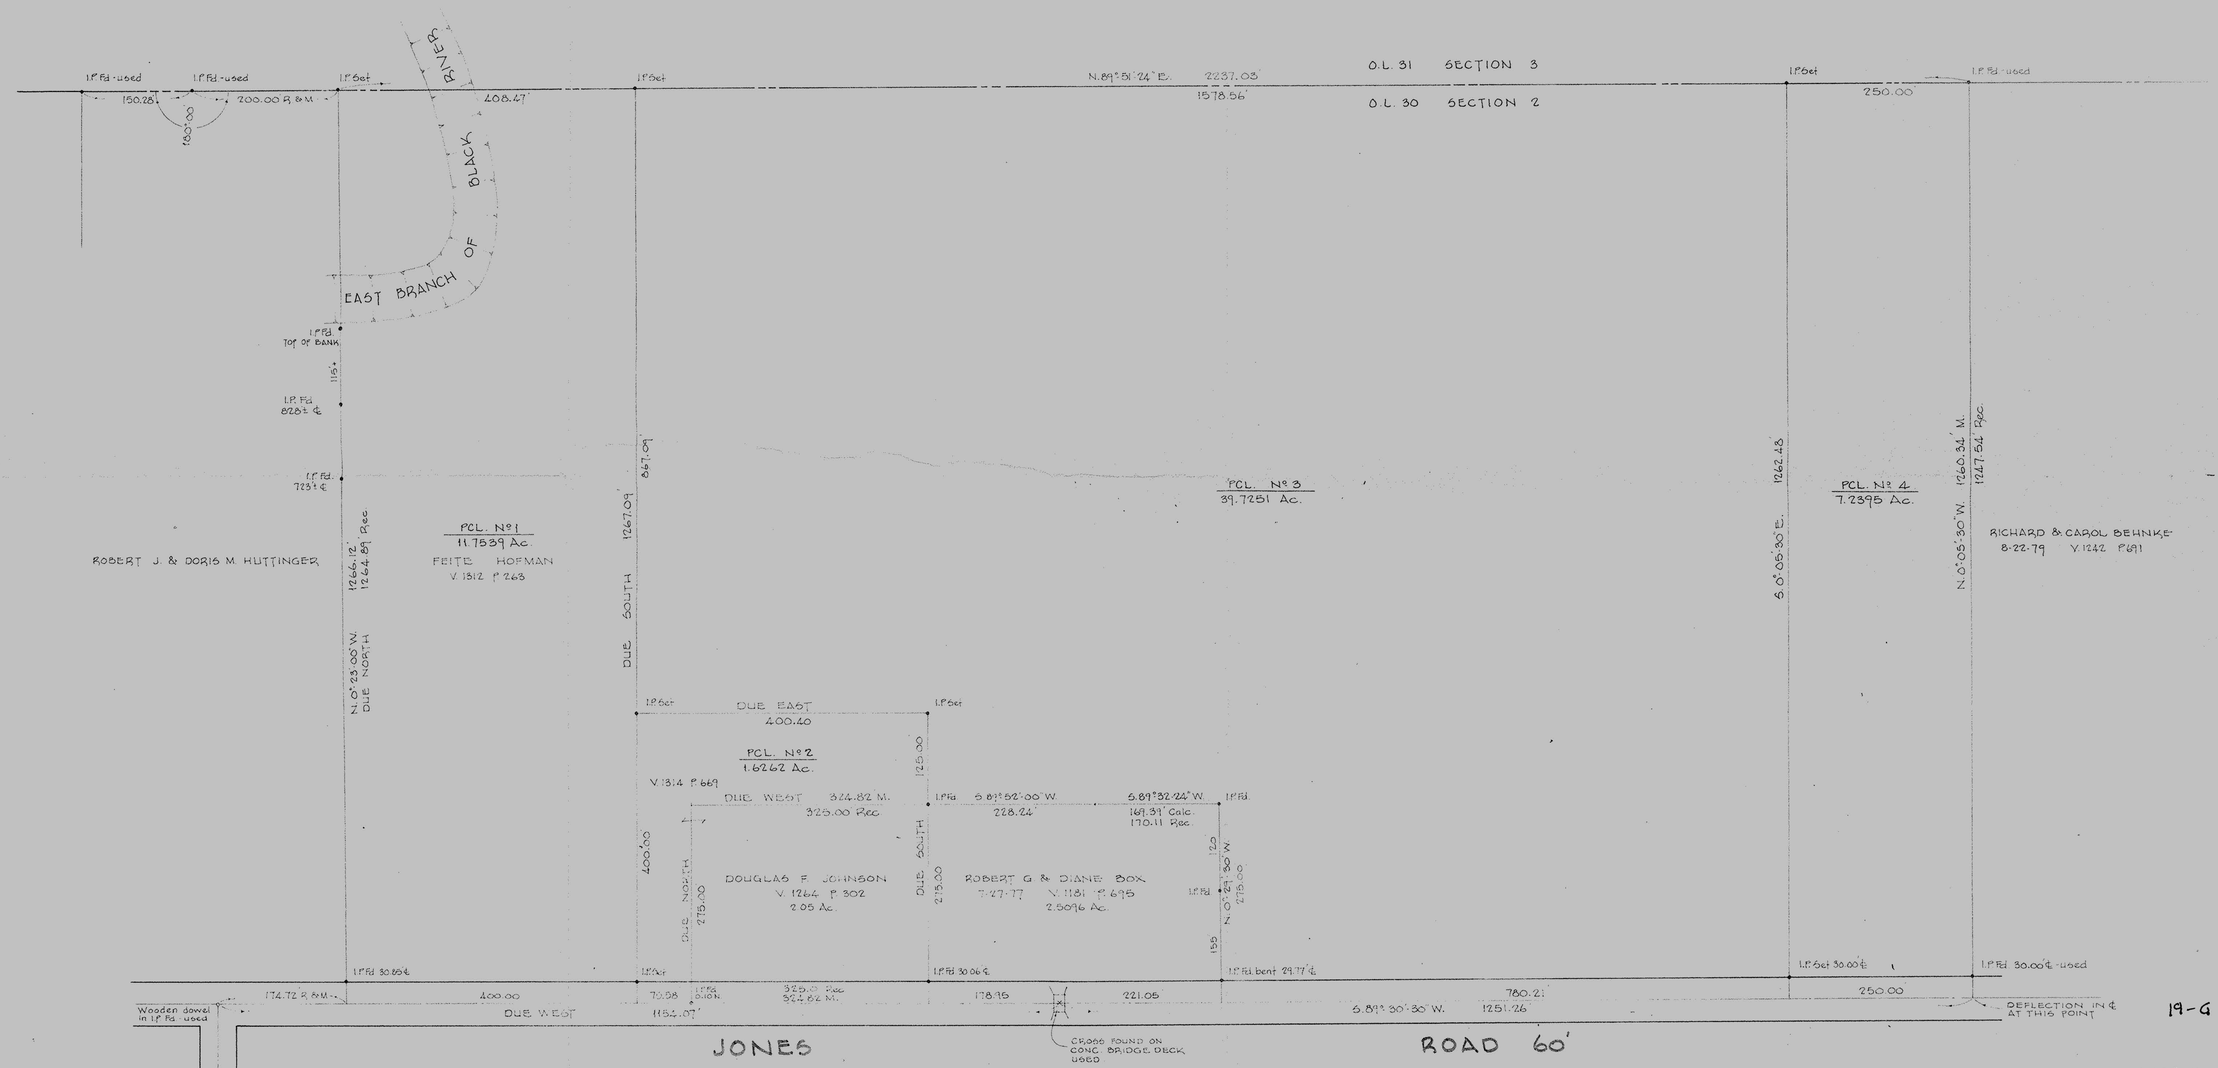

19-G 19-02-030-000-041
-042

SURVEY FOR

HAZEL ANDREWS

PART OF SEC. 2 ORIG. LOT 30 PENFIELD TWP.
LORAIN COUNTY OHIO
SCALE 1"=100' MAY, 1983

LAUNDON • SIMON • CAHL & ASSOC.
ENGINEERS SURVEYORS
JOB Nº 83-1187 F.B. 176 P. 29

163