C/B LES DRNGL/DLLTND

LAUNDON ⊕ SIMON ⊕ CAHL & ASSOC., INC.
CONSULTING ENGINEERS & SURVEYORS
1106 MIDDLE AVE., ELYRIA, O. 44035

PARCEL SPLIT FOR:
RAYMOND A. OWEN

Orig. Lot 29 & 30	City of	Date SEPT. '92 Scale 1"=200'
Orig. Sec	Village of	Dwn. by R.G.S. Chkd. by R.C.
Tract 2	County of LORAIN	Job No. 92-2246 F.B.
Township of PENFIELD	State of OHIO	Printed

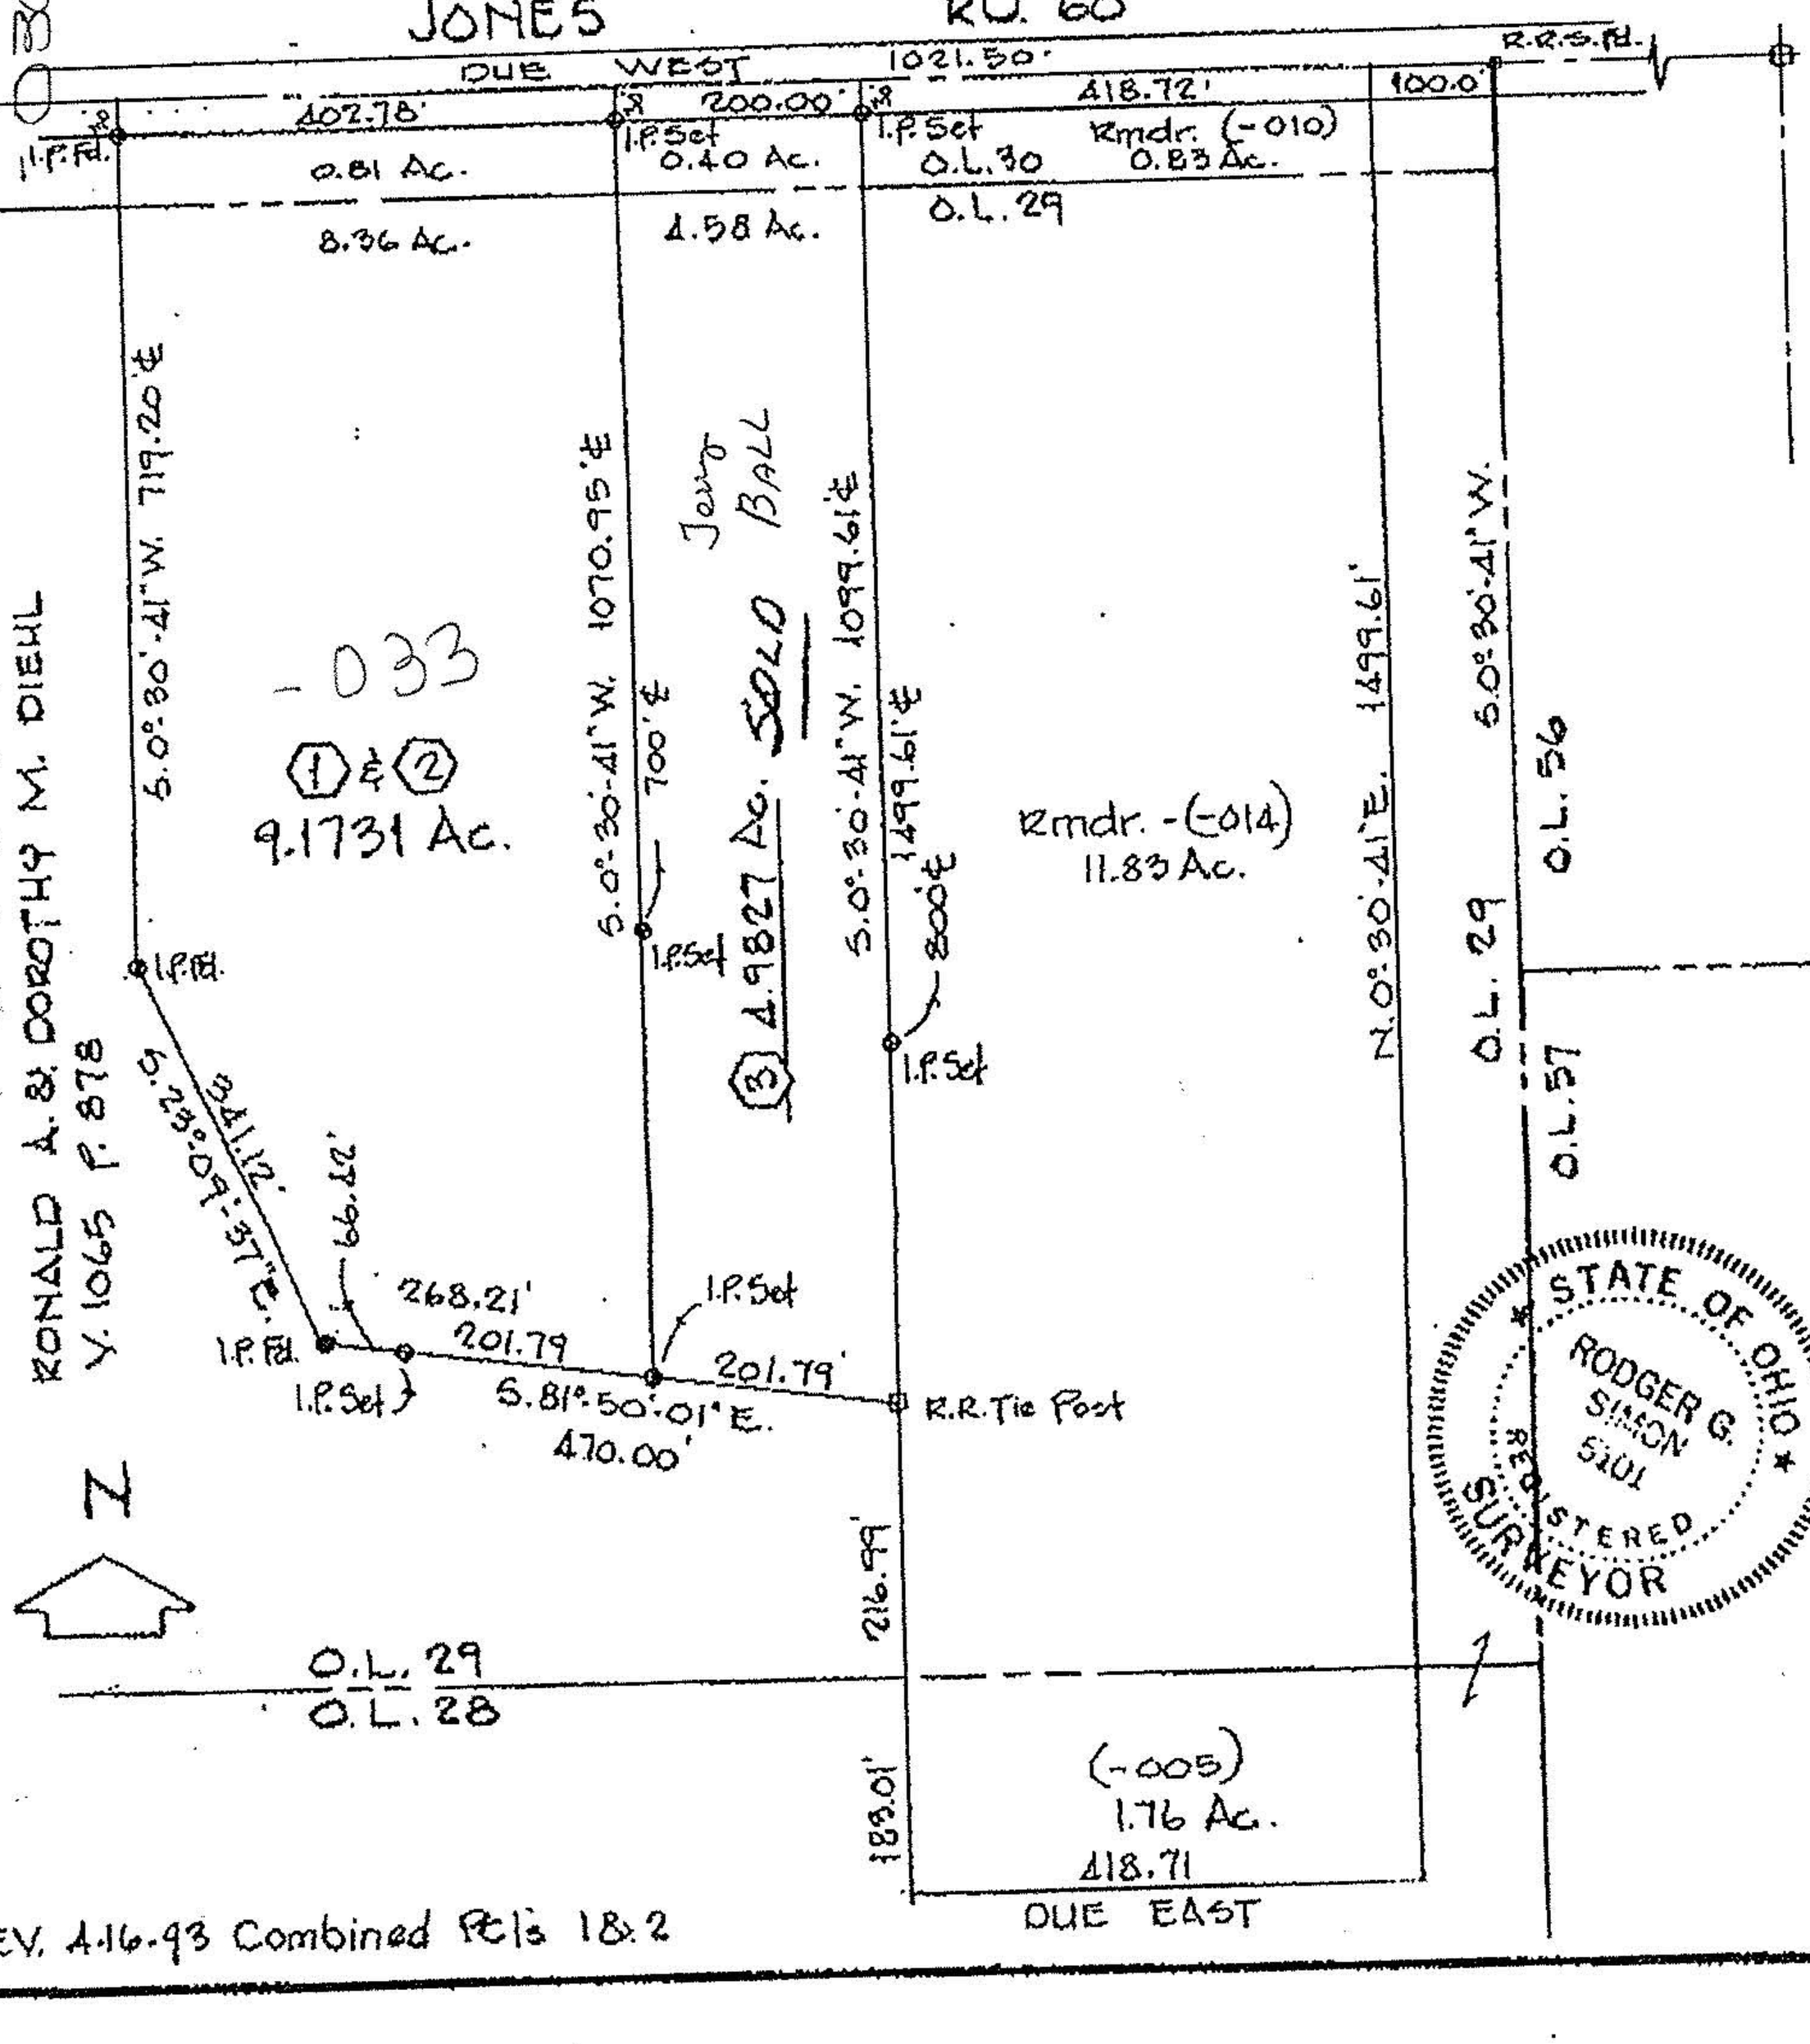

REV. 4-16-93 Combined Pcls 1 & 2