LAUNDON • SIMON • CAHL & ASSOC., INC.
CONSULTING ENGINEERS & SURVEYORS
110 MIDDLE AVE., ELYRIA, O. 44035

SURVEY FOR:
JAMES L. & LIDA J. KNAPP

Orig. Lot 5	City of	Date OCT. '92 Scale 1"=200'
Orig. Sec 3	Village of	Dwn. by R.G.S. Chkd. by R.C.
Tract	County of LORAIN	Job No. 92-2231 F.B. 226/45
Township of PENFIELD	State of OHIO	Printed OCT 2 1 1992
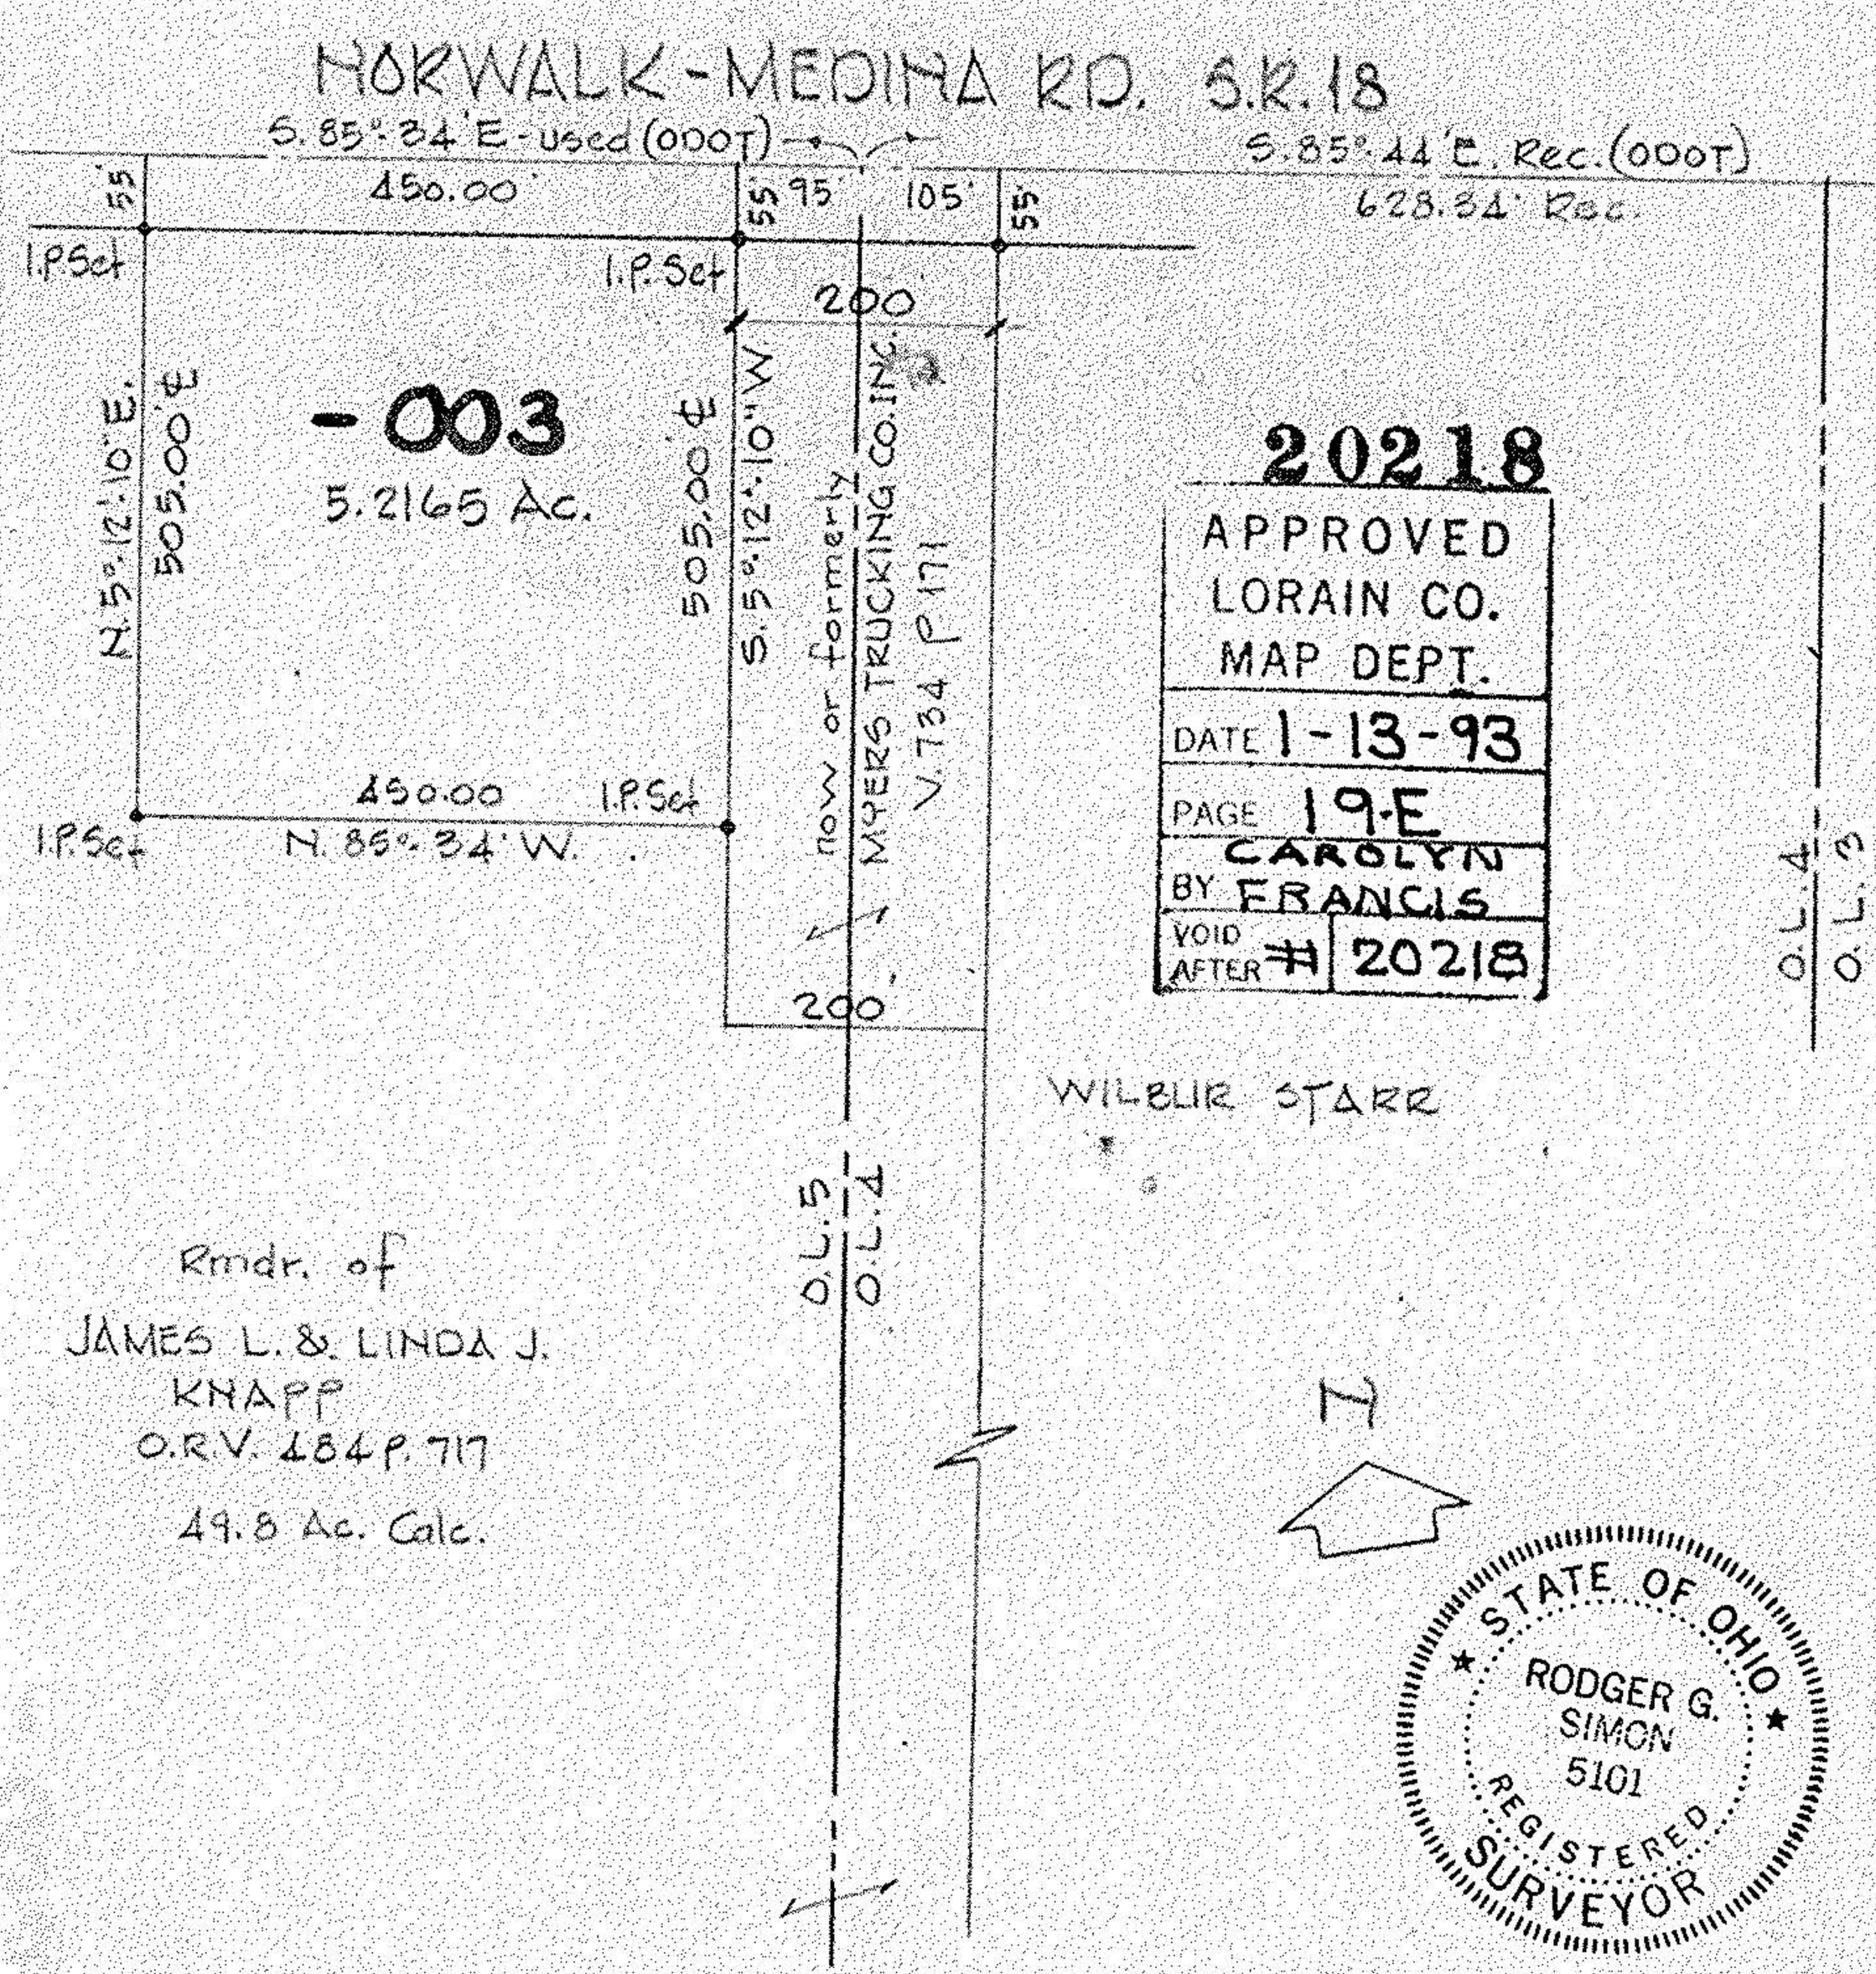
NOTE: AFTER A DILIGENT & REPEATED EFFORT TO RECOVER THE ℄ REF. MONUMENTS AS APPEAR ON ODOT'S ℄ SURVEY FOR S.R.18 IN PLAT VOL. 19 PG. 13 FAILED, THE ℄ OF EXIST. PAV'T. WAS USED FOR SURVEY.