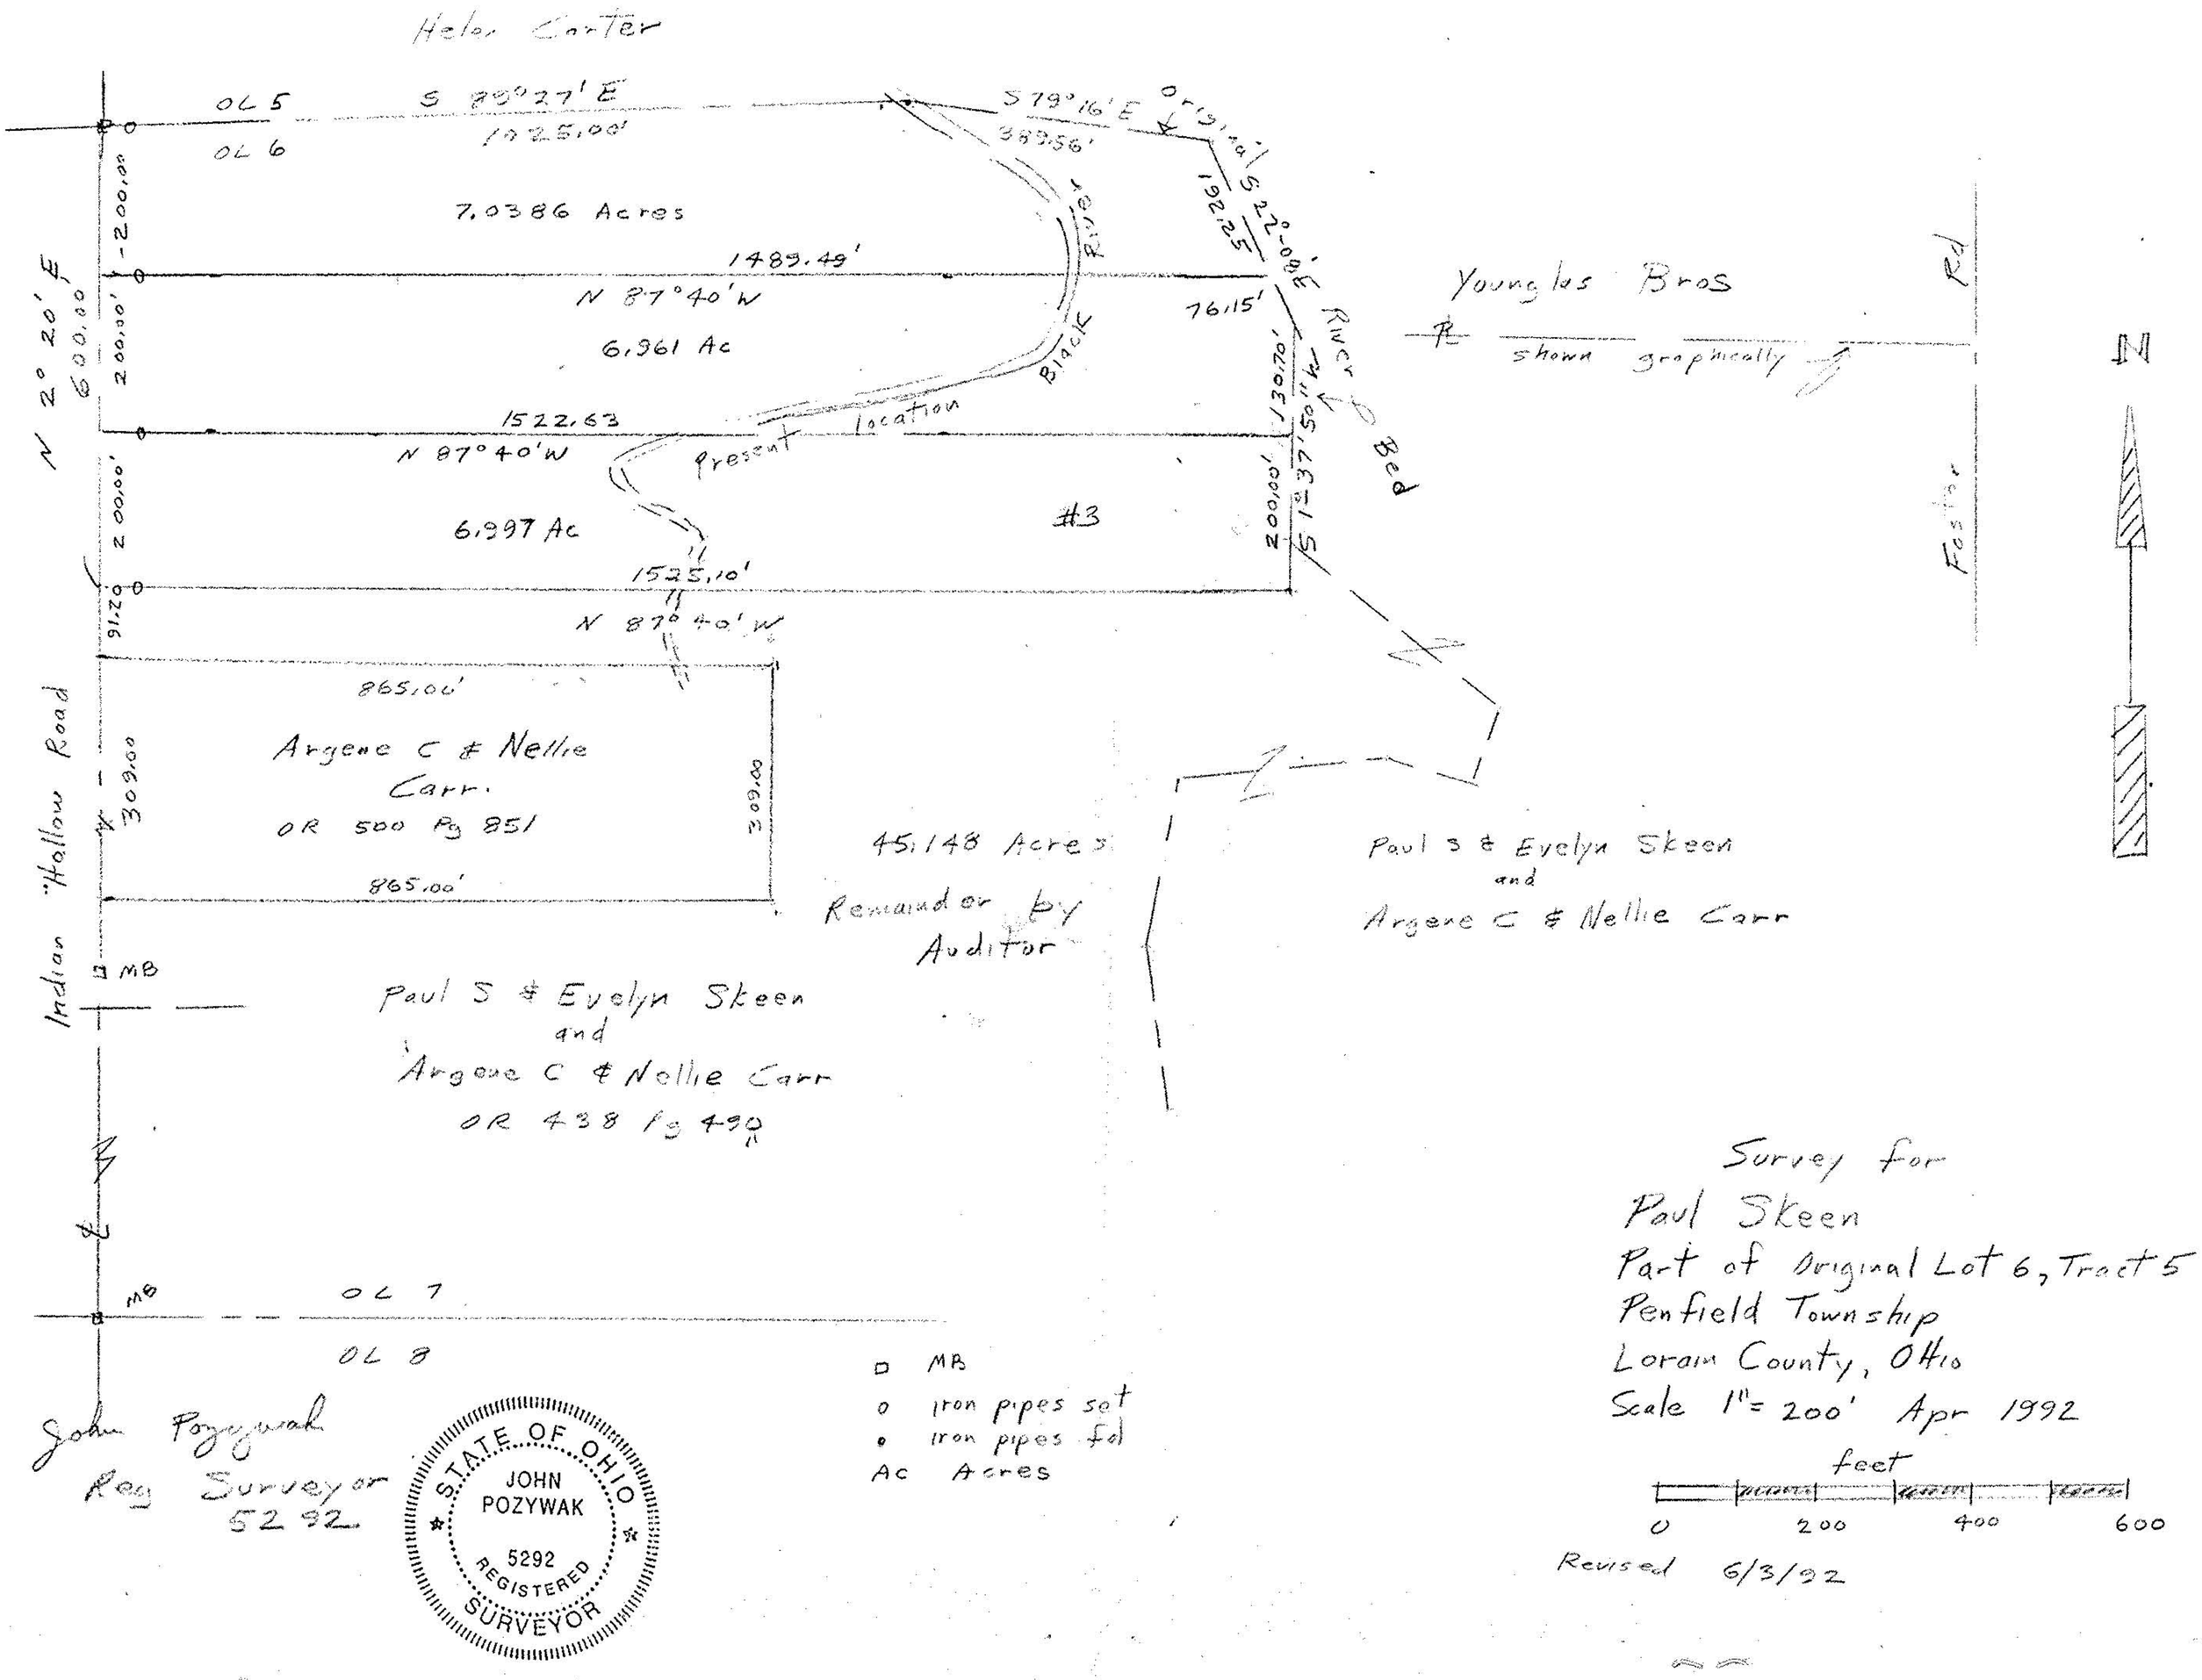

Survey for
Paul Skeen
Part of Original Lot 6, Tract 5
Penfield Township
Lorain County, Ohio
Scale 1" = 200' Apr 1992

Revised 6/3/92