19-B

13960

19-06-111-000-018

#13960

APPROVED
LORAIN CO.
MAP DEPT.
DATE 12-05-80
PAGE 19-B
BY Carolyn
VOID AFTER 13960

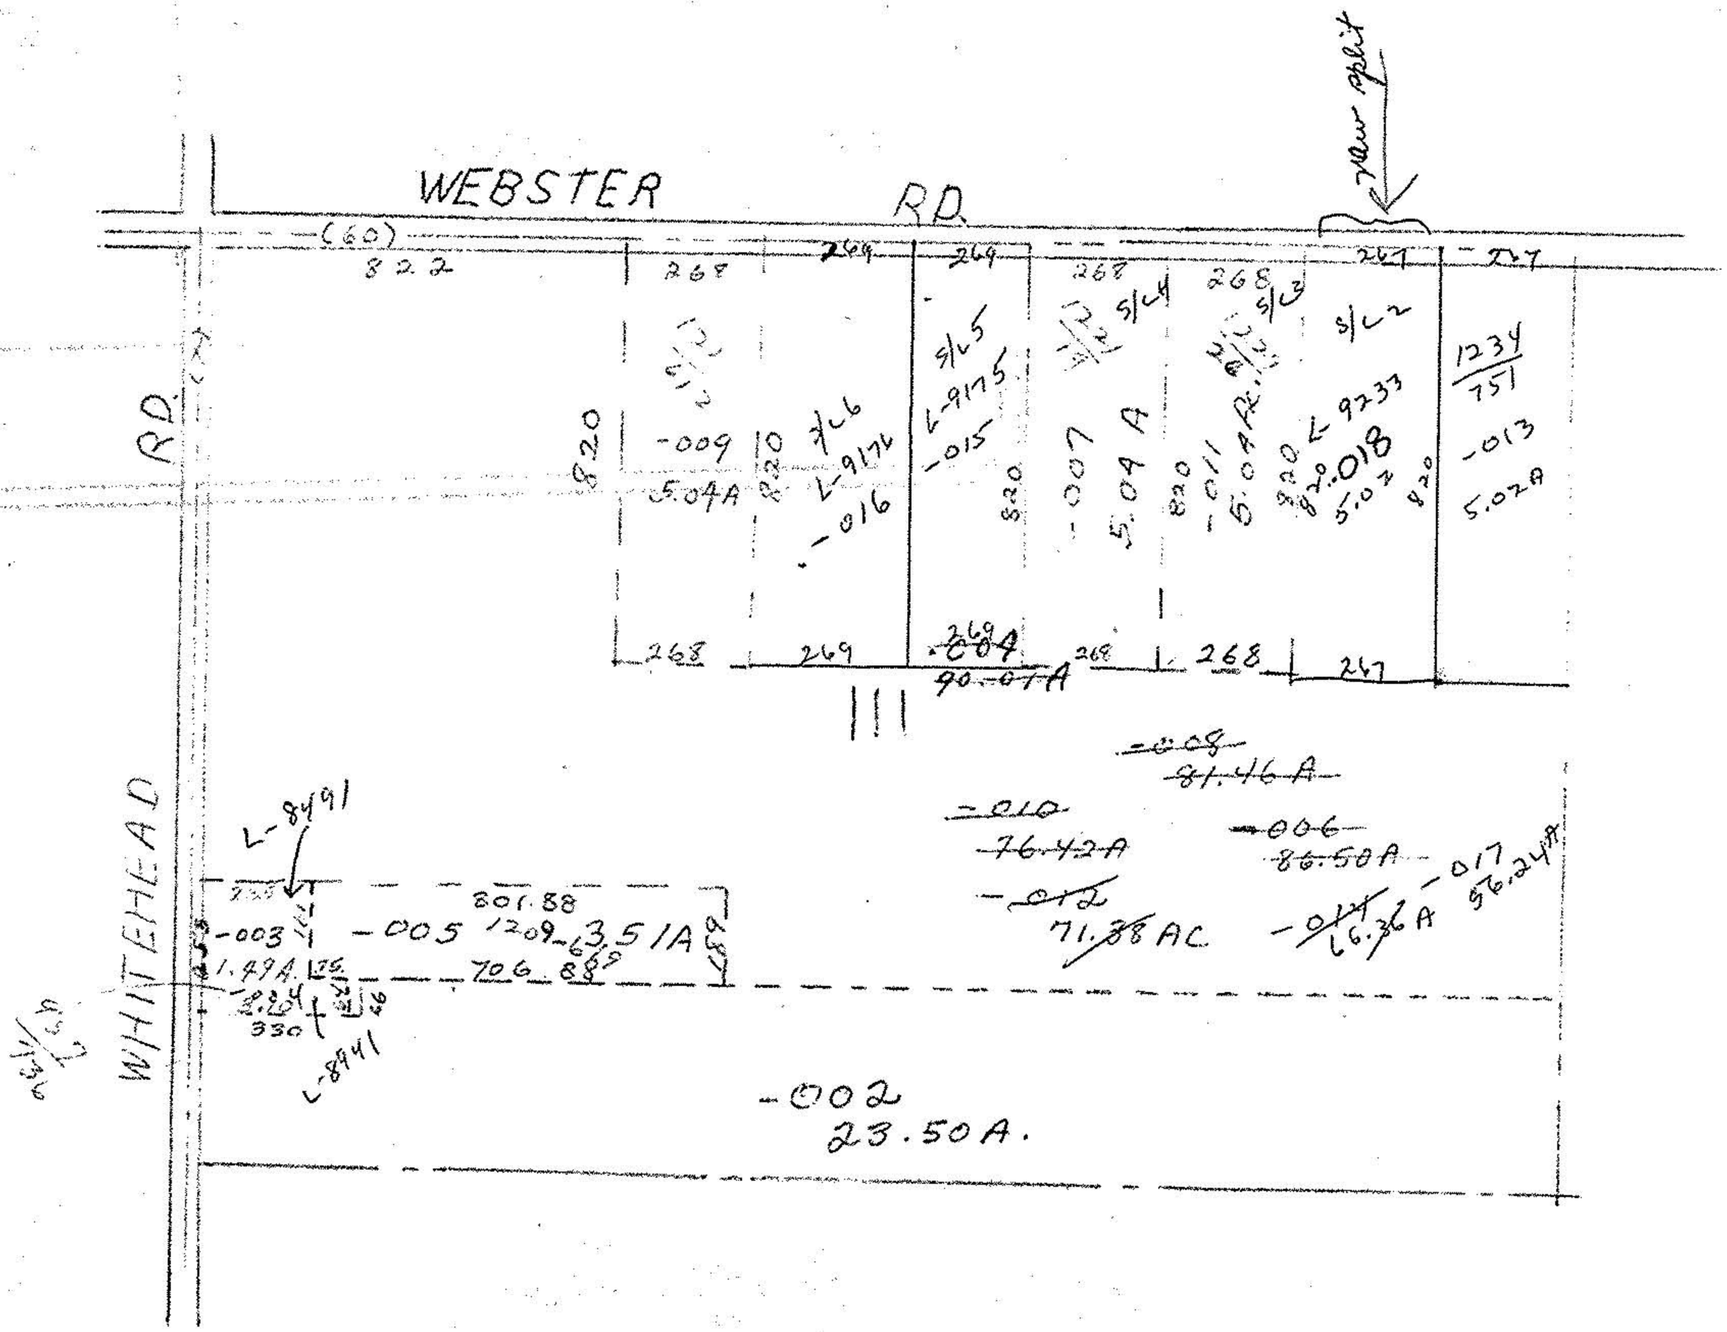

TRACT 6

19-B