19-B

13960

19-06-111-000-018

#13960

APPROVED LORAIN CO. MAP DEPT.	
DATE	12-05-80
PAGE	19-B
BY	Carolyn
VOID AFTER	13960

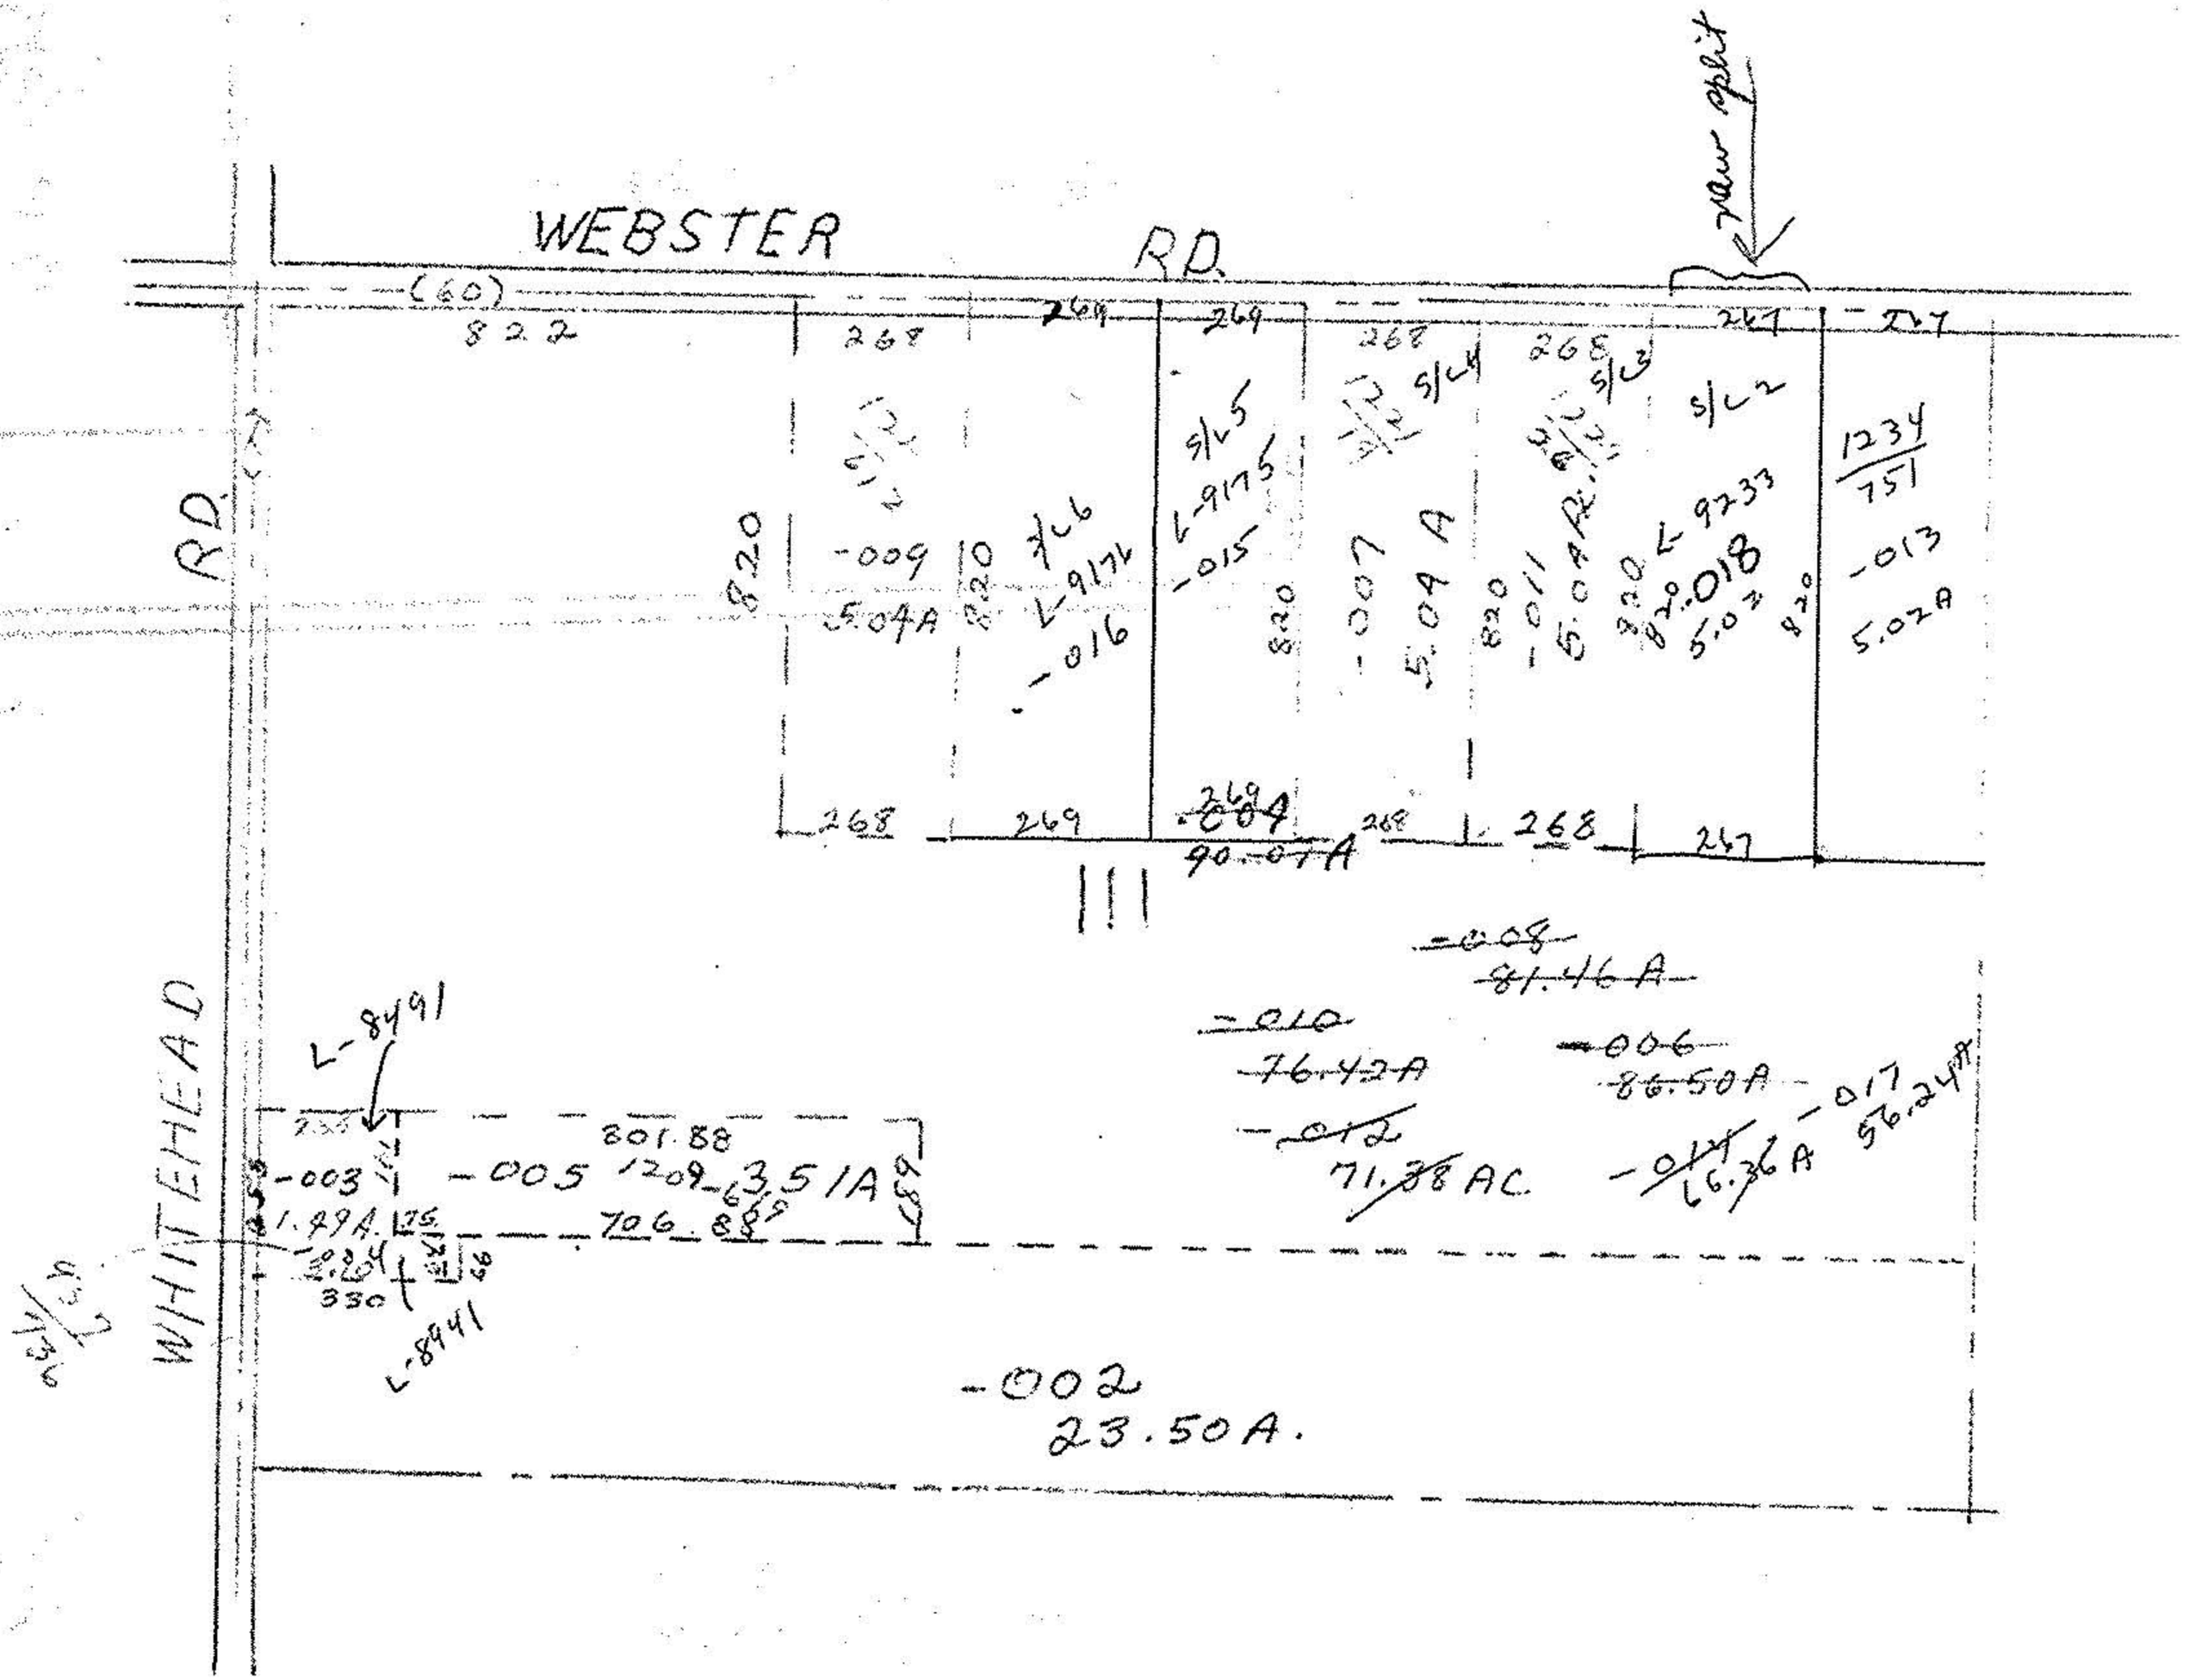

TRACT 6

19-B